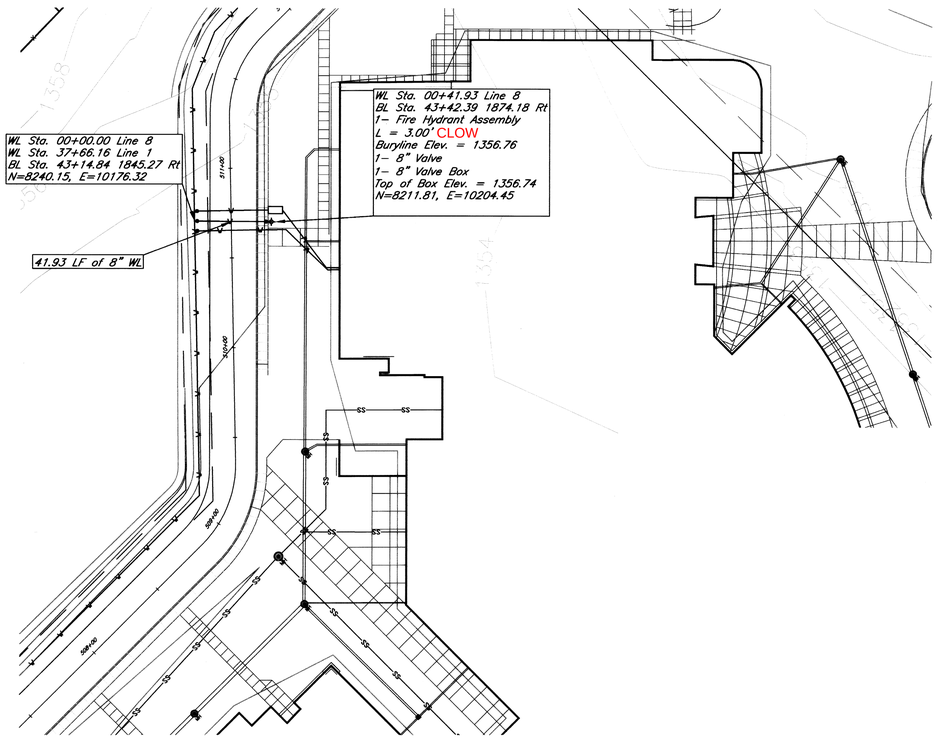

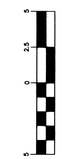

Vert. Scale
(IN FEET)
1 inch = 5 ft.

(IN FEET)
1 inch = 40 ft.

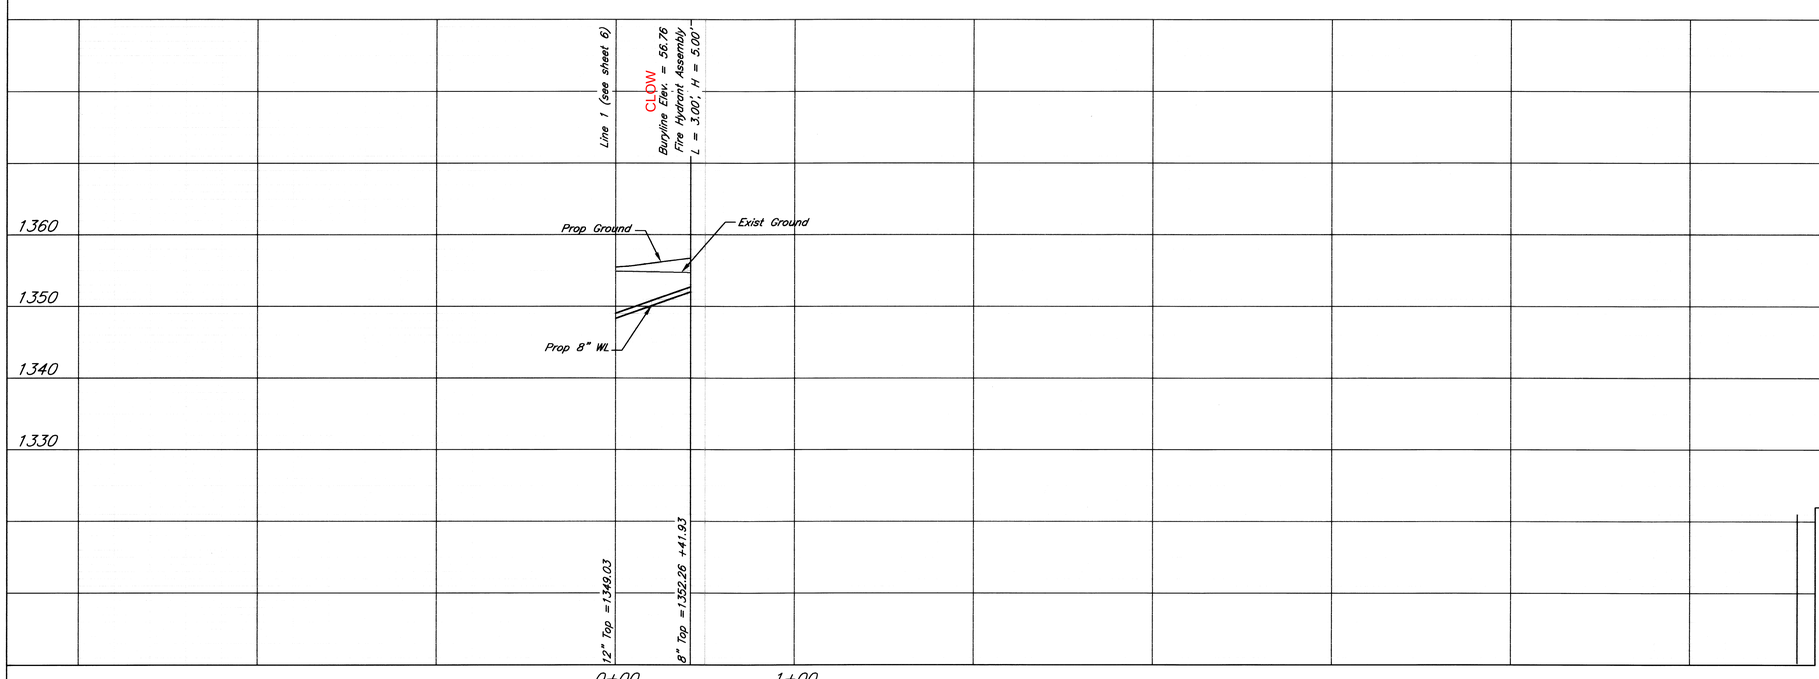

Maize School South Campus Addition

Line 8

Wichita, Kansas

kemiller engineering
516 S. Market,
Wichita, KS 67202
316/264-0242

PROJECT NUMBER

KEM NO.	FILE	DATE	SHEET
07081	ppw	2/2008	10
DESIGN	DRAWN	REVISED	OF
KM	NS		11