
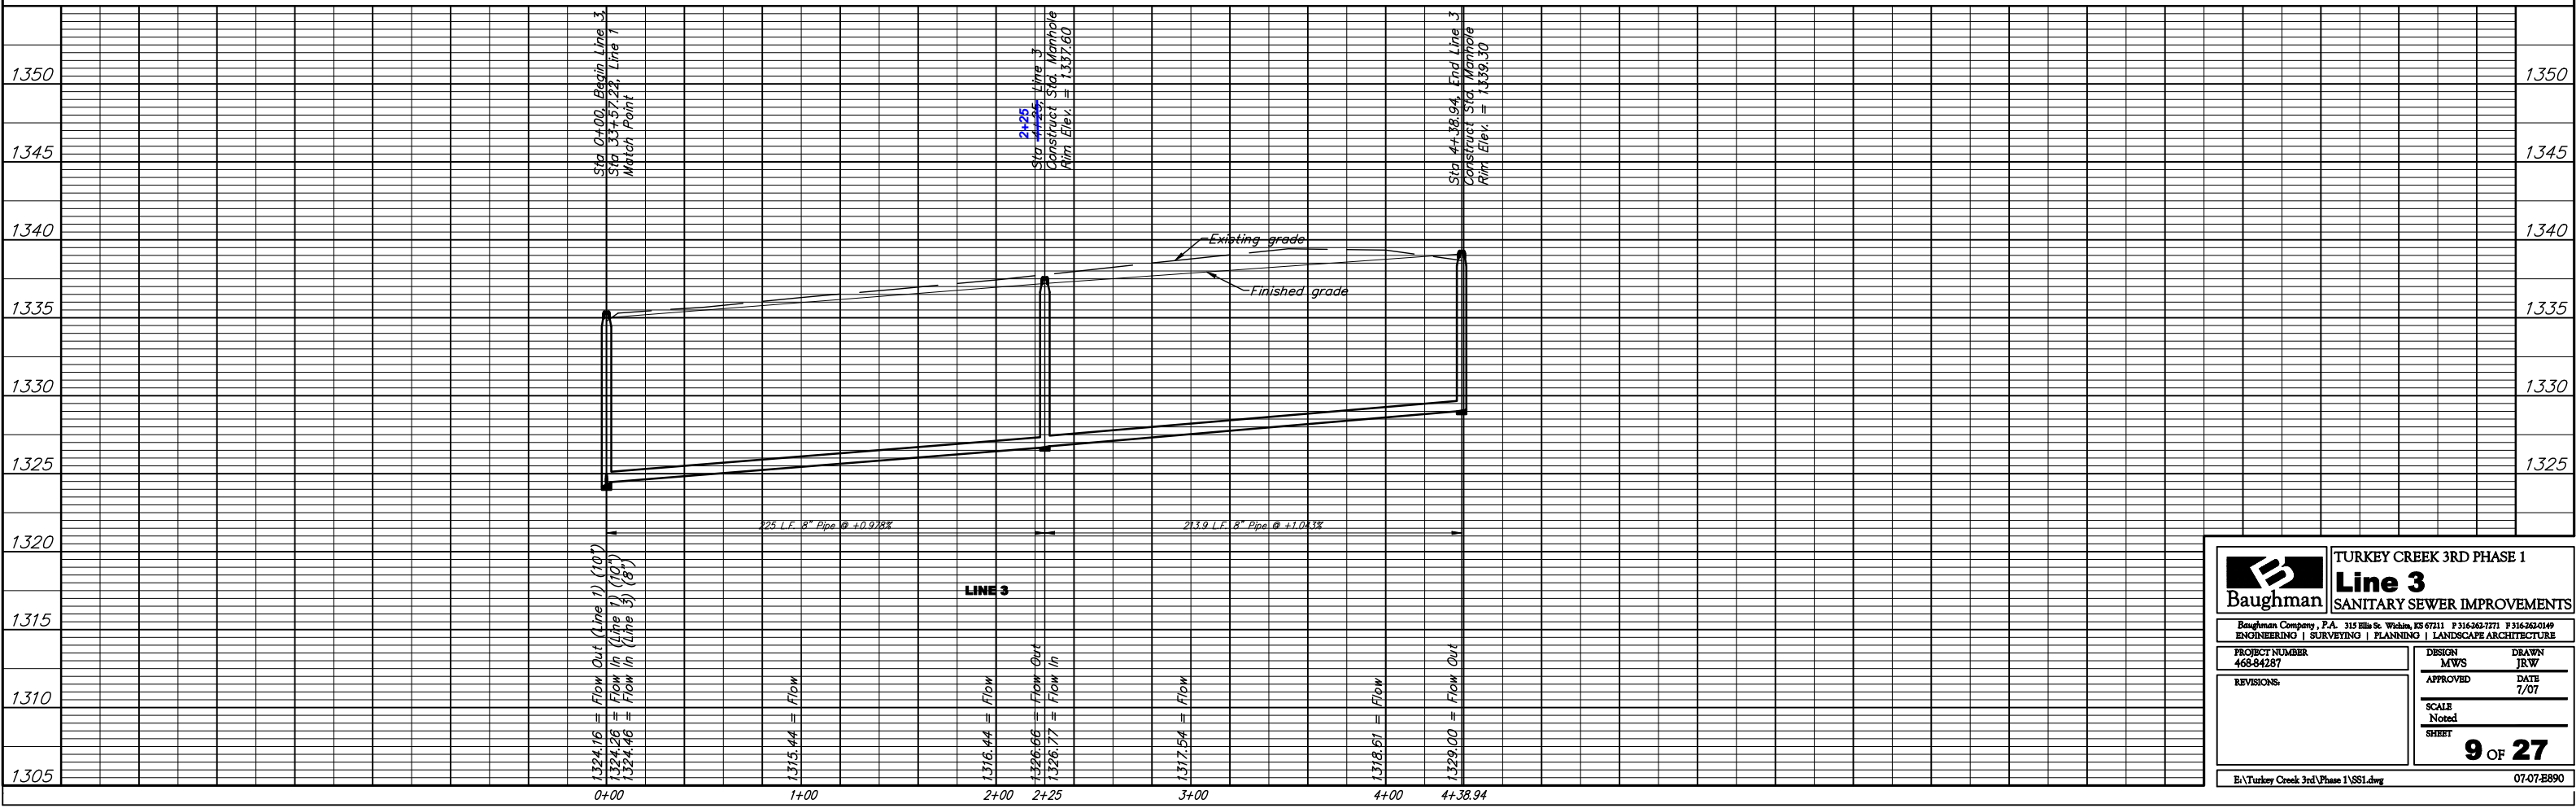


**BENCHMARKS:**

135th St. W. & Pawnee—  
City of Wichita Benchmark  
Disc on SW Corner of  
Concrete Base of High Line  
Pole.  
Elev. = 1359.65 NGVD29

119th St. W. & Pawnee—  
City of Wichita Benchmark  
Disc 0.5 miles S of Kellogg.  
42.2' E of centerline & 6.4"  
S of Power Pole.  
Elev. = 1332.09 MSL

Scale:  
1" = 40' Horizontal  
1" = 5' Vertical  
• = Iron

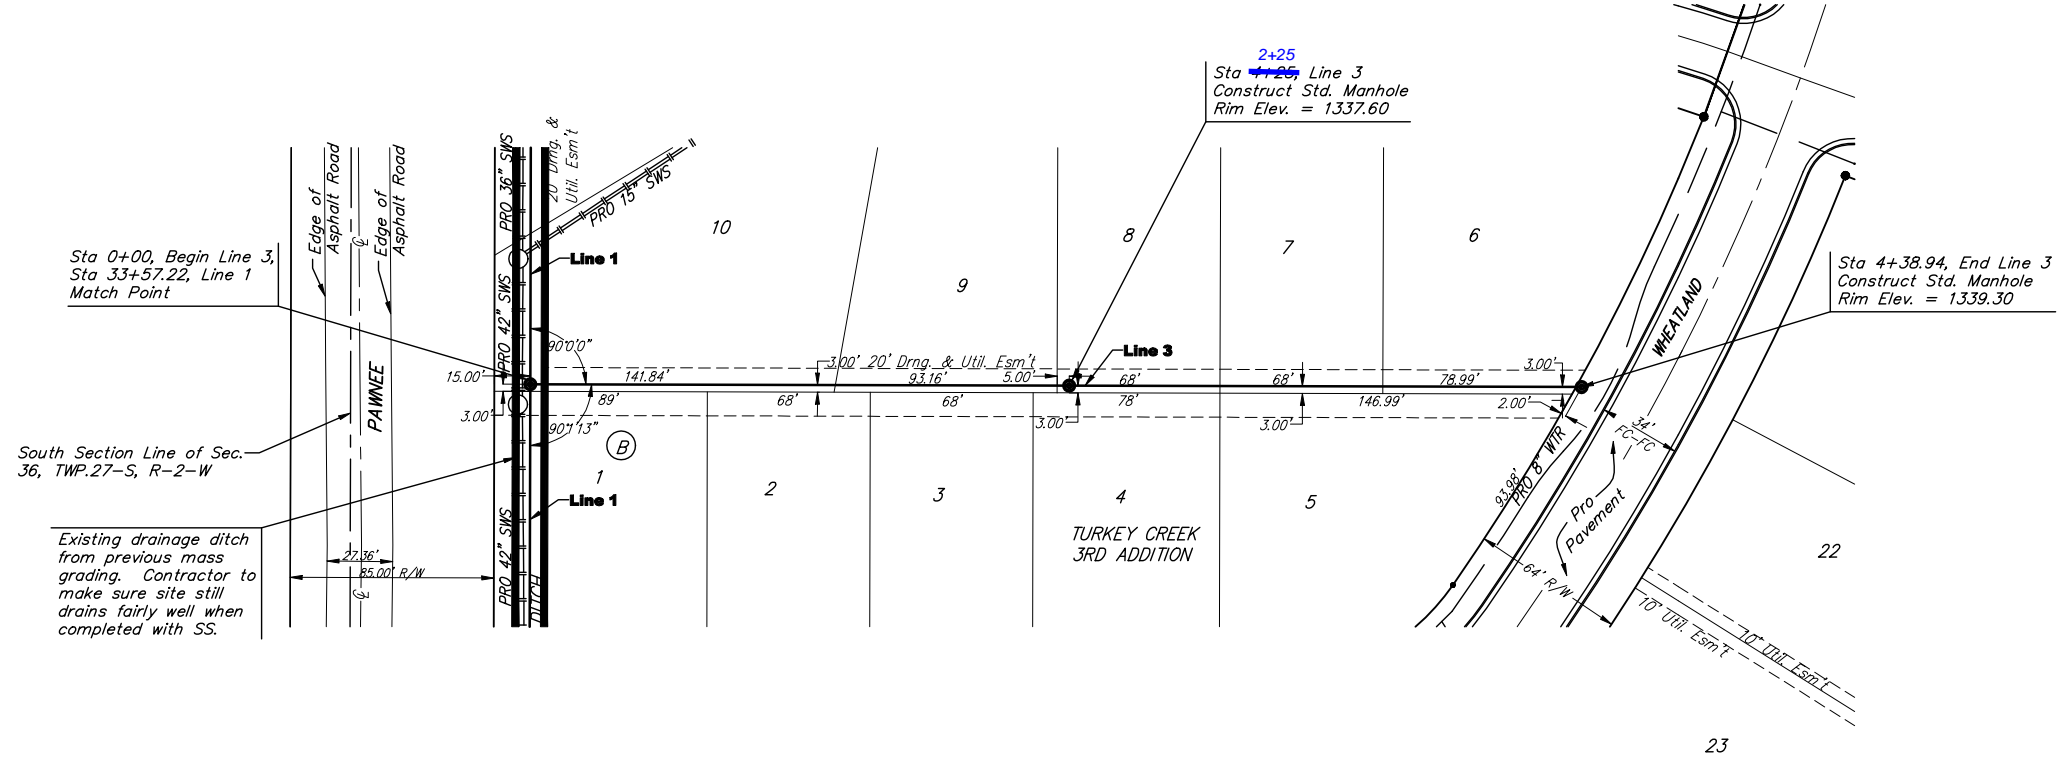

		TURKEY CREEK 3RD PHASE 1	
		<b>Line 3</b>	
ENGINEERING   SURVEYING   PLANNING   LANDSCAPE ARCHITECTURE		SANITARY SEWER IMPROVEMENTS	
<small>Baughman Company, P.A. 315 Ellis St. Wichita, KS 67211 P 316-262-7771 F 316-262-0149</small>			
PROJECT NUMBER 468-84287	DESIGN MWS	DRAWN JRW	APPROVED DATE 7/07
REVISIONS:	SCALE Noted SHEET		
	<b>9 OF 27</b>		
<small>Et:\Turkey Creek 3rd Phase 1\SS1.dwg</small>		<small>07-07-E890</small>	