GRAPHIC SCALE
(IN FEET) 1 INCH = 40 FT.
1 INCH = 5 FT. (Vert.)

Abandoned by Change Order

SS3 Sta. 0+00
ss2 Sta. 5+03.94
Connect To Proposed MH
Top MH Elev.=:1334.6
10330.50
20020.36

Remove 9 L.F. Asphalt Pavement

SS3 Sta. 0+60.22
SS3A Sta. 0+00
Const. Std. MH Type "P"
Top MH Elev.=:1334.5
10270.28
20020.31

CAUTION!!! Exist. 8" Sanitary Sewer To Be Abandoned

CAUTION!!! Overhead Power Line

Remove 26 L.F. Asphalt Pavement

Line No. 1

CAUTION!!! Underground Gas Line

Remove & Replace 36 L.F. Asphalt Pavement W/Curb & Gutter

SS3 Sta. 2+70.00
Const. Std. MH Type "P"
Top MH Elev.=:1333.7
10060.50
20020.15

CAUTION!!! Exist. 8" Waterline To Be Abandoned

Install 35 L.F. Flowable Fill To 2' Beyond Back of Curb

Line No. 2

CAUTION!!! Underground Gas Line

CAUTION!!! Overhead Power Line

CAUTION!!! Underground Phone Line

SS3 Sta. 3+21.06
Const. Std. Cleanout Assembly
Top CO Elev.=:1333.35
10084.61
19975.15

FIRST STREET

RUTAN AVE.

VICTOR PLACE

89°56'49"

N 15°15'35" W

60'

LINE NO. 3

CAUTION!!! Underground Gas Line

SS3A Sta. 0+00
SS3 Sta. 0+60.21
Const. Std. MH Type "P"
Top MH Elev.=:1334.47
10270.28
20020.31

Line No. 3

Remove & Replace 46 L.F. Existing Asphalt Pavement

N 12°20'06" W

CAUTION!!! Exist. 8" Waterline To Be Abandoned

CAUTION!!! Underground Gas Line

CAUTION!!! Underground Phone Line

SS3A Sta. 0+45
Const. Std. Cleanout Assembly
Top CO Elev.=1334.77
10270.33
19975.31

CAUTION!!! Overhead Power Line

Line No. 2

FIRST STREET

LINE NO. 3A

Note:
Contractor to Field Verify Location and Depth of All Utilities Prior to Construction and Report Findings Project Engineer

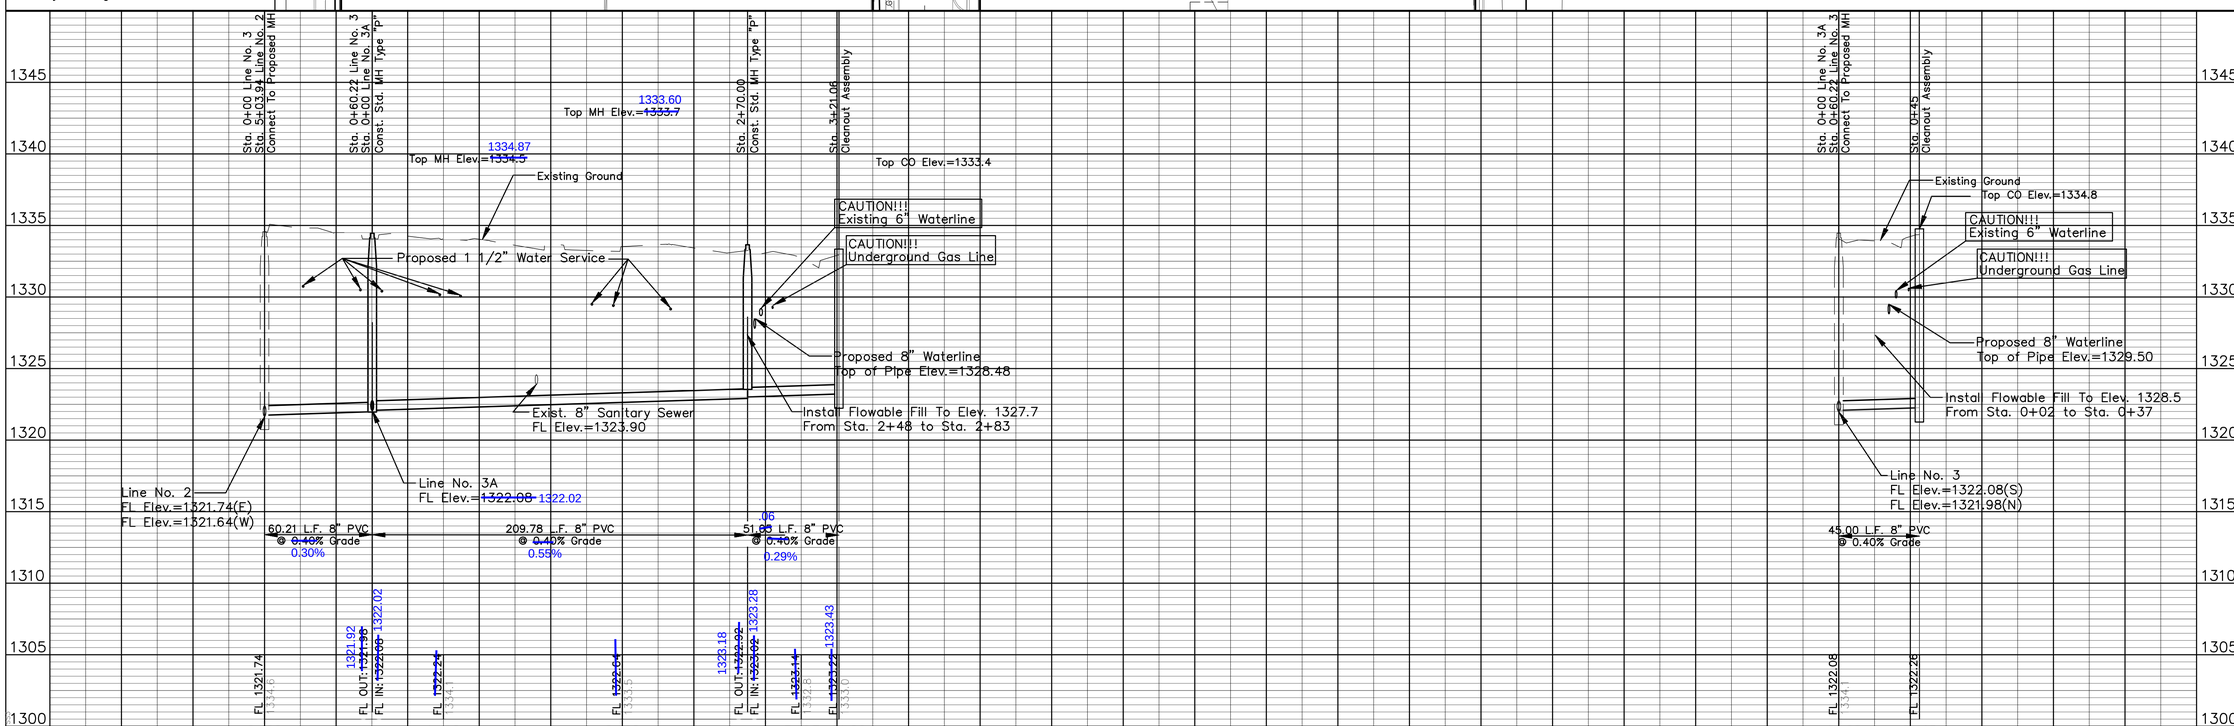

PARKSTONE ADDITION
RELOCATION OF PART OF DISTRICT B, SAN. SEWER # 12
SANITARY SEWER LINE NO. 3 & 3A
CITY OF WICHITA, KANSAS
JAMES L. ARMOUR, P.E. – CITY ENGINEER
Proj. No. 468-84376 O.C.A.# 744247

No.	Date	By	Approved	Revision

POE & ASSOCIATES, INC.
CONSULTING ENGINEERS
5940 E. Central, Suite 200 • Wichita, KS 67208-6242
Phone 316/685-4114 • FAX 316/685-4444

FINAL

Designed By: S. Schimdt
Drawn By: M. Tucker
Poe Job No.: 1879
Date: August 2007

Sheet 4 of 14