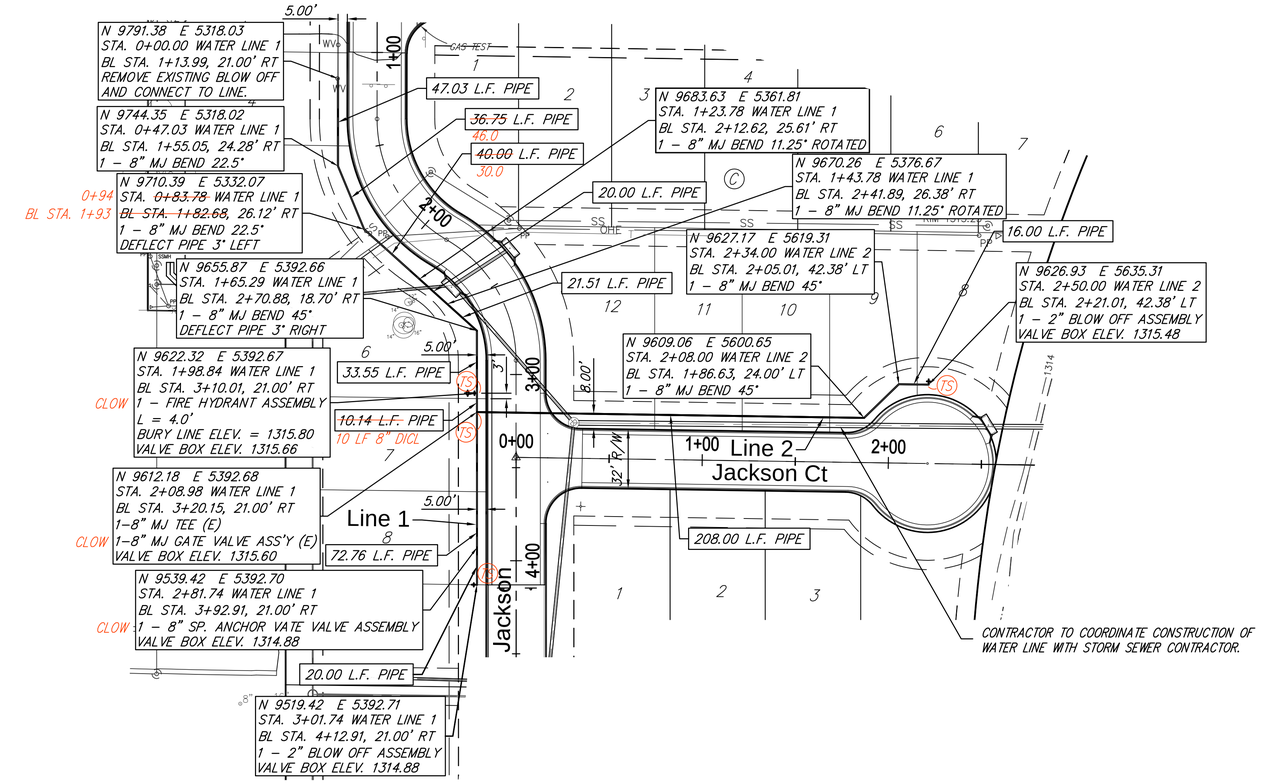


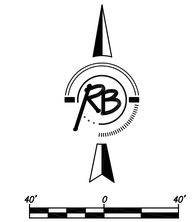


"AS-BUILT"
10/20/08
KWL

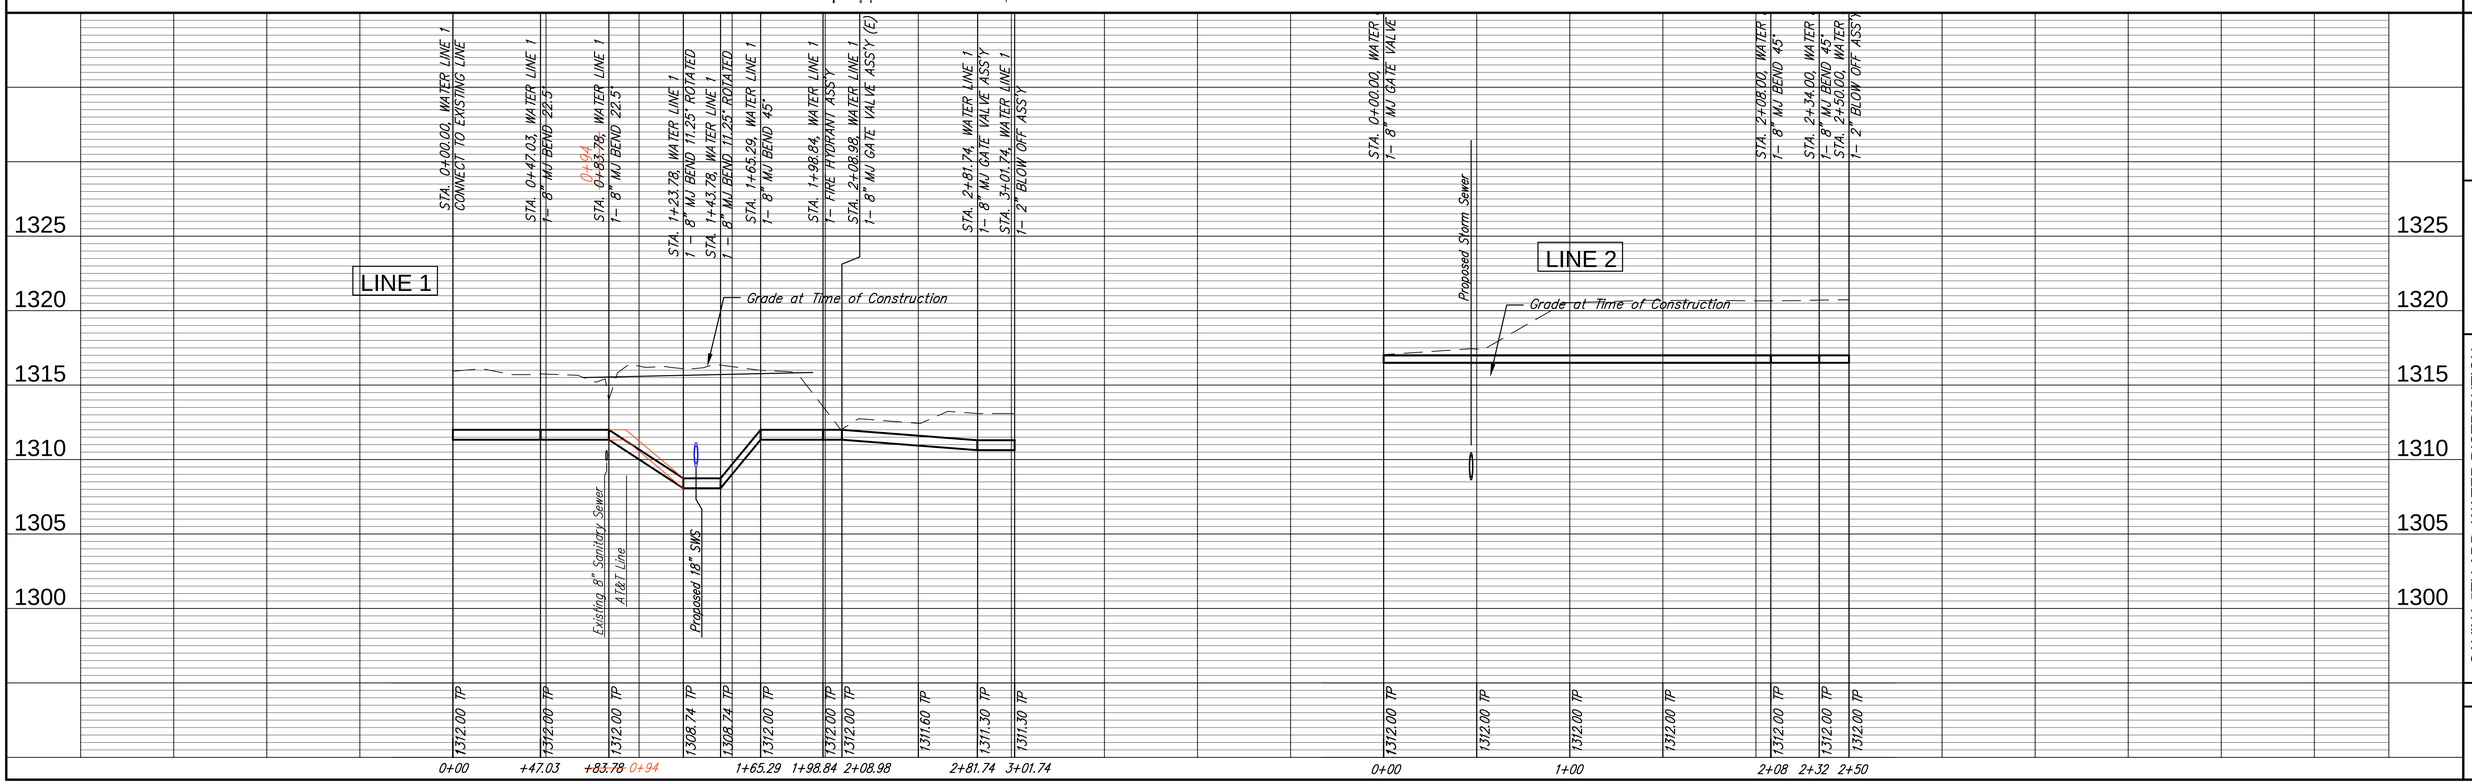


Ruggles & Bohm, P.A.
Engineering, Surveying, Land Planning
924 North Main
Wichita, Kansas 67203
(316) 264-8006
(316) 264-8011 fax
www.rbservices.com
E-mail: info@rbservices.com

DESIGN CMB
DRAWN RA
DATE Apr. 24, 2008
UTILITY
REVISED
REVIEW

PROJECT NUMBER -
DRAWING FILE engineering base {SS 1}

SAVINA 5TH ADD. WATER DISTRIBUTION
LINE 1 & LINE 2
WICHITA KANSAS

RB JOB 3245E
SHEET 3 OF 10