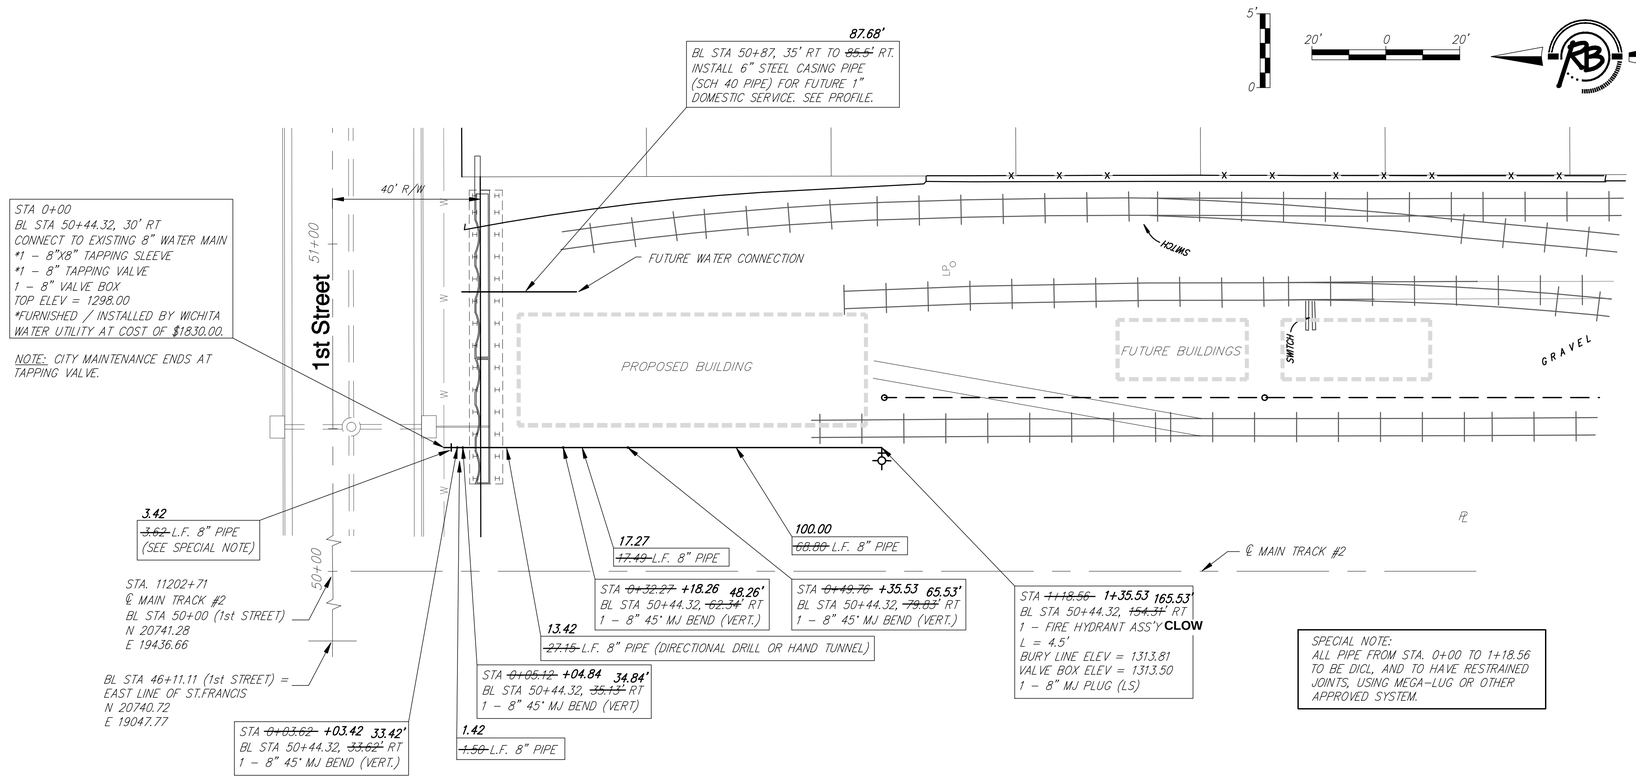

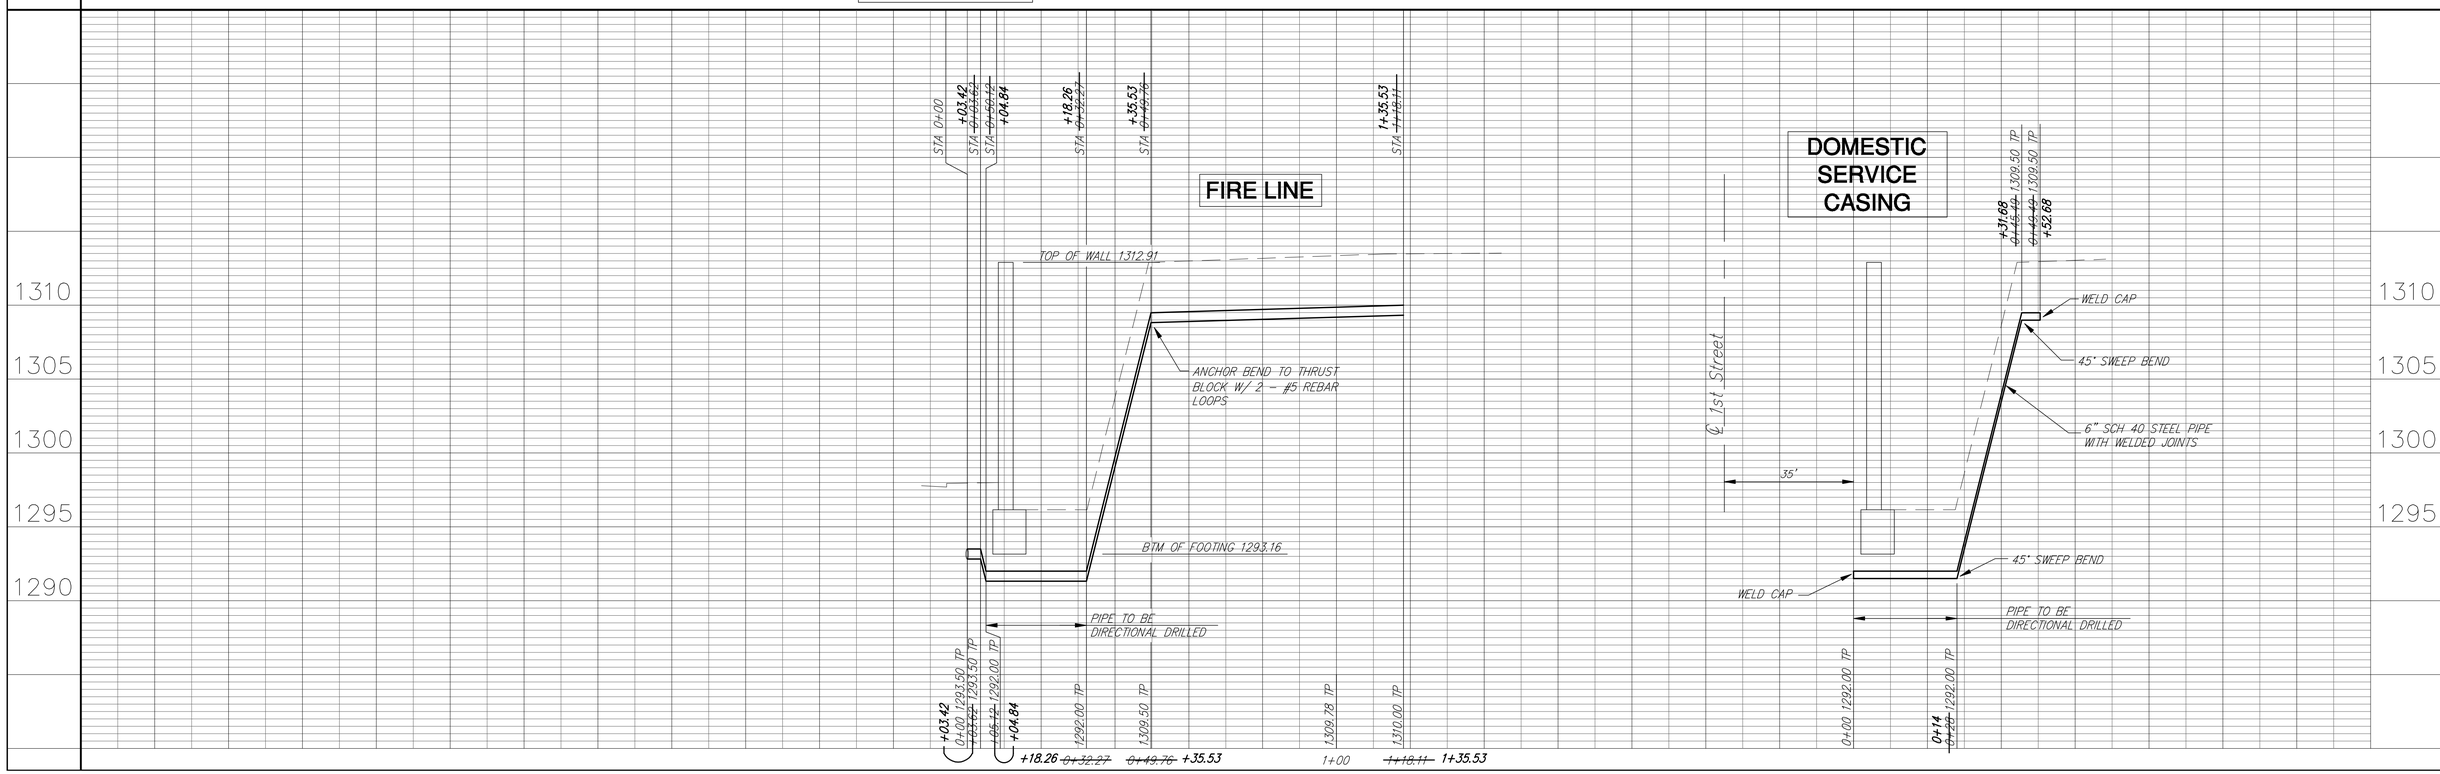

Ruggles & Bohm, P.A.
Engineering Surveying Land Planning
555 North Main
Wichita, Kansas 67203
(316) 263-5691
(316) 263-5696 Fax
www.ruggleslandsurvey.com

REVISED 10-23-08
DESIGN TCR
DRAWN RA
DATE Aug. 2, 2007
UTILITY
REVIEW

PROJECT NUMBER 1281 PPW
DRAWING FILE Water Plan & Profile

Water Main Extension
GREAT PLAINS TRANSP. MUSEUM

2883E

2
4