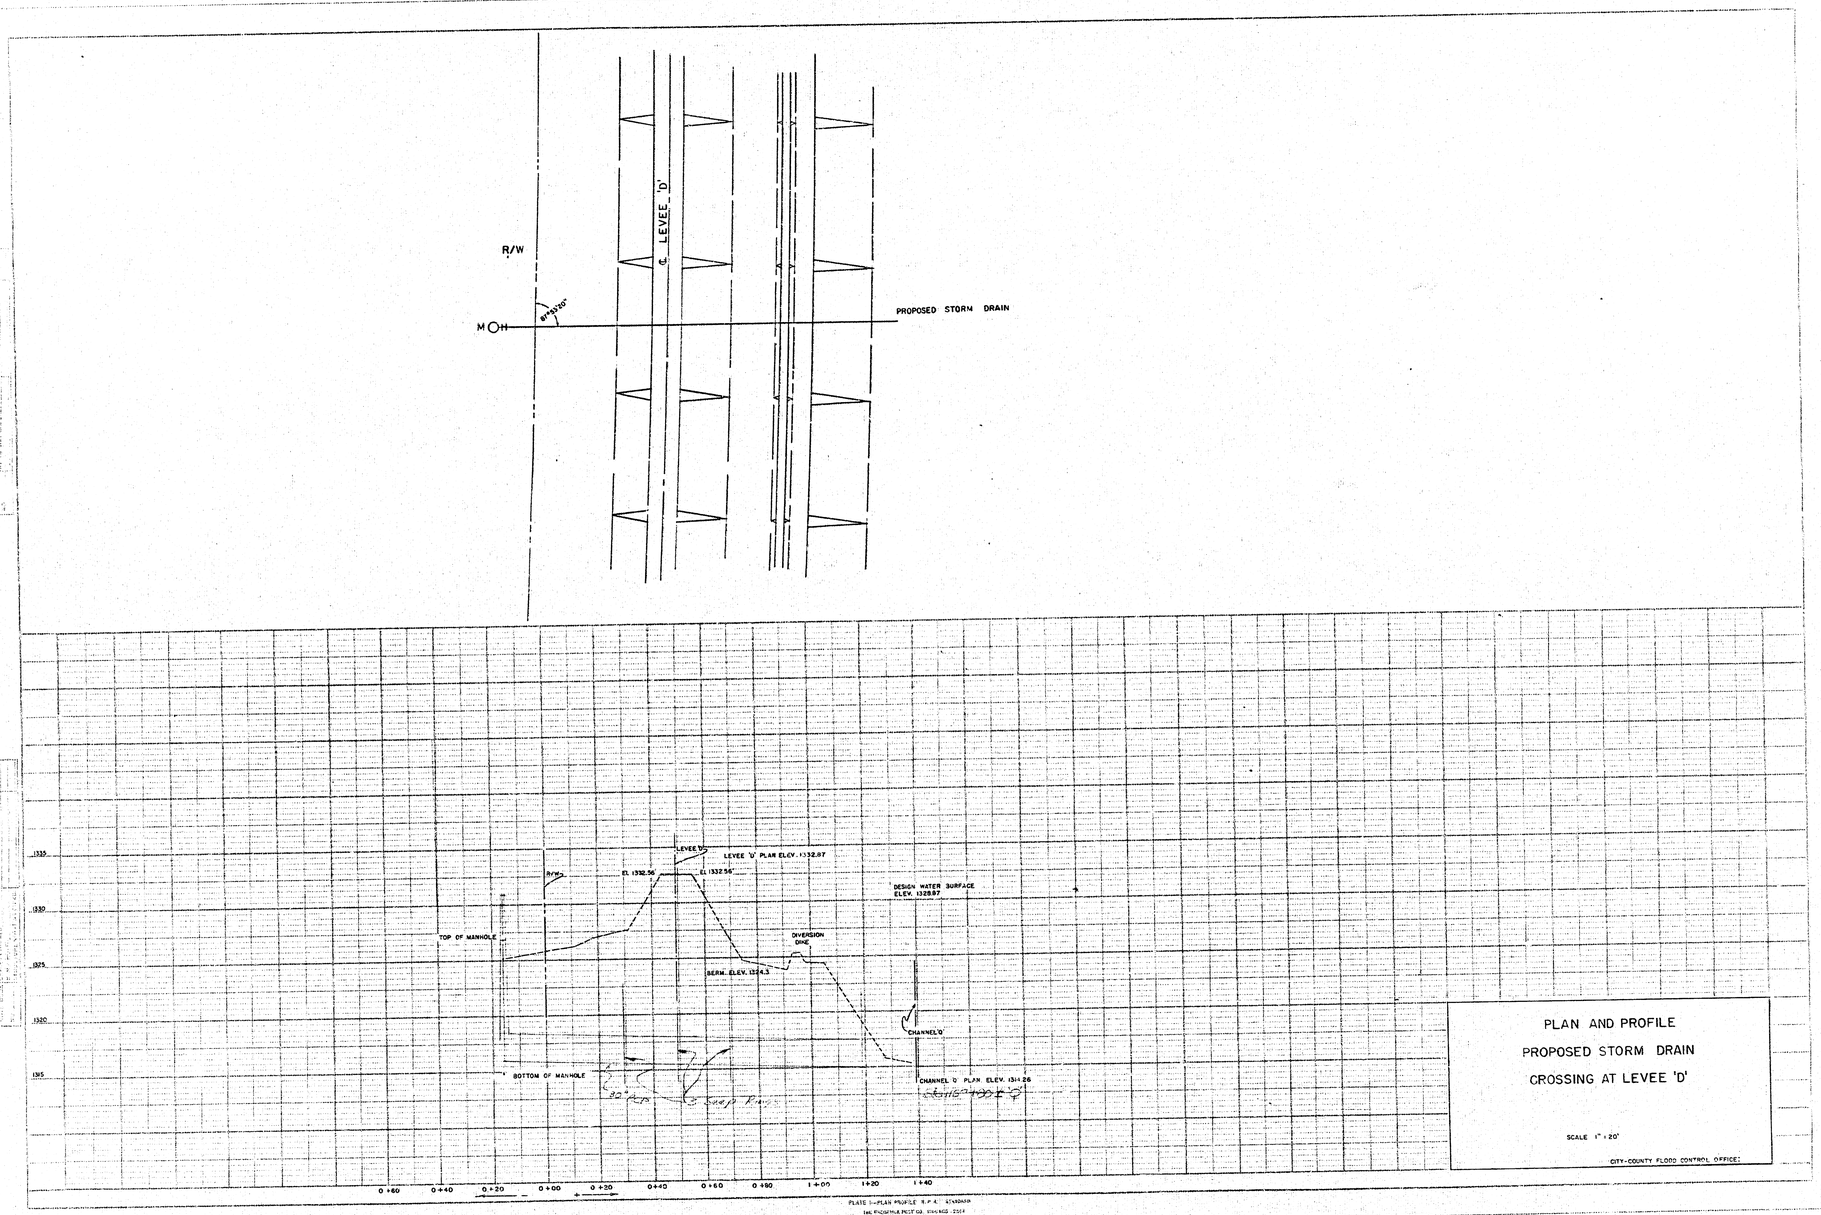

PLAN AND PROFILE
PROPOSED STORM DRAIN
CROSSING AT LEVEE 'D'

SCALE 1" = 20'

CITY-COUNTY FLOOD CONTROL OFFICE

PLATE 1—PLAN PROFILE R.P.A. STANDARD
INK PROOF PLAN PROFILE DRAWING 2564