
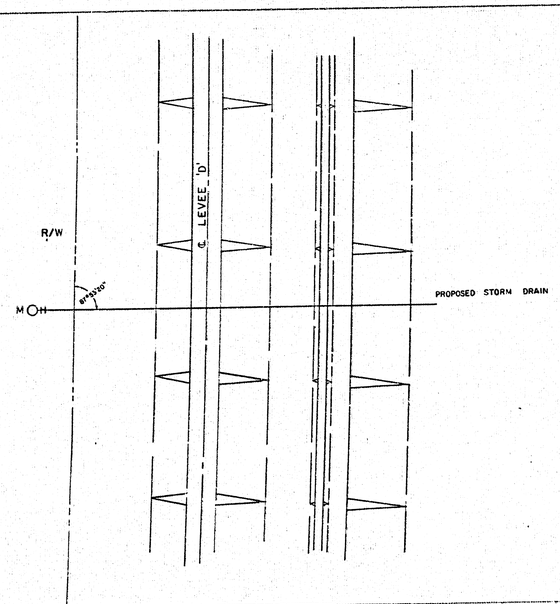


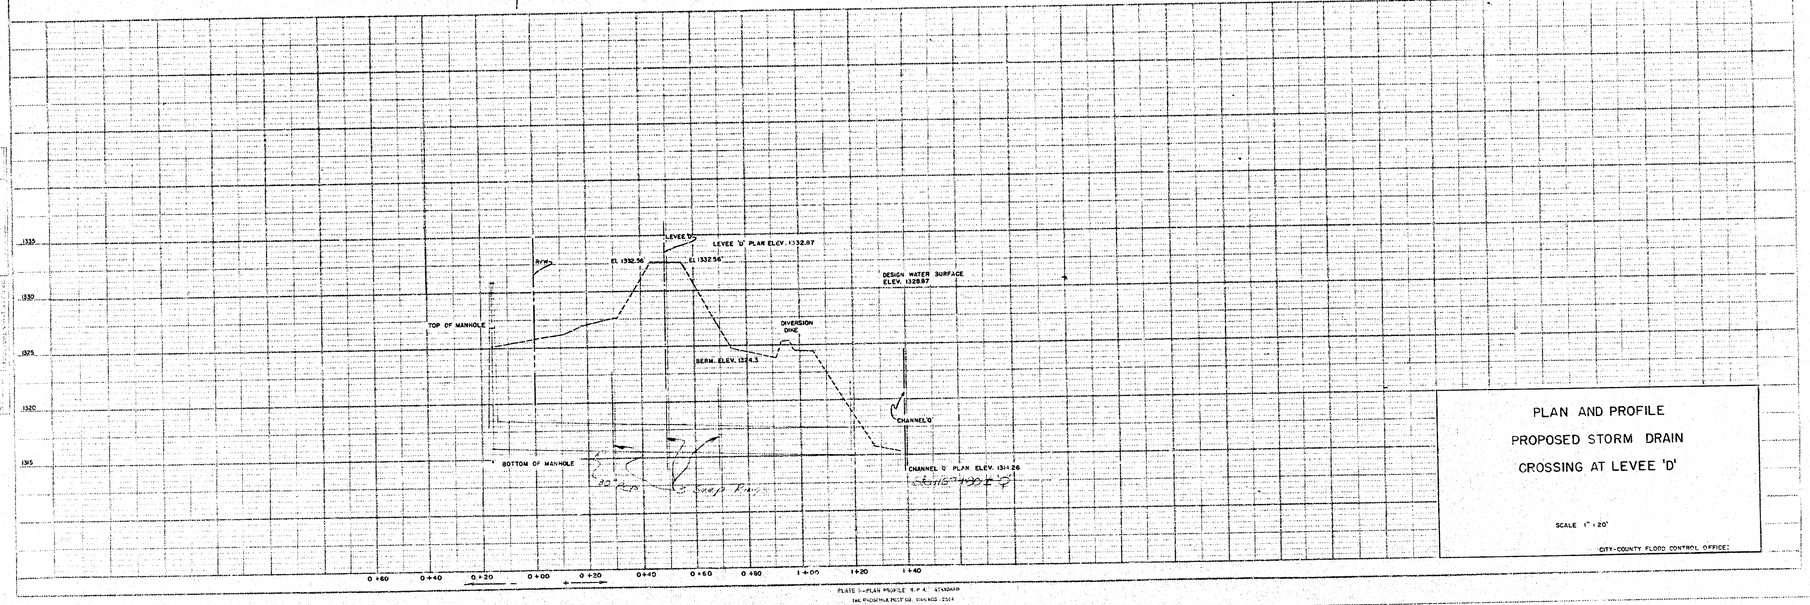

PLAN AND PROFILE

PROPOSED STORM DRAIN

CROSSING AT LEVEE 'D'

SCALE 1" = 20'

CITY-COUNTY FLOOD CONTROL OFFICE

PLATE 1—PLAN PROFILE R.P.A. STANDARD

INK PHOTOPLASTIC DRAWING 2504