SIDEWALK POINTS		
SW1	N1700238.50	E1686748.17
SW2	N1700171.21	E1686749.01
SW3	N1700170.99	E1686732.01
SW4	N1700154.00	E1686732.22
SW5	N1700153.73	E1686710.72
SW6	N1699858.80	E1686714.35

CONTROL POINTS		
CP1	N1699864.00	E1686711.79
CP2	N1700103.38	E1686524.40
CP3	N1699797.81	E1686220.42

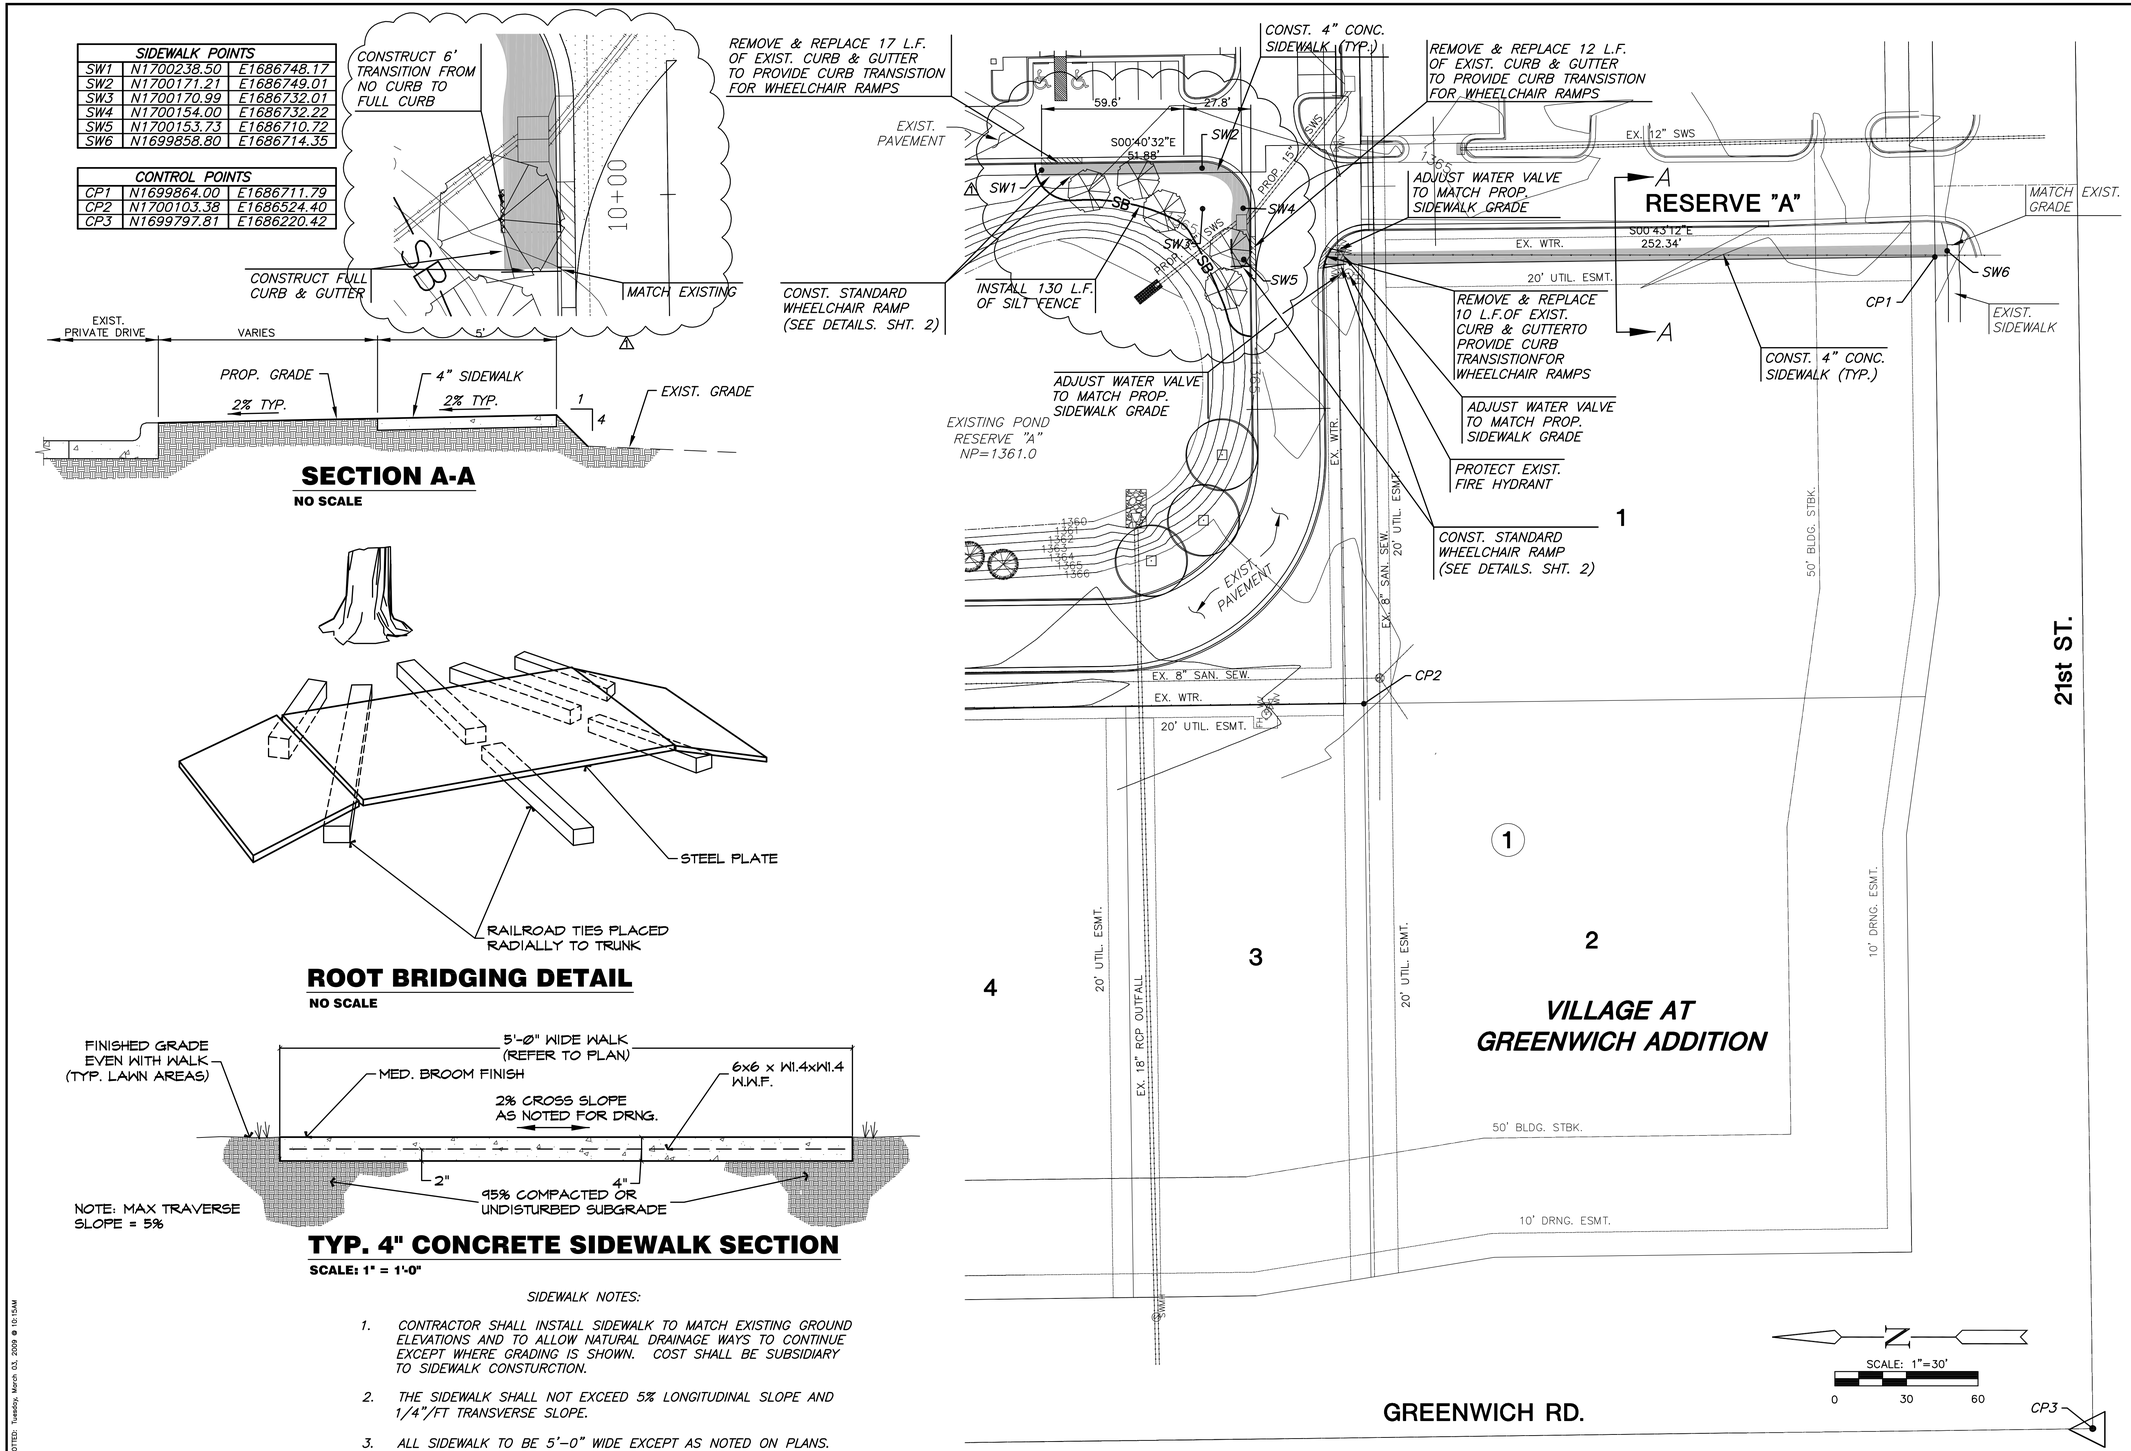

SIDEWALK NOTES:

1. CONTRACTOR SHALL INSTALL SIDEWALK TO MATCH EXISTING GROUND ELEVATIONS AND TO ALLOW NATURAL DRAINAGE WAYS TO CONTINUE EXCEPT WHERE GRADING IS SHOWN. COST SHALL BE SUBSIDIARY TO SIDEWALK CONSTURCTION.
2. THE SIDEWALK SHALL NOT EXCEED 5% LONGITUDINAL SLOPE AND 1/4"/FT TRANSVERSE SLOPE.
3. ALL SIDEWALK TO BE 5'-0" WIDE EXCEPT AS NOTED ON PLANS.

MKEC ENGINEERING CONSULTANTS, INC.
411 N. WEBB ROAD
WICHITA, KS. 67206
316 - 684 - 9600

PAVING PLANS FOR SIDEWALK

VILLAGE AT GREENWICH ADDITION

SIDEWALK PLAN
SHEET TITLE

472-84757
PROJECT NUMBER

SRS
DESIGN BY

MKEC
DRAWN BY

JTC
CHECKED BY

ISSUED
Feb-09

REVISED
3-3-09

SHEET NO.
3 of 8

J:\CIVIL\08307\DWG\PAV_WALK\08307E1.DWG

PLOTTED: Tuesday, March 03, 2009 @ 10:15AM