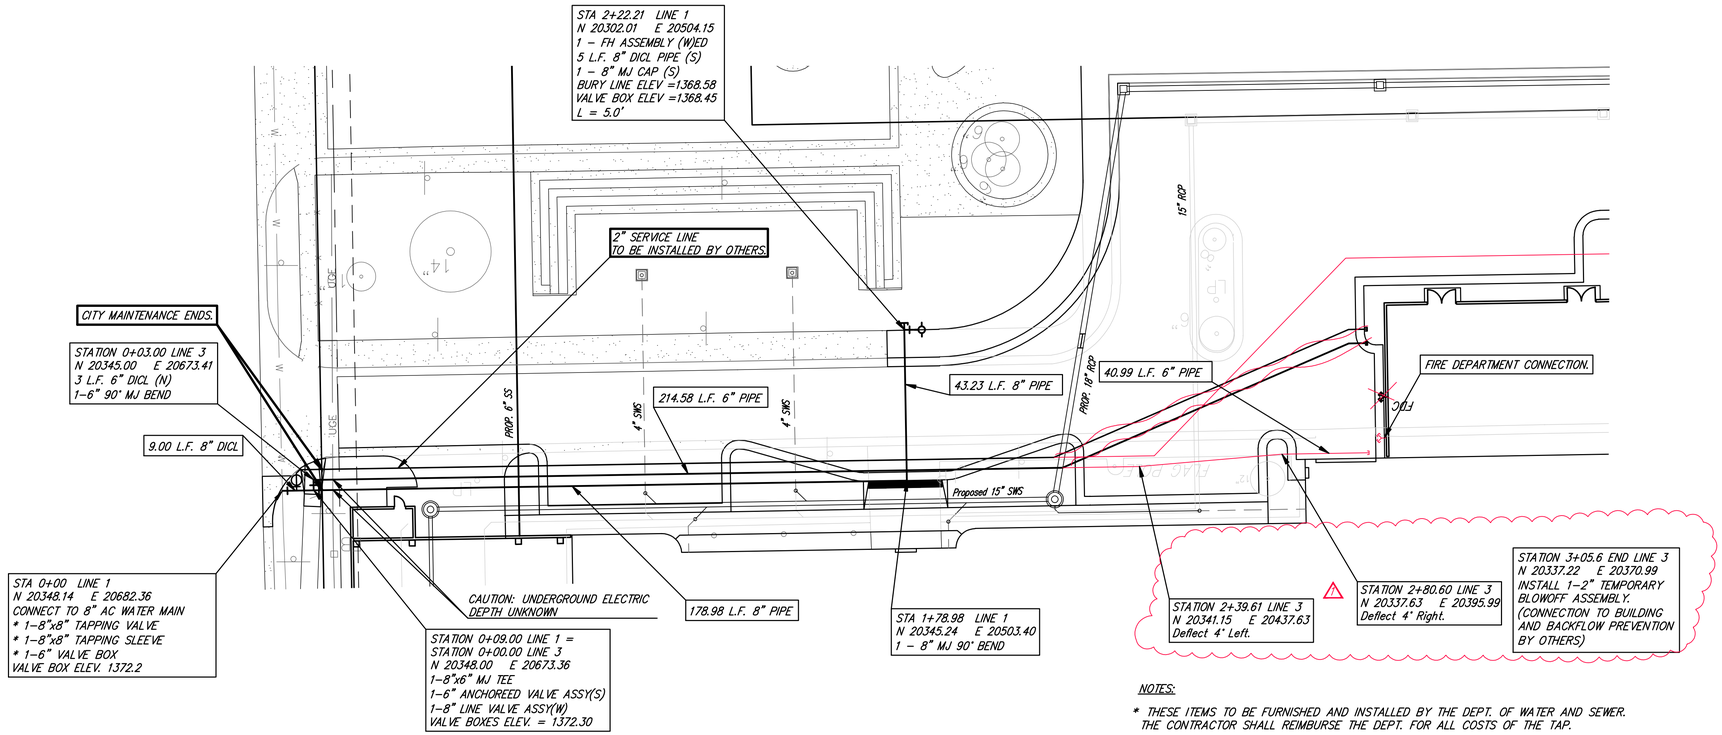

As-Built Plans
Contractor: Mies Construction
Inspector: Tim Kelly, Ruggles & Bohm P.A.
.pdf by: PSB, 3/5/09

NOTES:

* THESE ITEMS TO BE FURNISHED AND INSTALLED BY THE DEPT. OF WATER AND SEWER. THE CONTRACTOR SHALL REIMBURSE THE DEPT. FOR ALL COSTS OF THE TAP.

REVISION #1: REVISED THE 6" FIRE LINE. ELIMINATED 2 MJ-BENDS AND RELOCATED END NORTH APROX. 30 FEET.

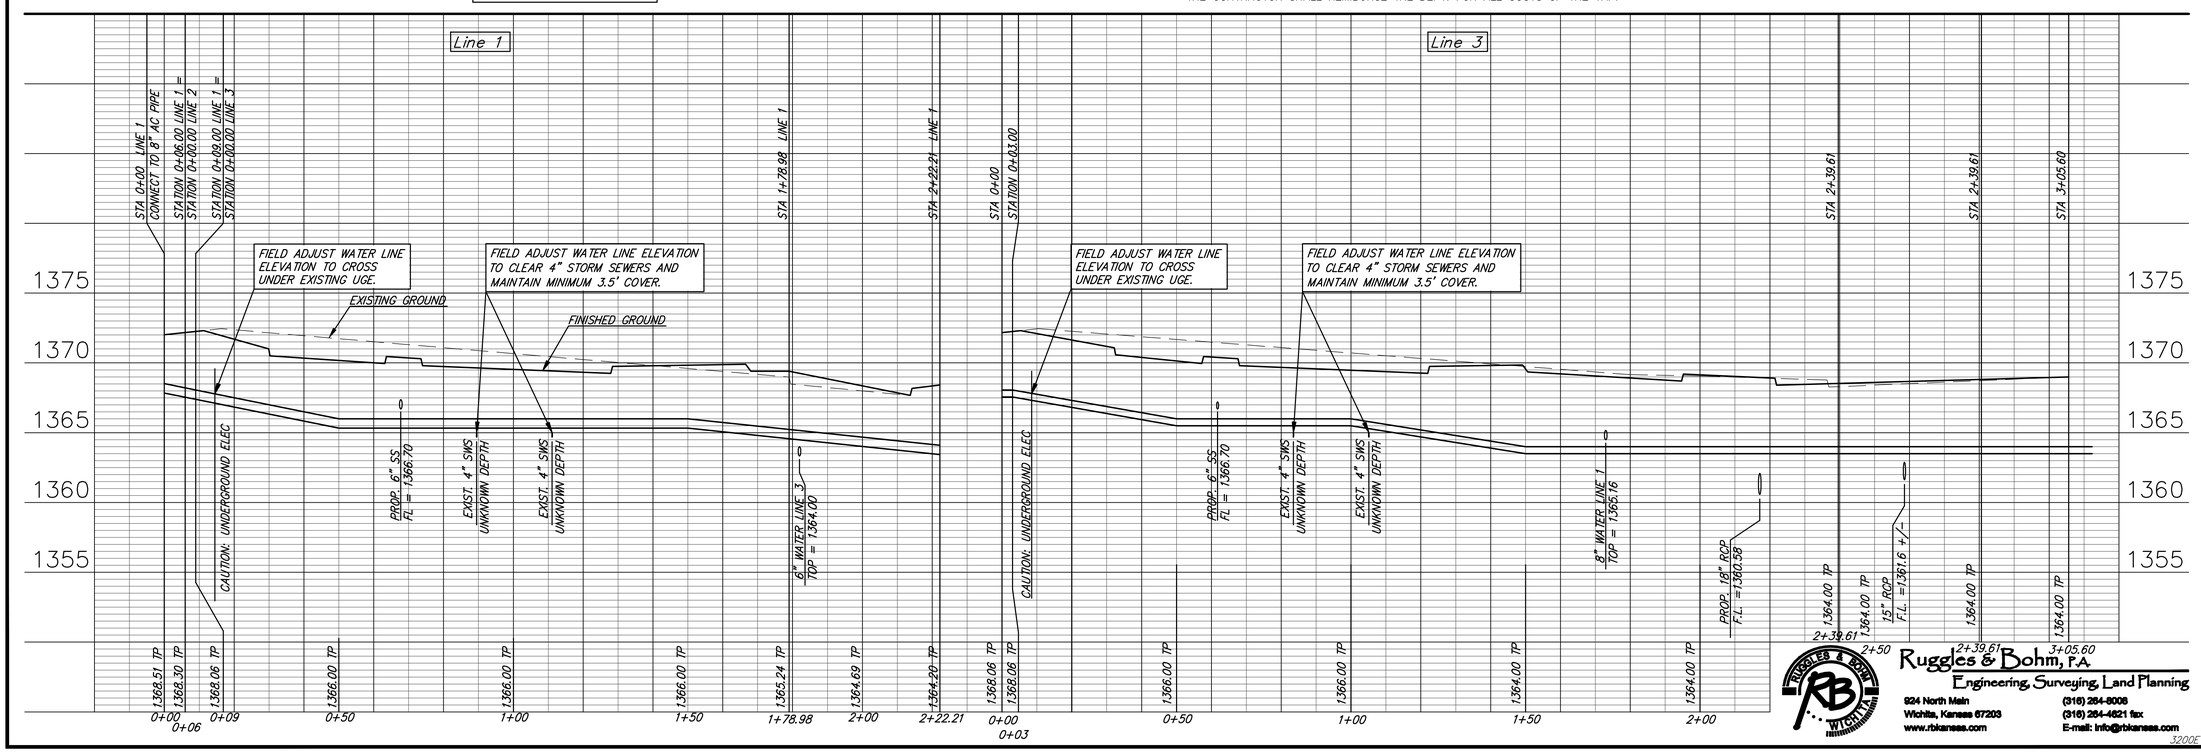

CONSULTING ENGINEERS:

CIVIL: RUGGLES & BOHM P.A.
CONTRACTOR BUILDING
WICHITA, KANSAS, 67205
(316) 264-8006 FAX: (316) 264-4621

STRUCTURAL: MCNEALY ENGINEERING INC.
11407 OLDE CABIN ROAD, STE 300
ST. LOUIS, MISSOURI 63141
C: BILL MCNEALY - P:(314) 997-7310

MECHANICAL: TENNILL & ASSOCIATES
177 CHESTERFIELD IND PKWY
CHESTERFIELD, MISSOURI 63005
C: DANA TENNILL - P:(636) 537-3660

ELECTRICAL: TENNILL & ASSOCIATES
177 CHESTERFIELD IND PKWY
CHESTERFIELD, MISSOURI 63005
C: DANA TENNILL

PLUMBING: TENNILL & ASSOCIATES
177 CHESTERFIELD IND PKWY
CHESTERFIELD, MISSOURI 63005
C: DANA TENNILL - P:(636) 537-3660

FIRE PROTECTION: FIRE TECH LLC
1555 BLUFF ROAD
OLIVETTE, MISSOURI 63132
C: PAUL WOODARD - P:(314) 292-6520

CONTRACTOR:
OCONNOR & ASSOCIATES CONSTRUCTION INC
3800 S HOOVER ROAD
WICHITA, KANSAS, 67277
(316) 945-0900

ARCHITECT: GMA DESIGN GROUP INC.
ARCHITECTURAL DESIGN SERVICES
A DIVISION OF ARCO NATIONAL CONSTRUCTION
1551 N. WATERFRONT PKWY, BUILDING I, SUITE 100
PHONE 316-268-8000 FAX 316-268-8020

PROPOSED BUILDING FOR:
9720 EAST CENTRAL AVENUE
WICHITA, KANSAS

I CERTIFY TO THE BEST OF MY KNOWLEDGE THAT THE DRAWINGS & SPECIFICATIONS COMPLY WITH THE APPLICABLE MINIMUM BUILDING CODES

JOB NO : SJ0717
DRAWN BY : psb
ISSUE DATE : 3-3-08

REVISIONS △
1
2
3
4
5

THIS DESIGN AND THESE DRAWINGS ARE THE PROPERTY OF RUGGLES & BOHM, P.A. AND MAY NOT BE USED OR REPRODUCED WITHOUT PRIOR WRITTEN PERMISSION FROM GMA DESIGN GROUP.

Ruggles & Bohm, P.A.
Engineering, Surveying, Land Planning
924 North Main
Wichita, Kansas 67203
www.rbkansas.com
(316) 264-8006
(316) 264-4621 fax
E-mail: info@rbkansas.com

SHEET NUMBER
PPW-2

3200E