
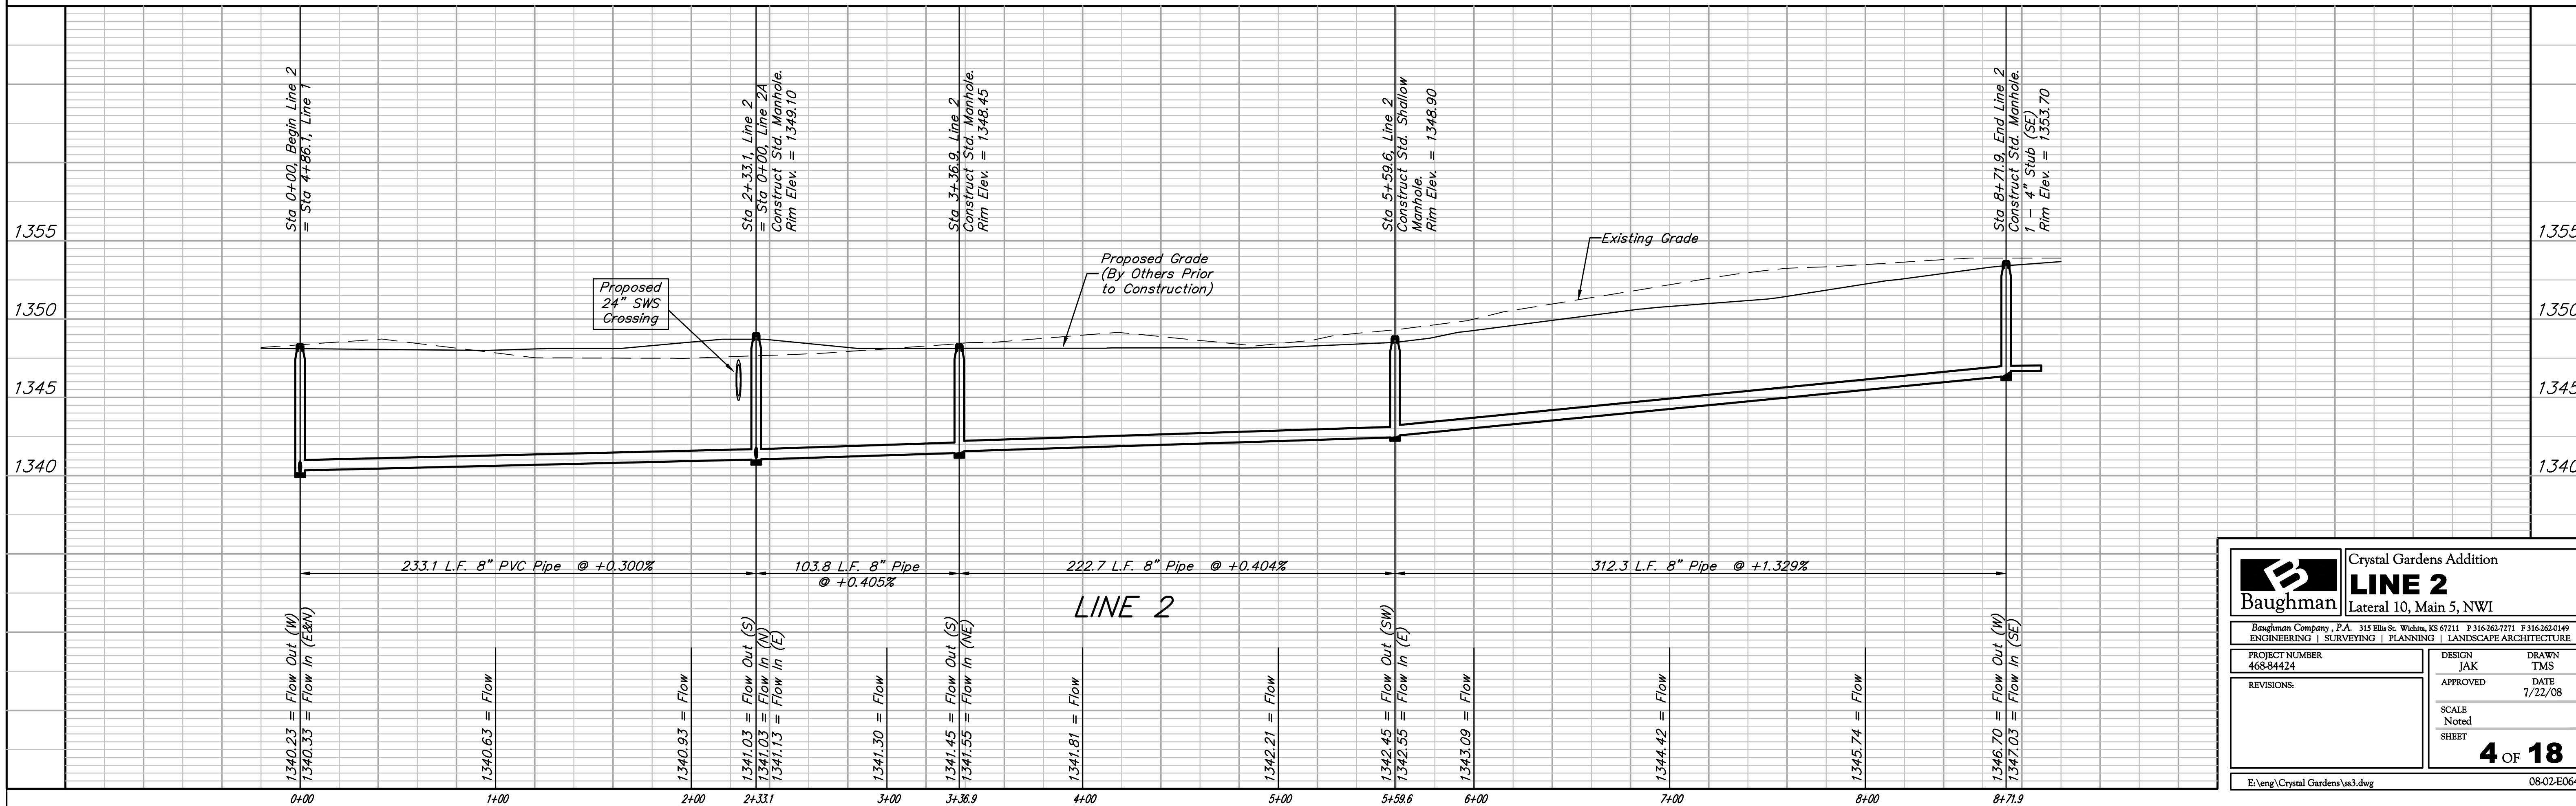


Benchmark:
 "□" Cut On Top of Curb, West Side of
 Forestview, East of Fire Hydrant, and
 Along Easterly Extension of the South
 Line of Lot 2, Block A, Liberty Park 2nd
 Addition.
 Elev. = 1347.62 NGVD29

City of Wichita Benchmark Southwest
 Corner of 13th ST N and 135th ST W 30'
 South and 35' West Intersection. East
 Side of Concrete Base for Highline Pole.
 Elev. = 1355.65 NGVD29

Scale: 1" = 40' Horizontal
 1" = 5' Vertical
 • = Iron

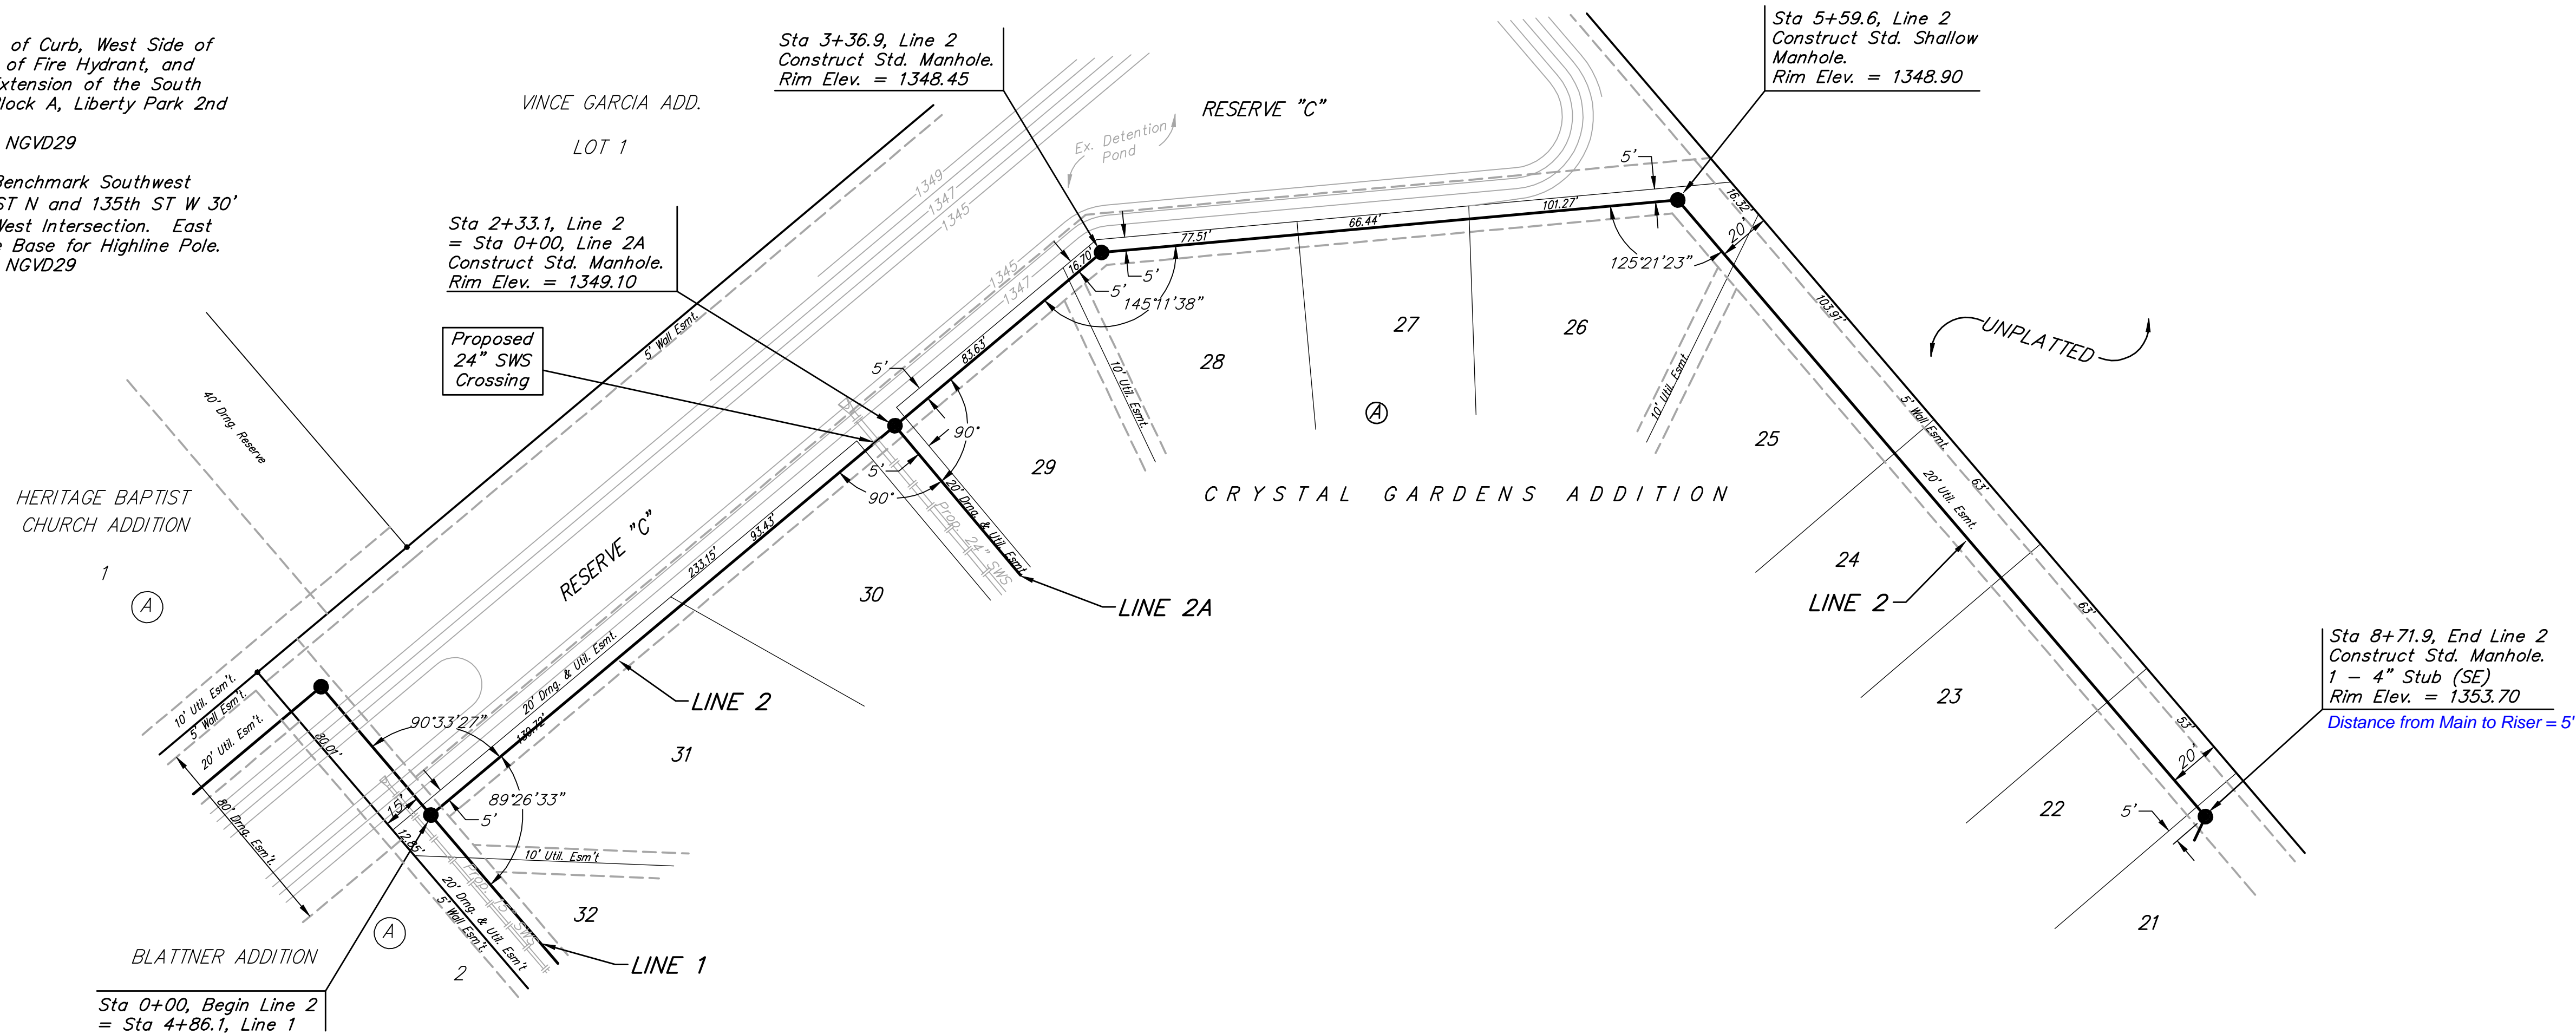

Baughman		Crystal Gardens Addition	
PROJECT NUMBER 468-84424		LINE 2 Lateral 10, Main 5, NWI	
DESIGN JAK		DRAWN TMS	
APPROVED		DATE 1/22/08	
REVISIONS:		SCALE Noted	
		SHEET 4 OF 18	
E:\eng\Crystal Gardens\as3.dwg		08-02-EO64	