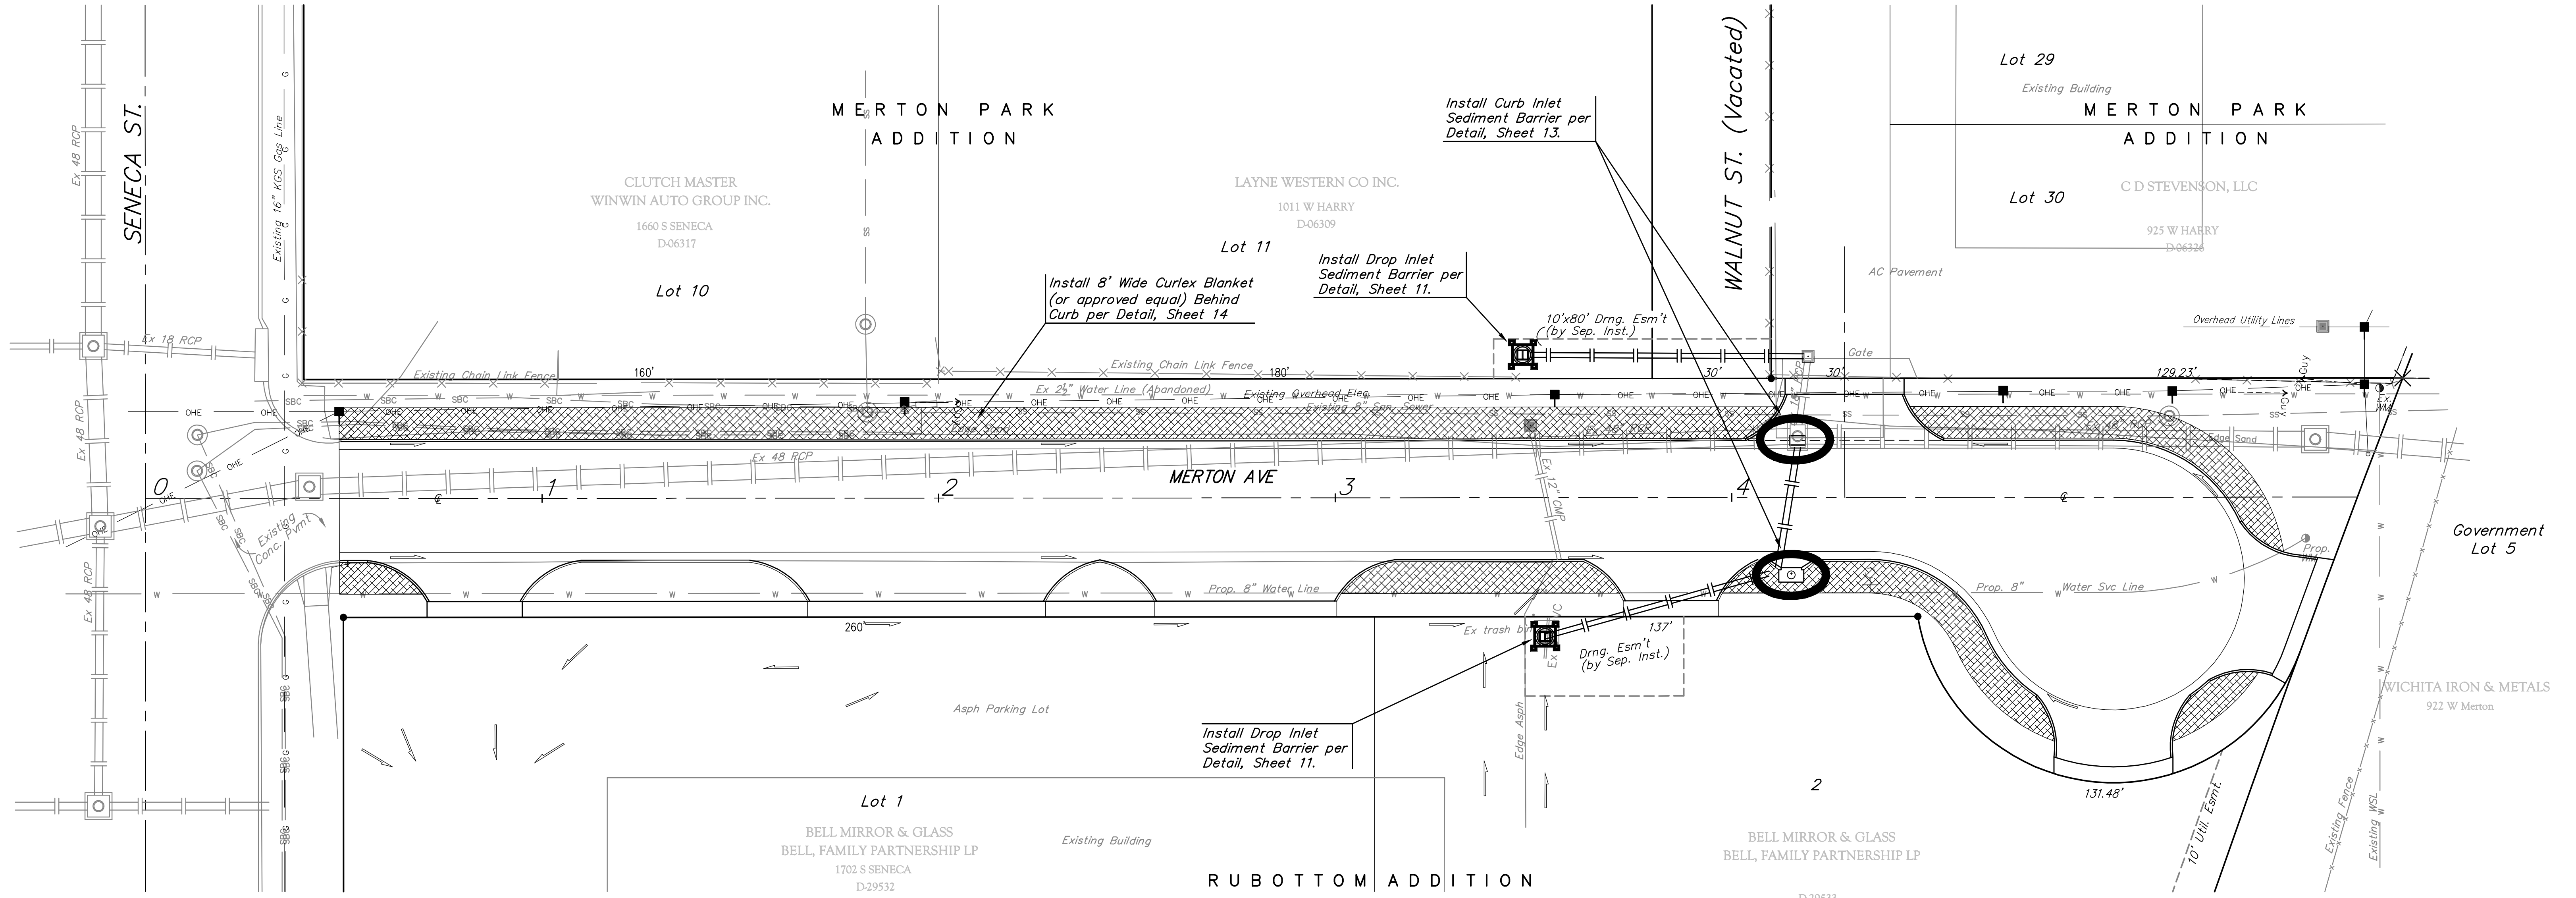
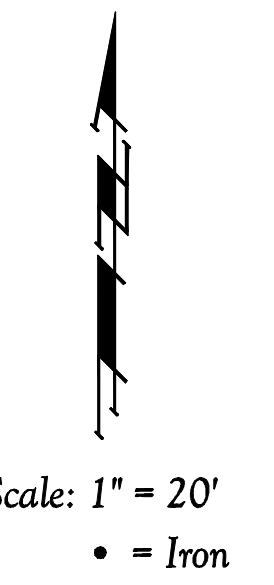


BENCHMARKS:

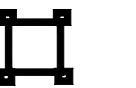

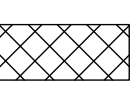
City of Wichita Benchmark
Disk at the Southwest
Corner of Seneca & May
Elev. = 1288.67 MSL

"□" Cut South End of
Return on Southeast Corner
of Seneca & Merton Ave.
Elev. = 1289.12 MSL




EROSION CONTROL MEASURE	UNITS	QUANTITY
DROP INLET BARRIER	EA.	2
CURB INLET BARRIER	EA.	2
CURLEX	S.Y.	576

EROSION CONTROL PLAN LEGEND

-  - DROP INLET PROTECTION
-  - CURB INLET PROTECTION
-  - CURLEX BLANKET

NO SCALE



Baughman Company, P.A.
315 Ellis St. Wichita, KS 67211
P 316-262-7271 F 316-262-0149
ENGINEERING | SURVEYING | PLANNING | LANDSCAPE ARCHITECTURE

Street Improvements
EROSION CONTROL PLAN
Merton Ave. Paving

PROJECT NUMBER 472-84410	DESIGN KK	DRAWN JK
REVISIONS:	APPROVED NBW	DATE 11/15/06
SCALE Noted		SHEET 10 OF 17