



PROFILE CHECKED CHECKED
BY DATE

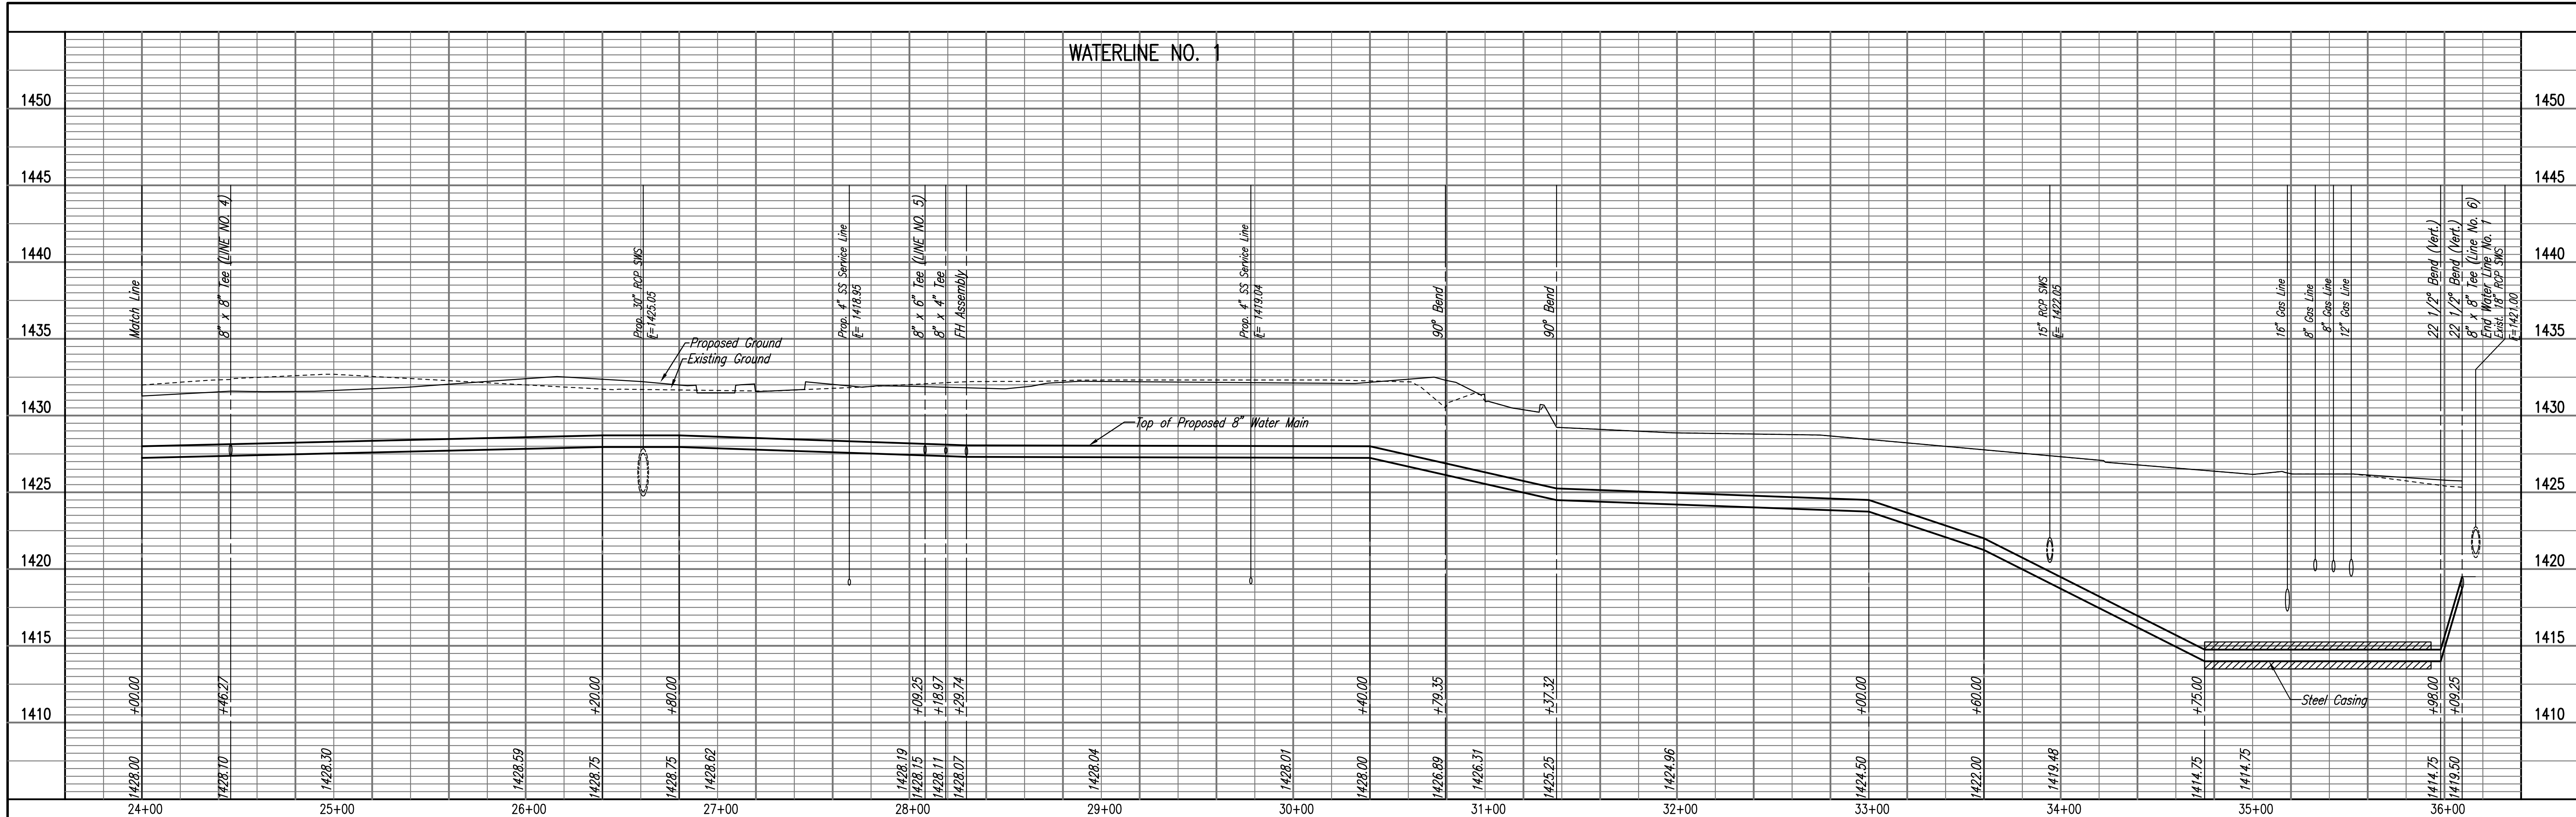

PROFILE CHECKED CHECKED
BY DATE

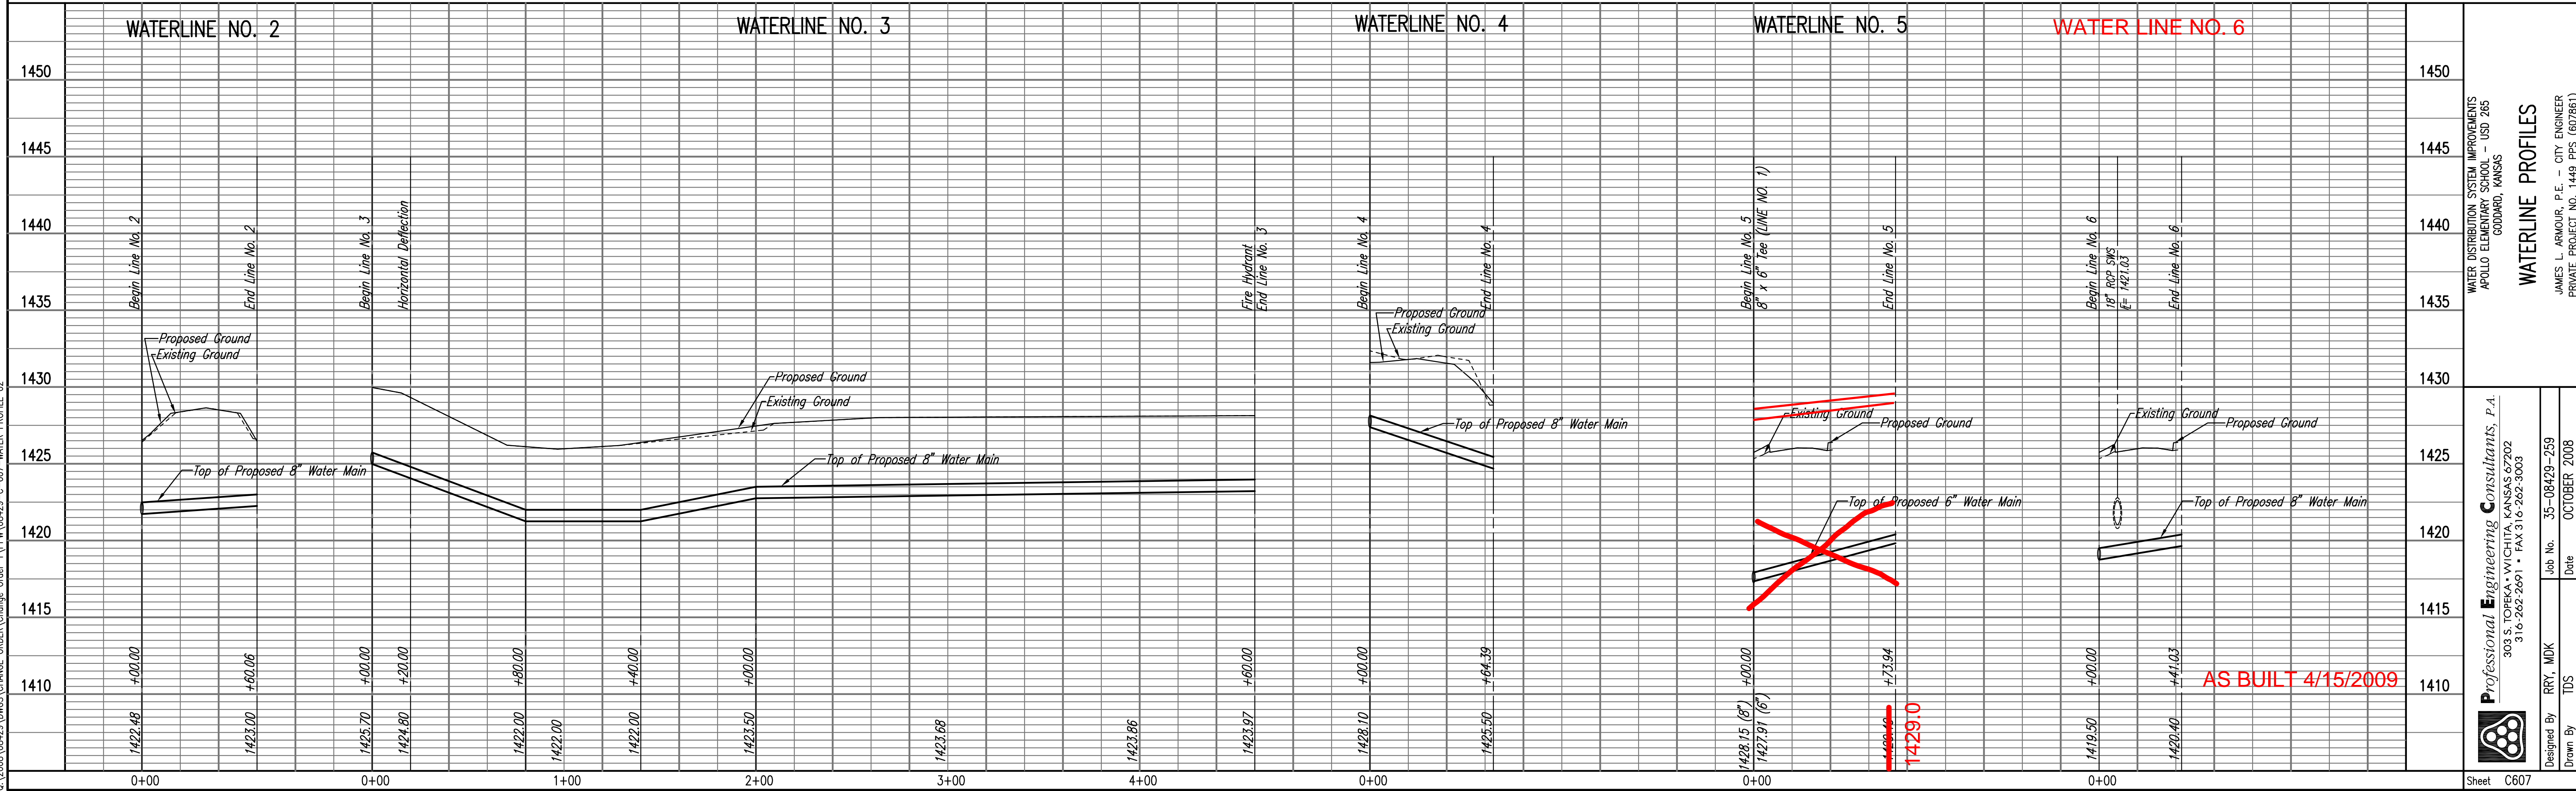

Saved: 01-19-2009 3:06:16 PM by RYJ
Plot Scale: 1"=40'
0:\2008\08429\DWG\CHANGE ORDER\1\PPM\08429-C-607-WATER PROFILE 02

Professional Engineering Consultants, P.A.
316-202-2091 • FAX 316-202-3003

WATER DISTRIBUTION SYSTEM IMPROVEMENTS
APOLLO ELEMENTARY SCHOOL - USD 265
GODDARD, KANSAS

WATERLINE PROFILES
JAMES L. ARMOUR, P.E. - CITY ENGINEER
PRIVATE PROJECT NO. 1449 PPS (607861)

Designed by RRY, MDK
Job No. 35-08429-259
Drawn by TDS
Date OCTOBER 2008

Sheet C607