
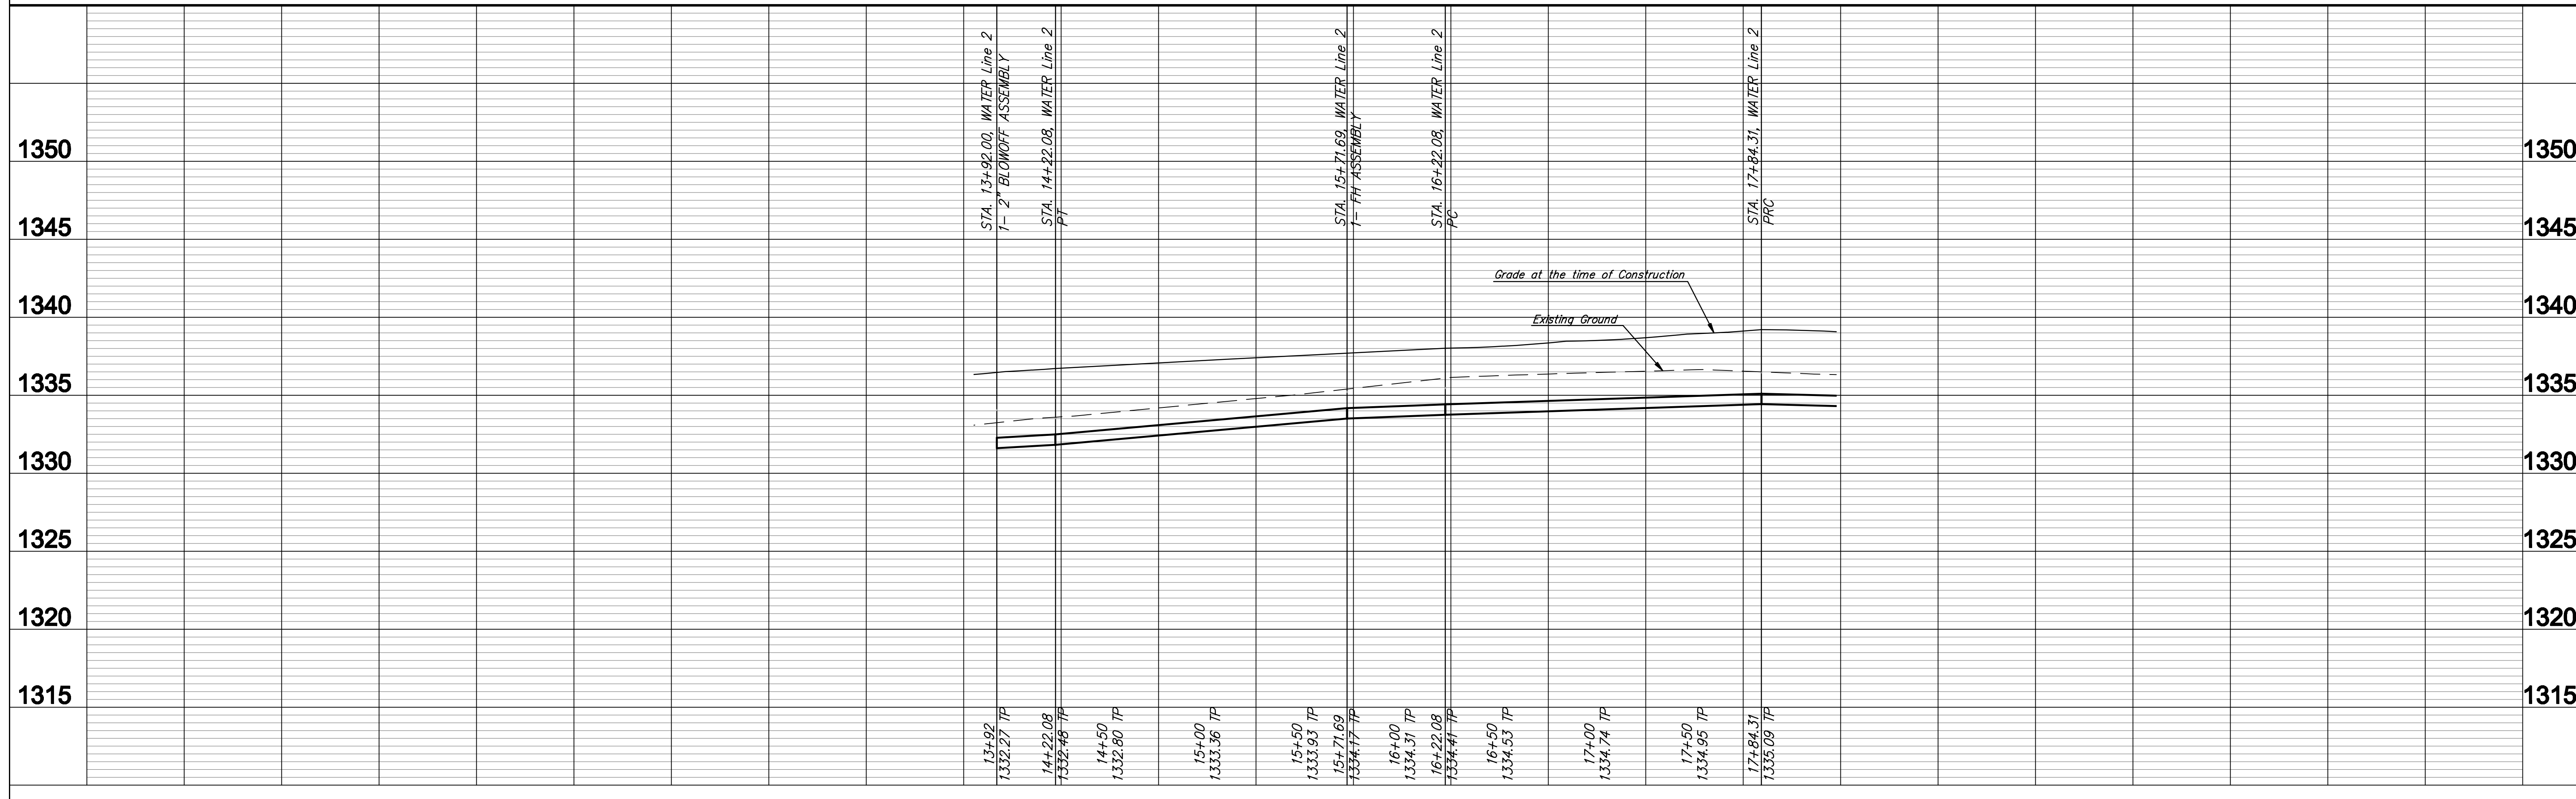
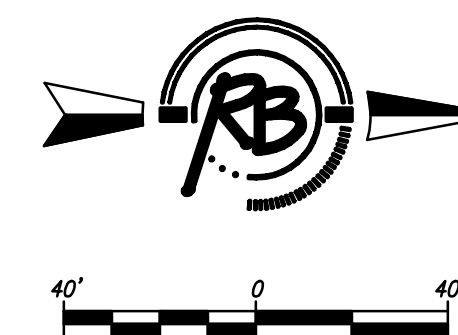


Sierra Hills 2nd Addition

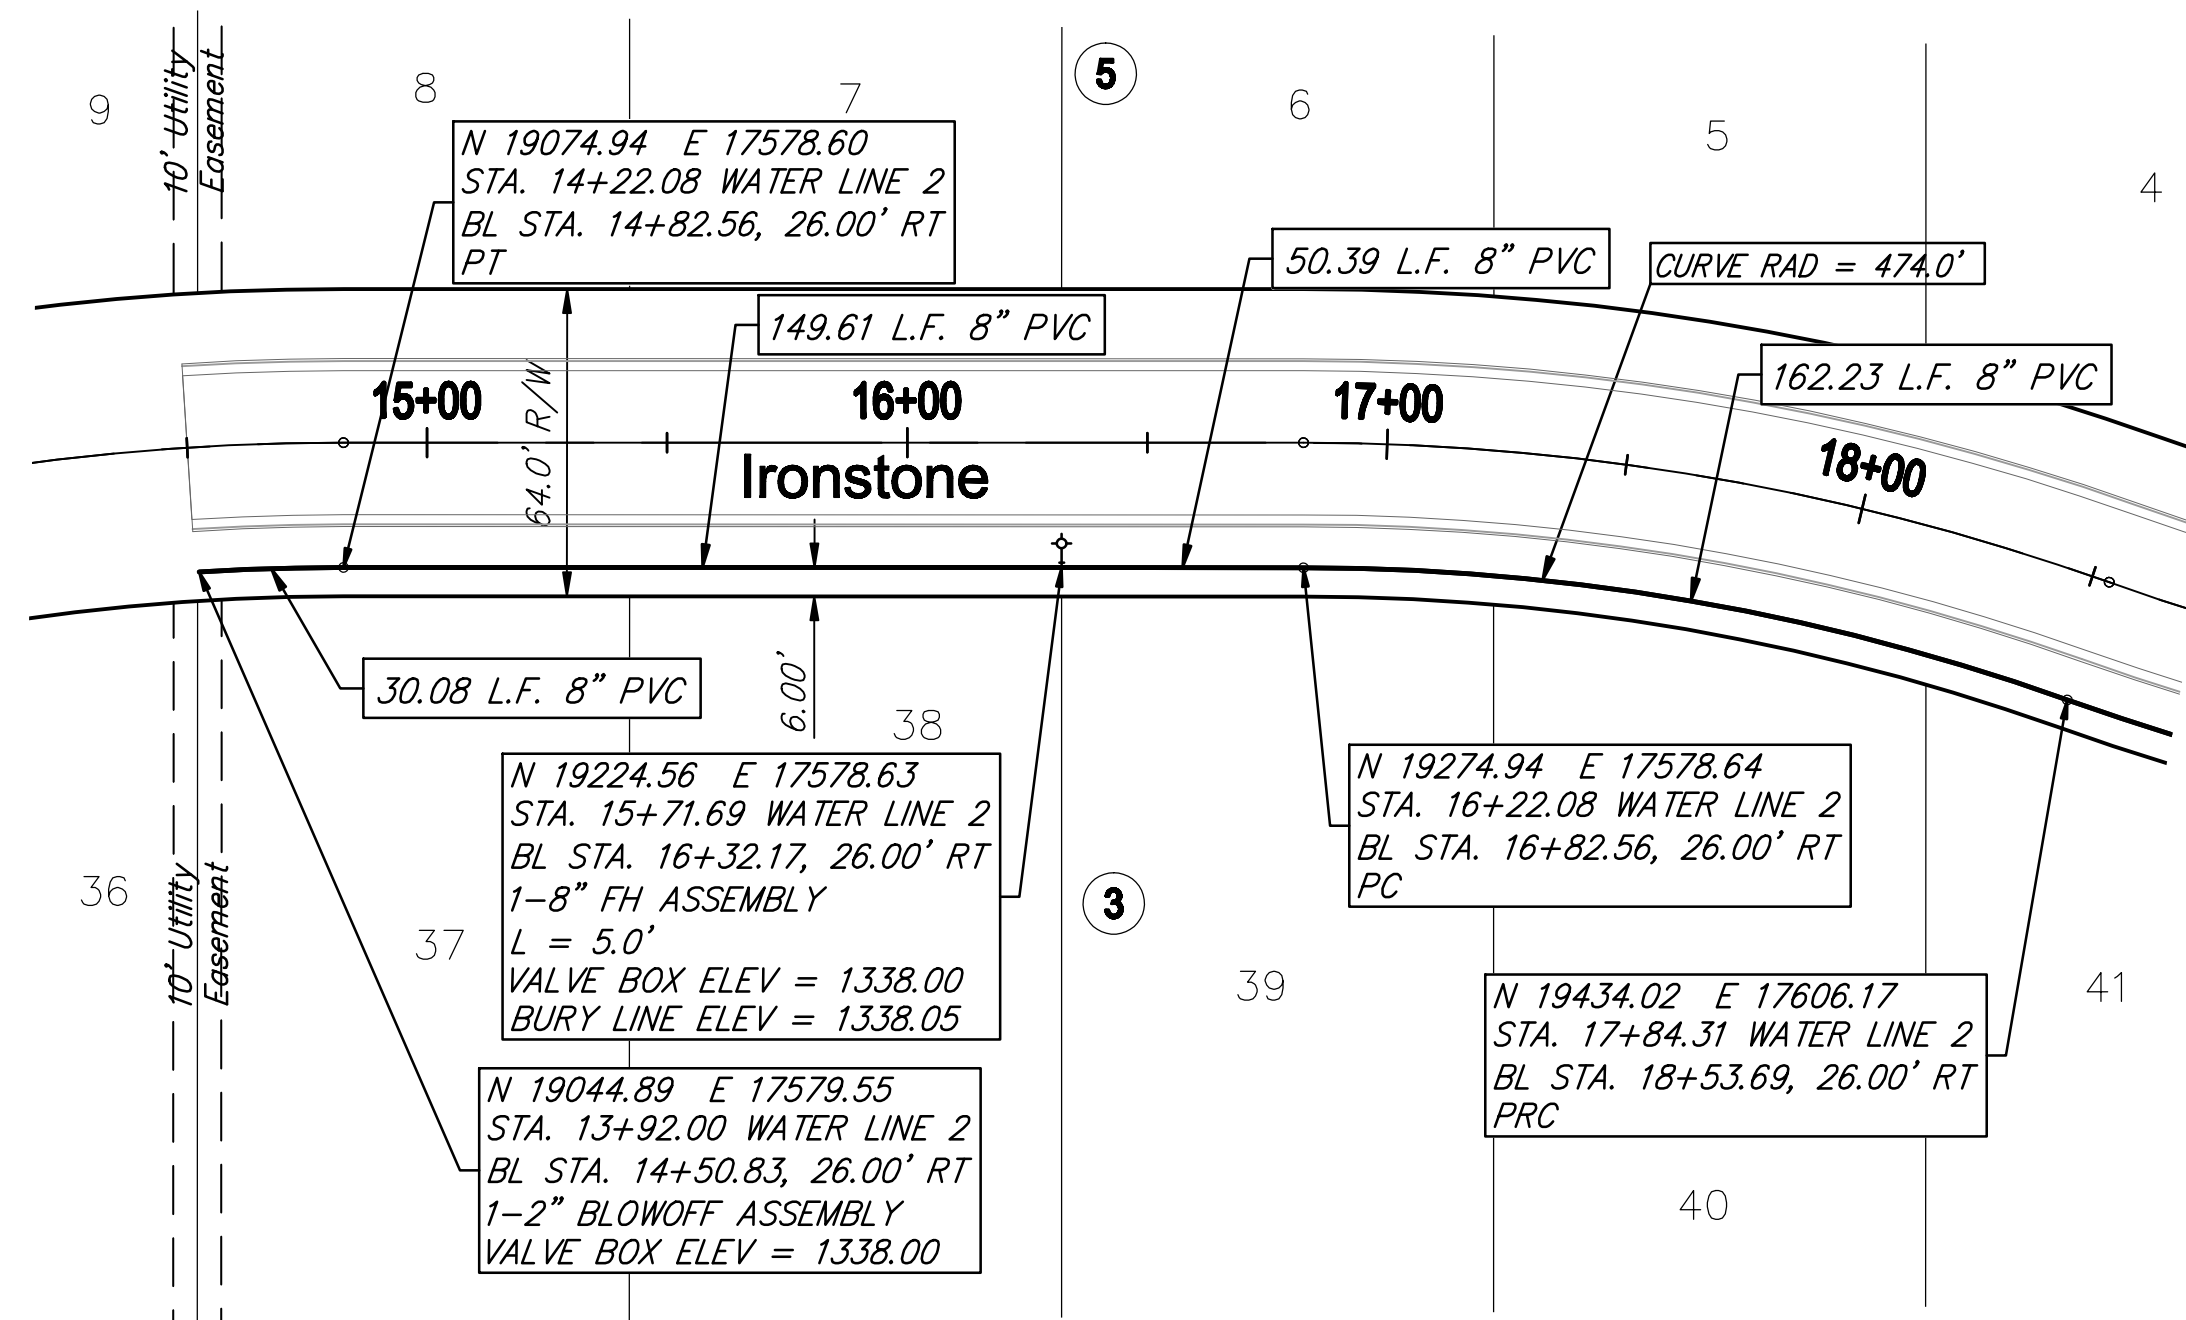

WATER MAIN IMPROVEMENTS
Water Line 2 (2)
WICHITA, KANSAS

PROJECT NUMBER: 448-20289
 DRAWING TITLE: Water Line 2 (2)

DATE: July 10, 2008
 ELEVATION: 1315, 1320, 1325, 1330, 1335, 1340, 1345, 1350
 STATIONING: 13+92, 14+22.08, 14+50, 15+00, 15+50, 15+71.69, 16+00, 16+22.08, 16+50, 17+00, 17+50, 17+84.31