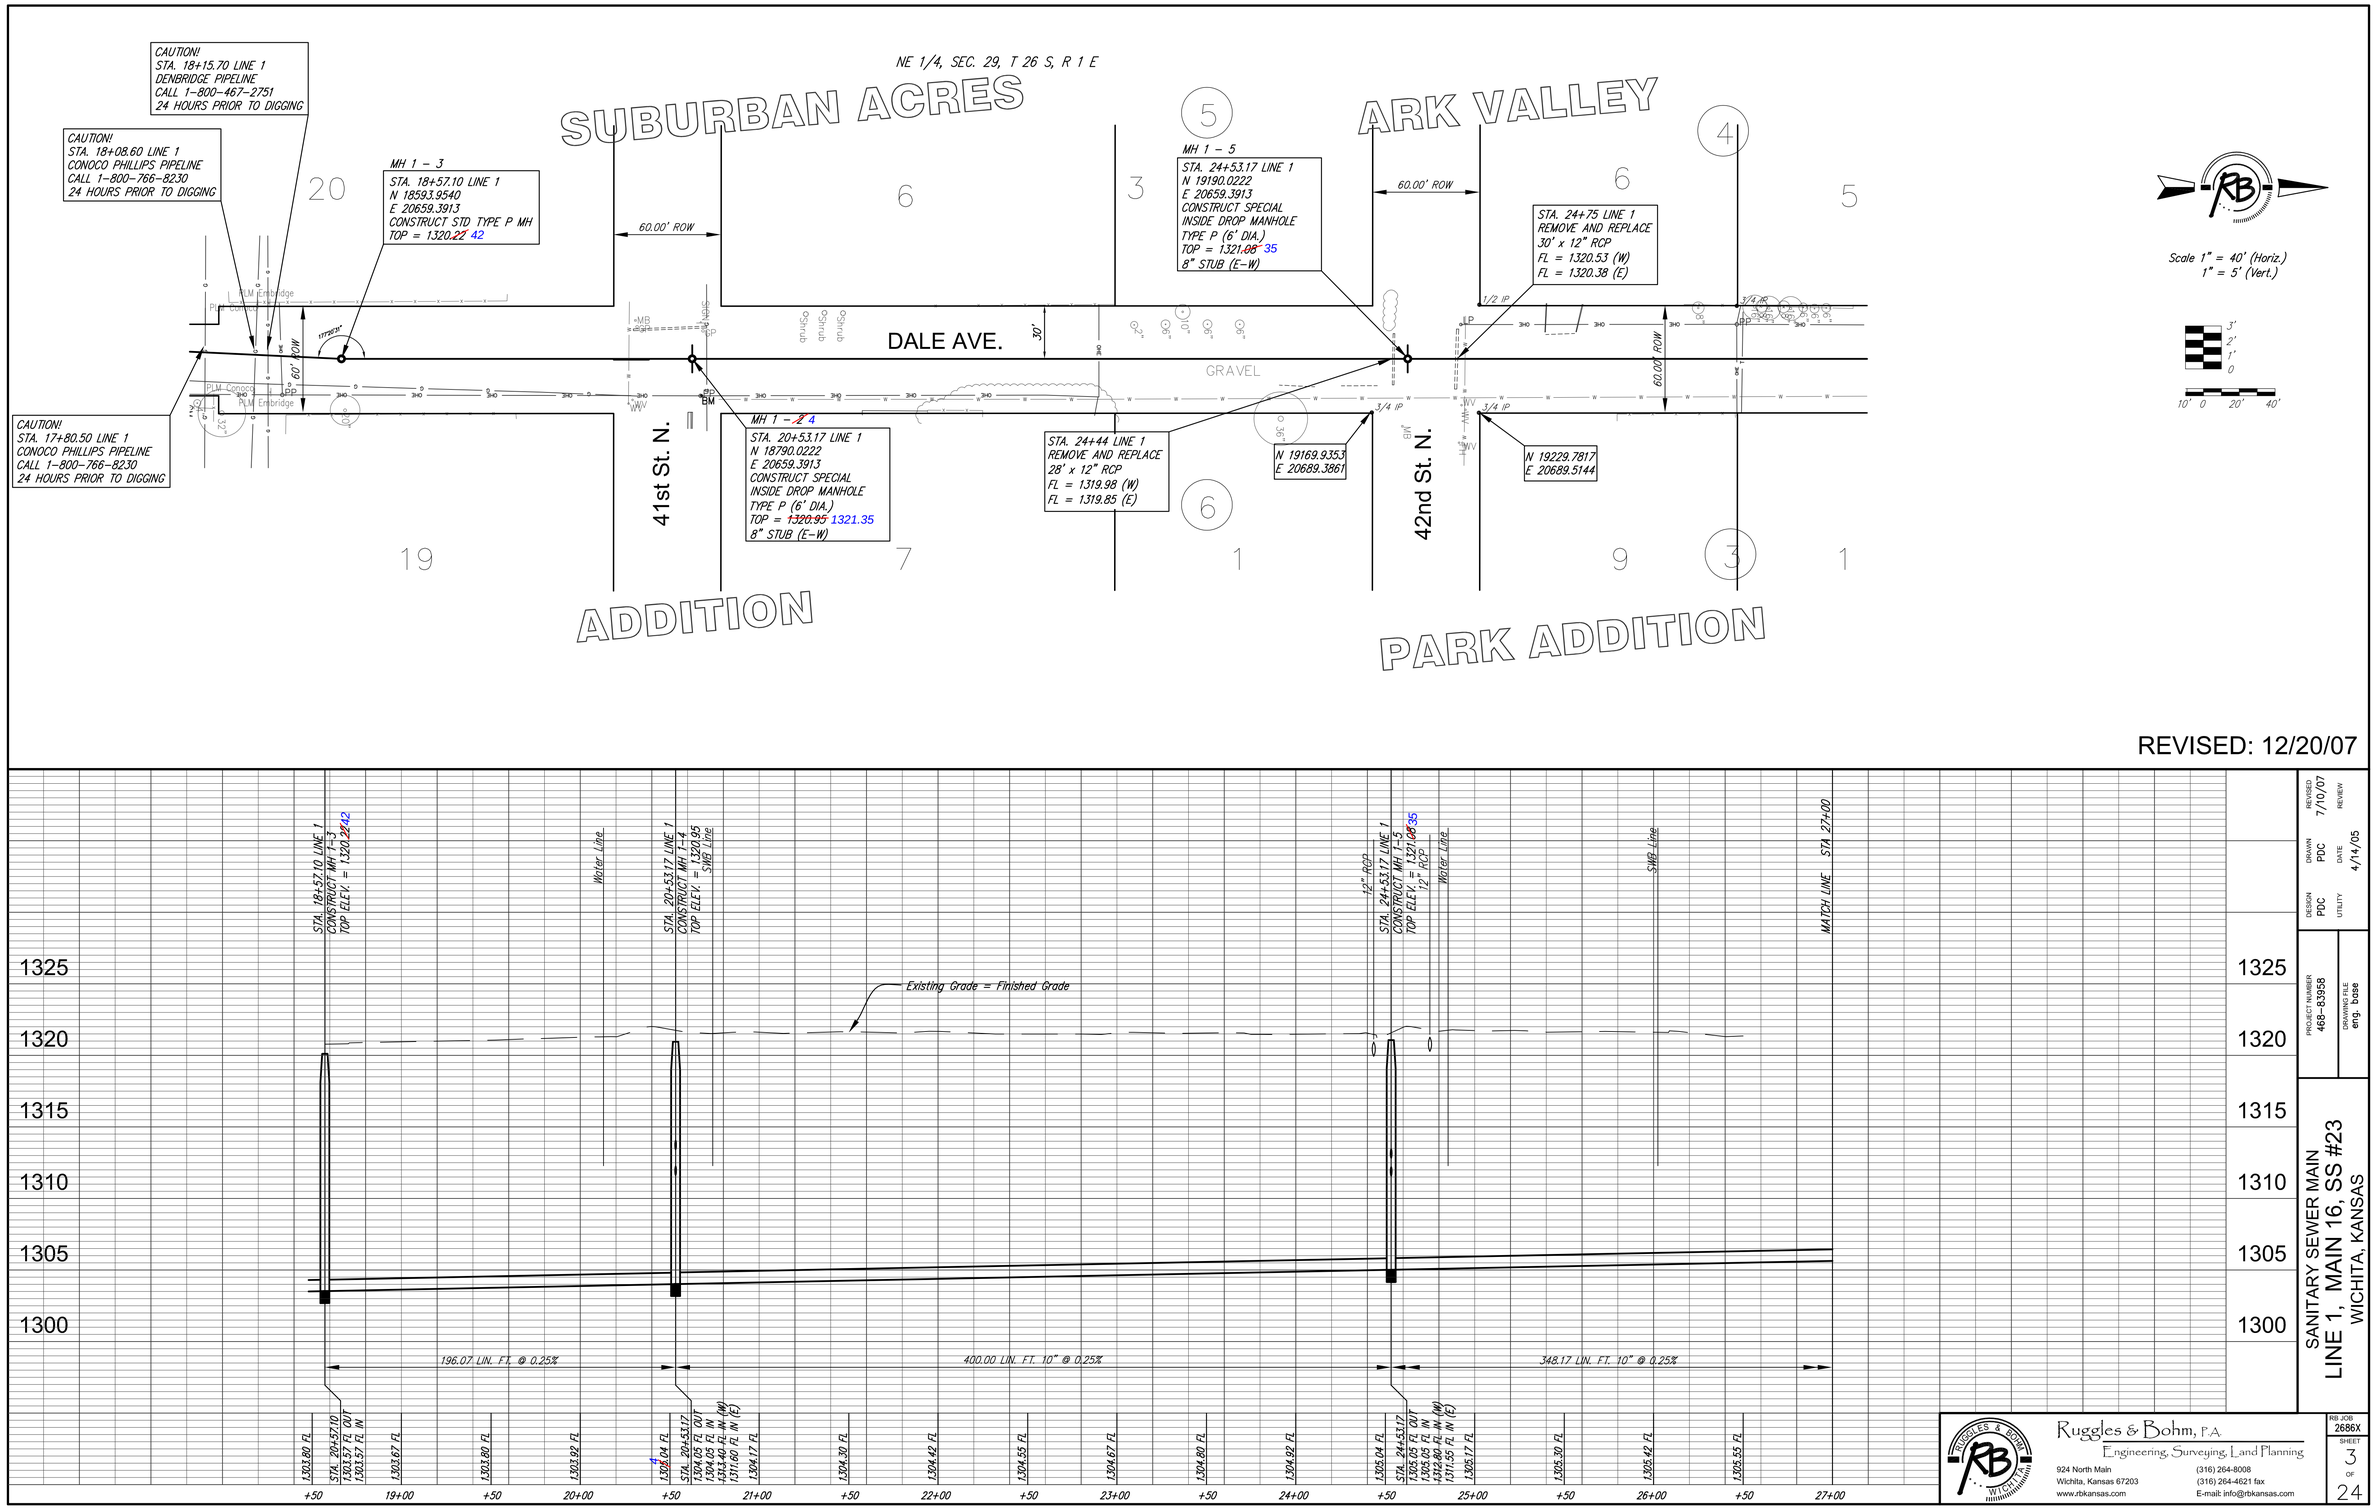

DESIGN PDC	DRAWN PDC
UTILITY	DATE 4/14/05
REVISED 7/10/07	REVIEW
PROJECT NUMBER 468-83958	DRAWING FILE eng. base

SANITARY SEWER MAIN
LINE 1, MAIN 16, SS #23
WICHITA, KANSAS

Ruggles & Bohm, P.A.
Engineering, Surveying, Land Planning
924 North Main
Wichita, Kansas 67203
www.rbkansas.com
(316) 264-8008
(316) 264-4621 fax
E-mail: info@rbkansas.com

RB JOB 2686X