



FORCE MAIN WARNING SIGN

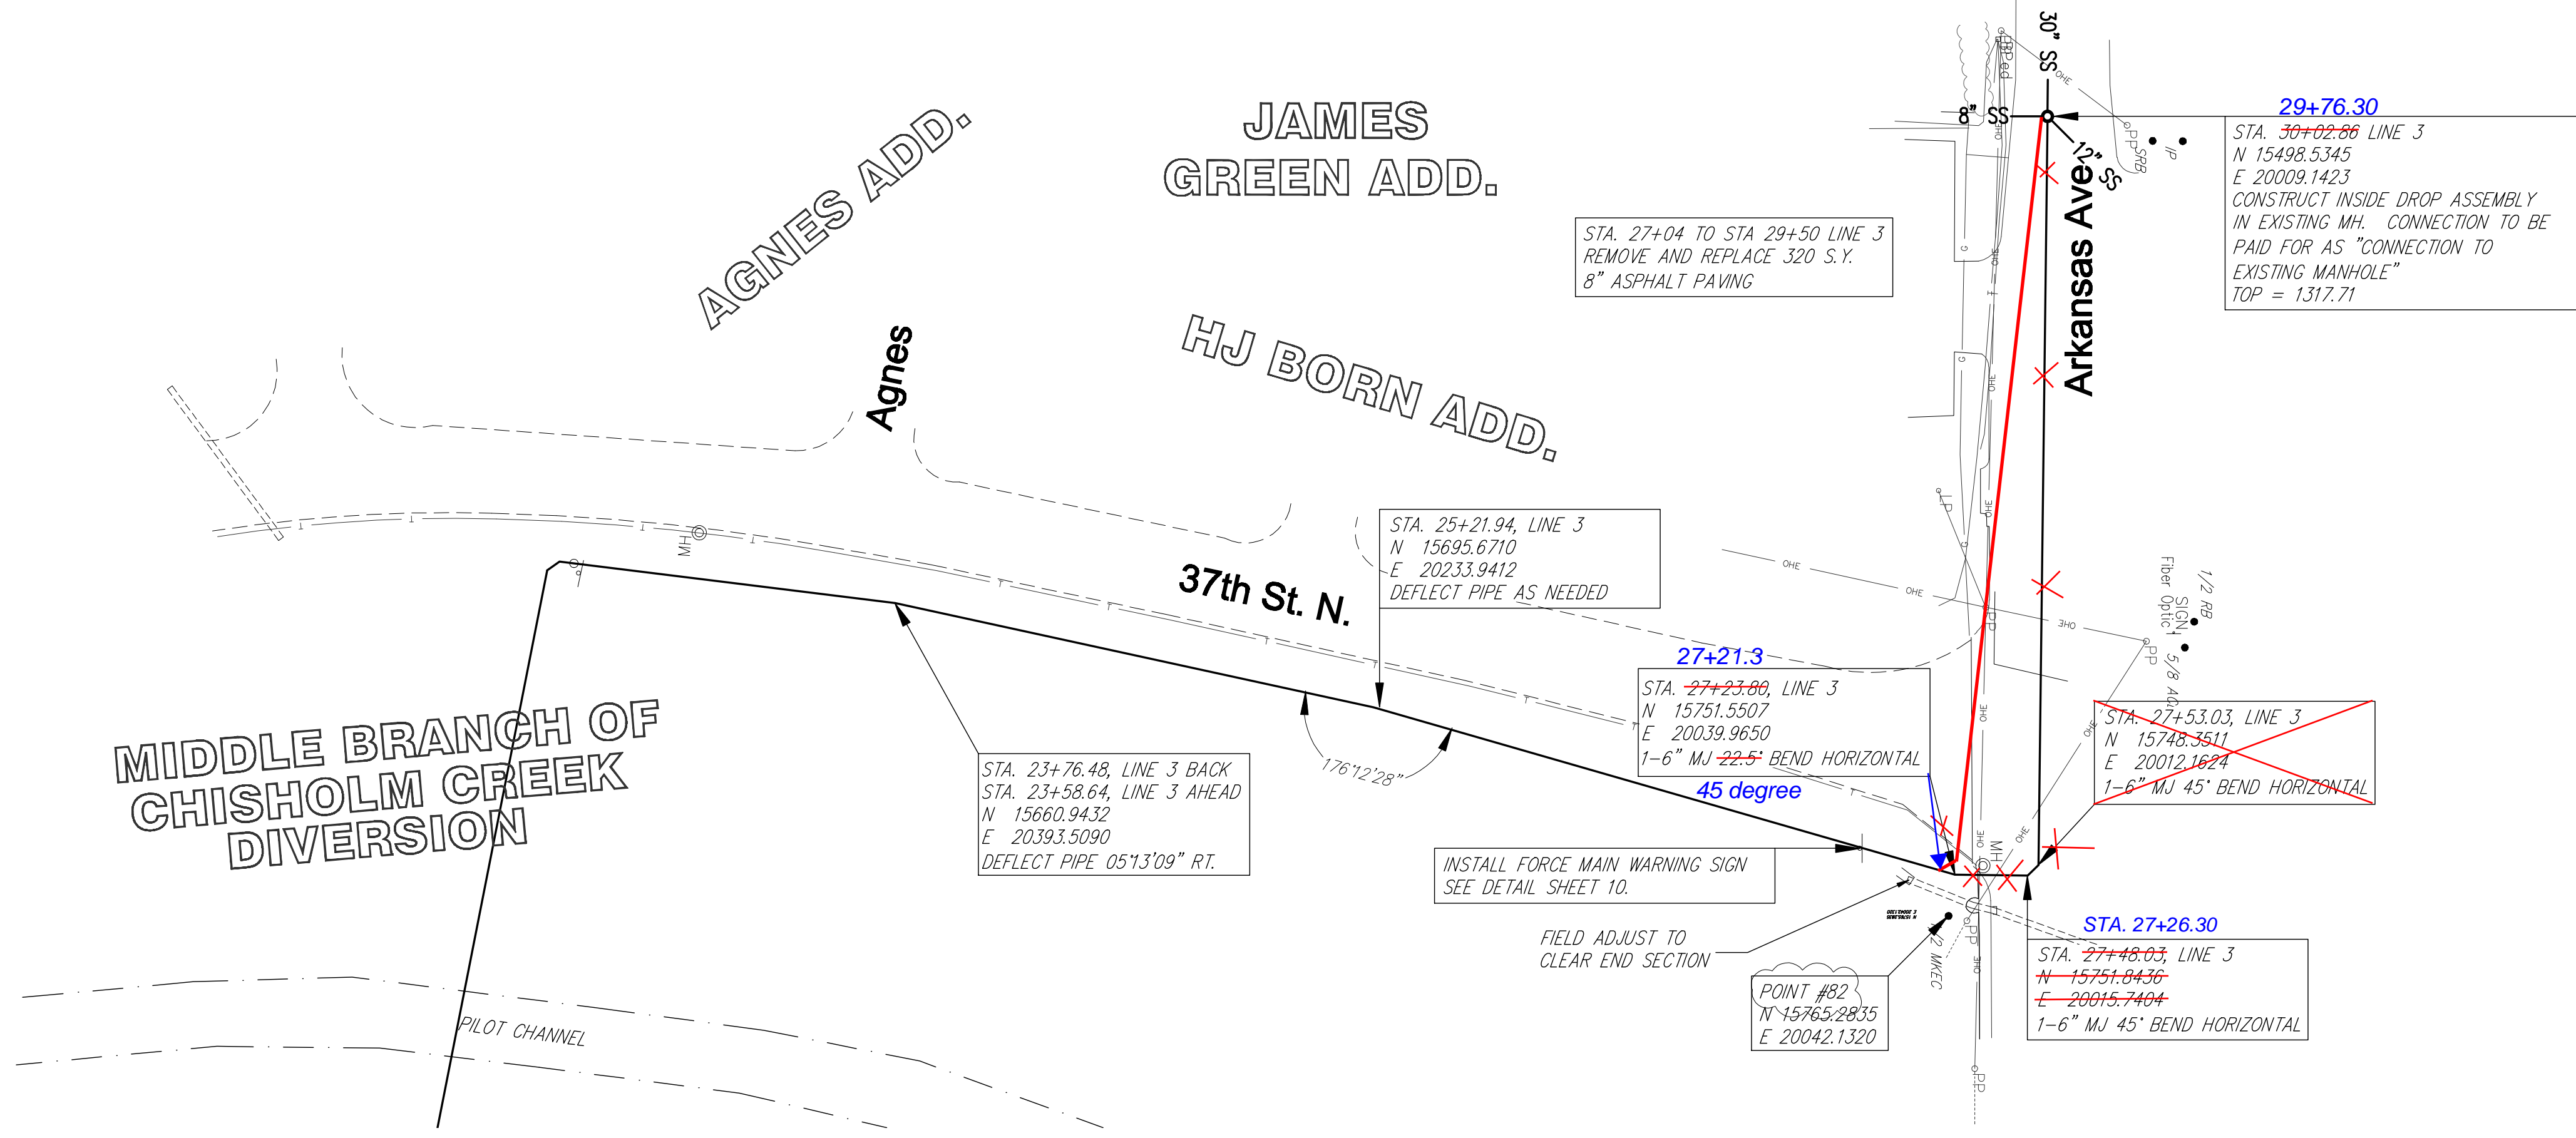

LINE 3 - FORCE MAIN

REVISED: 6/12/08
 REVISED: 12/31/07
 REVISED: 12/20/07

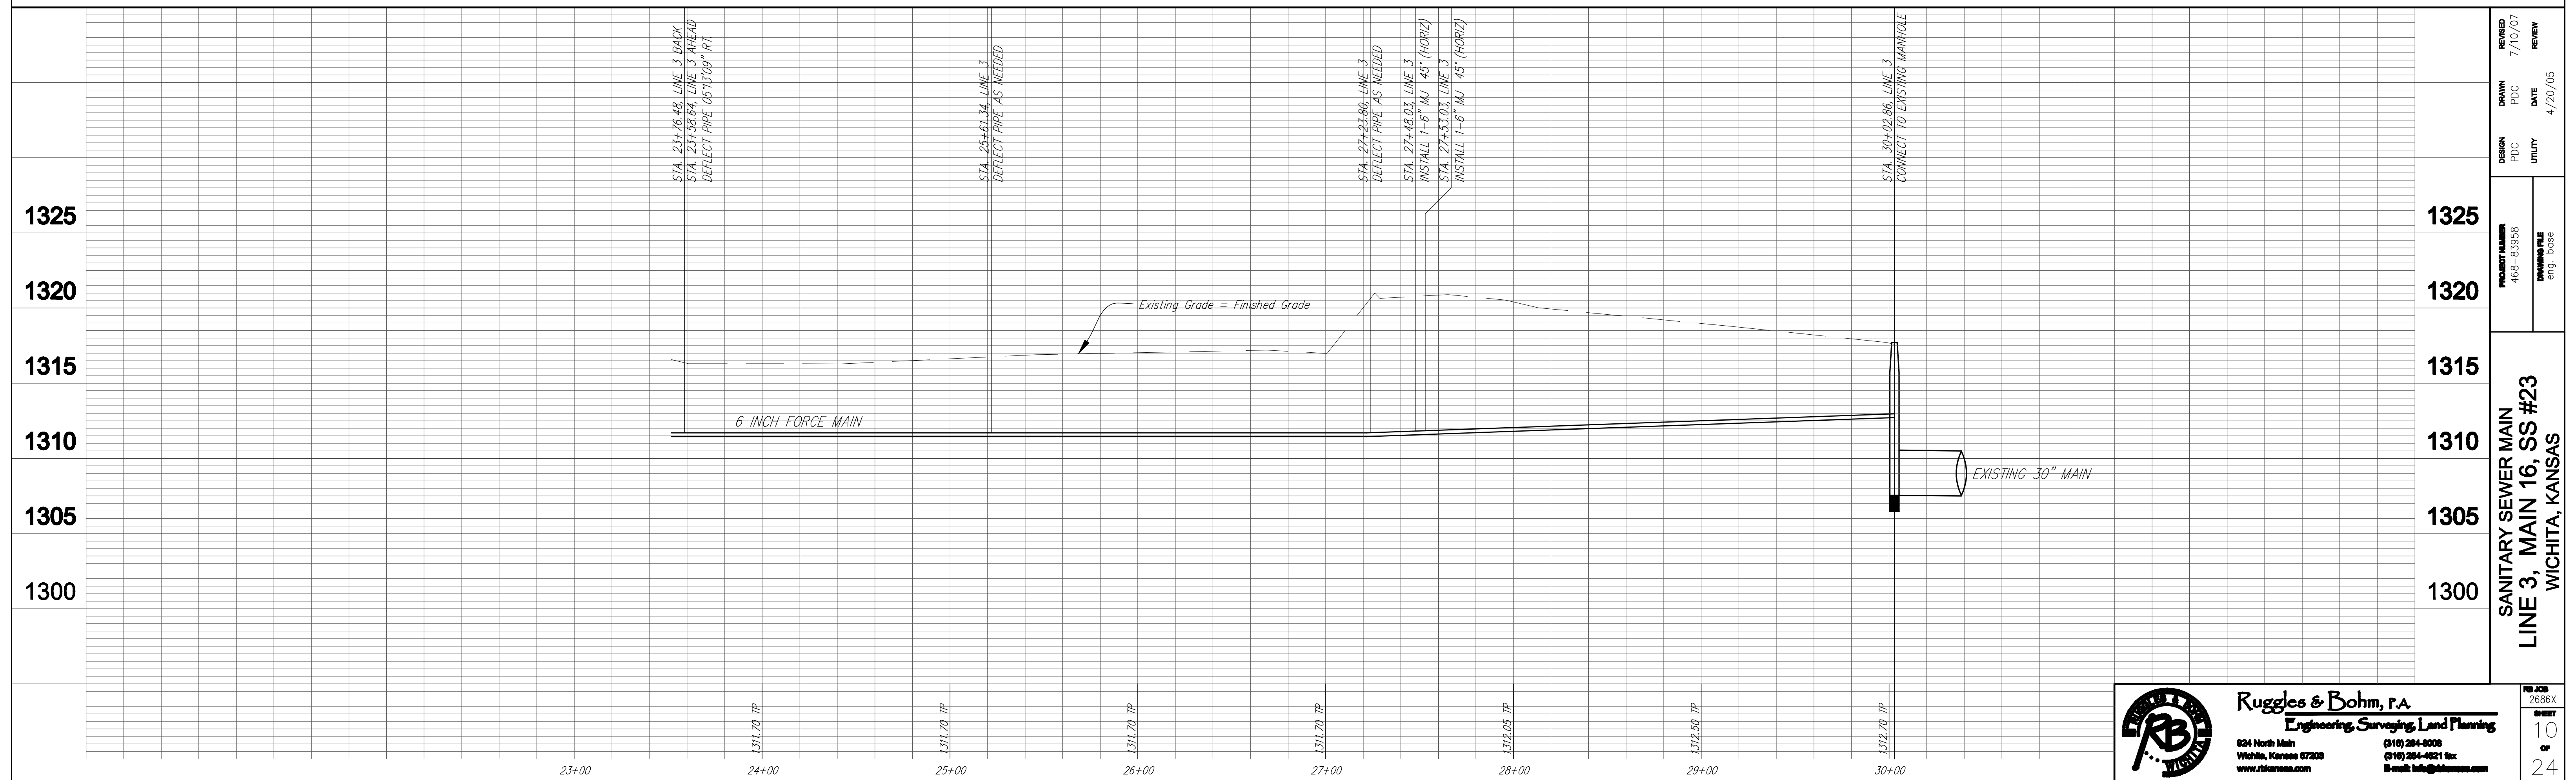

	Ruggles & Bohm, P.A. Engineering, Surveying, Land Planning 624 North Main Wichita, Kansas 67203 www.rbag.com	(316) 264-8000 (316) 264-4821 fax E-mail: info@rbag.com
	PROJECT NUMBER 468-83958 DRAWING FILE eng. usse	REVISIONS 10 9 24

REVISION	DATE	REVISION
DRAWN	PDC	DATE
DESIGN	PDC	UTILITY
PROJECT NUMBER	468-83958	DRAWING FILE
SANITARY SEWER MAIN LINE 3, MAIN 16, SS #23 WICHITA, KANSAS		