



**Benchmarks:**  
 BM #1: Small RR spike in 2nd PP north of K-42 Highway, west side of Maize Elev. = 1331.01 (M.S.L.)  
 BM #2: Small RR spike in PP east of East 1/4 Corner (G) Elev. = 1334.40 (M.S.L.)  
 BM #3: "□" Top Headwall southeast corner K-42 Highway and Maize (County BM with City Datum Elev. = 1331.44 (M.S.L.)

SCALE:  
 1" = 40' HORIZONTAL  
 1" = 5' VERTICAL  
 ● = IRON

**SEWER SERVICE TABLE**

NUMBER	TYPE	LOCATION			OWNER	STATION \ DIRECTION	FOR INFORMATION ONLY		
		LOT	BLOCK	LINE			APPROXIMATE LENGTH 4" PIPE		
1	8" X 4" Tee	1319	4	1	Fugate, Patrick	21+96.27/Rt.	21+79.27/Rt.	9'	11'
2	8" X 4" Tee	18	4	1	Kester, Dwayne L. & Colleen D Strait Attn: Patrick J. Stevens & LI	22+12.61/Lt.		9'	10'
3	8" X 4" Tee	16	4	1	Silvers, Lucretia A.	22+42.61/Lt.		8'	10'
4	8" X 4" Tee	11	4	1	Milner, Daniel	24+13/Rt.	22+97.27/Rt.	8'	11'
5	8" X 4" Tee	19	3	1	Hamilton, Billy H. & Virginia F.	25+52.28/Rt.		6'	10'
6	8" X 4" Tee	18	3	1	Hamilton, Billy H. & Virginia F.	25+77.62/Lt.	25+62.62/Lt.	6'	11'
7	8" X 4" Tee	N/A	N/A	1A	Fugate, Patrick	1+50.52/Lt.		9'	15'
8	8" X 4" Tee	N/A	N/A	1A	Kester, Dwayne L. & Colleen D Strait Attn: Patrick J. Stevens & LI	3+21.68/Lt.		9'	15'
9	8" X 4" Tee	N/A	N/A	1A	Silvers, Lucretia A.	3+53.51/Lt.		9'	15'
10	8" X 4" Tee	N/A	N/A	1A	Milner, Daniel	4+87.05/Lt.		8'	16'
11	8" X 4" Tee	N/A	N/A	1A	Hamilton, Billy H. & Virginia F.	8+70.06/Rt.		7'	15'
12	8" X 4" Tee	N/A	N/A	1A	Hamilton, Billy H. & Virginia F.	9+02.59/Lt.		7'	10'
13	8" X 4" Tee	13	2	1B		1+62.14/Lt.		9'	18'
14	8" X 4" Tee	7	2	1B		2+32.13/Lt.		8'	18'
15	8" X 4" Tee	23	1	1B		3+91.62/Lt.		7'	19'

NOTE: Vertical Riser Pipe shall be extended to 2' minimum above ground water elevation and 4' maximum below proposed ground elevation.

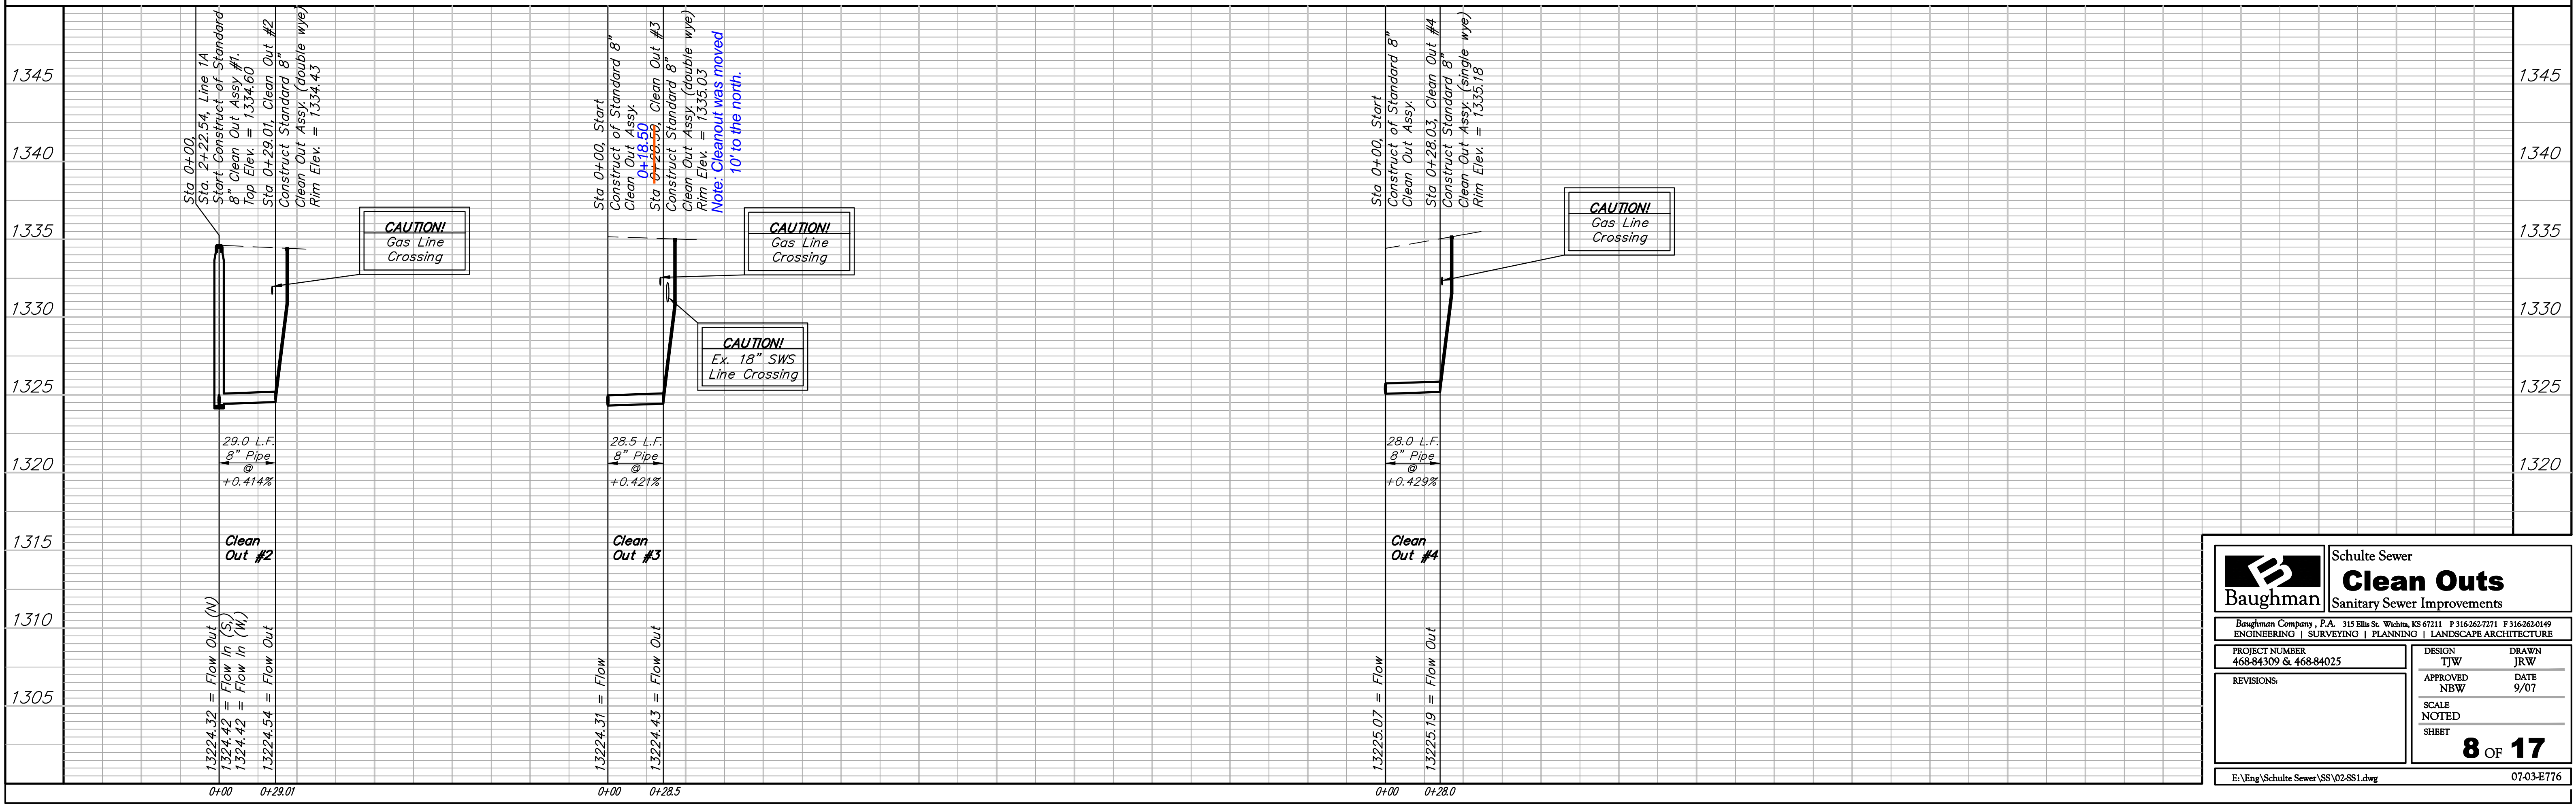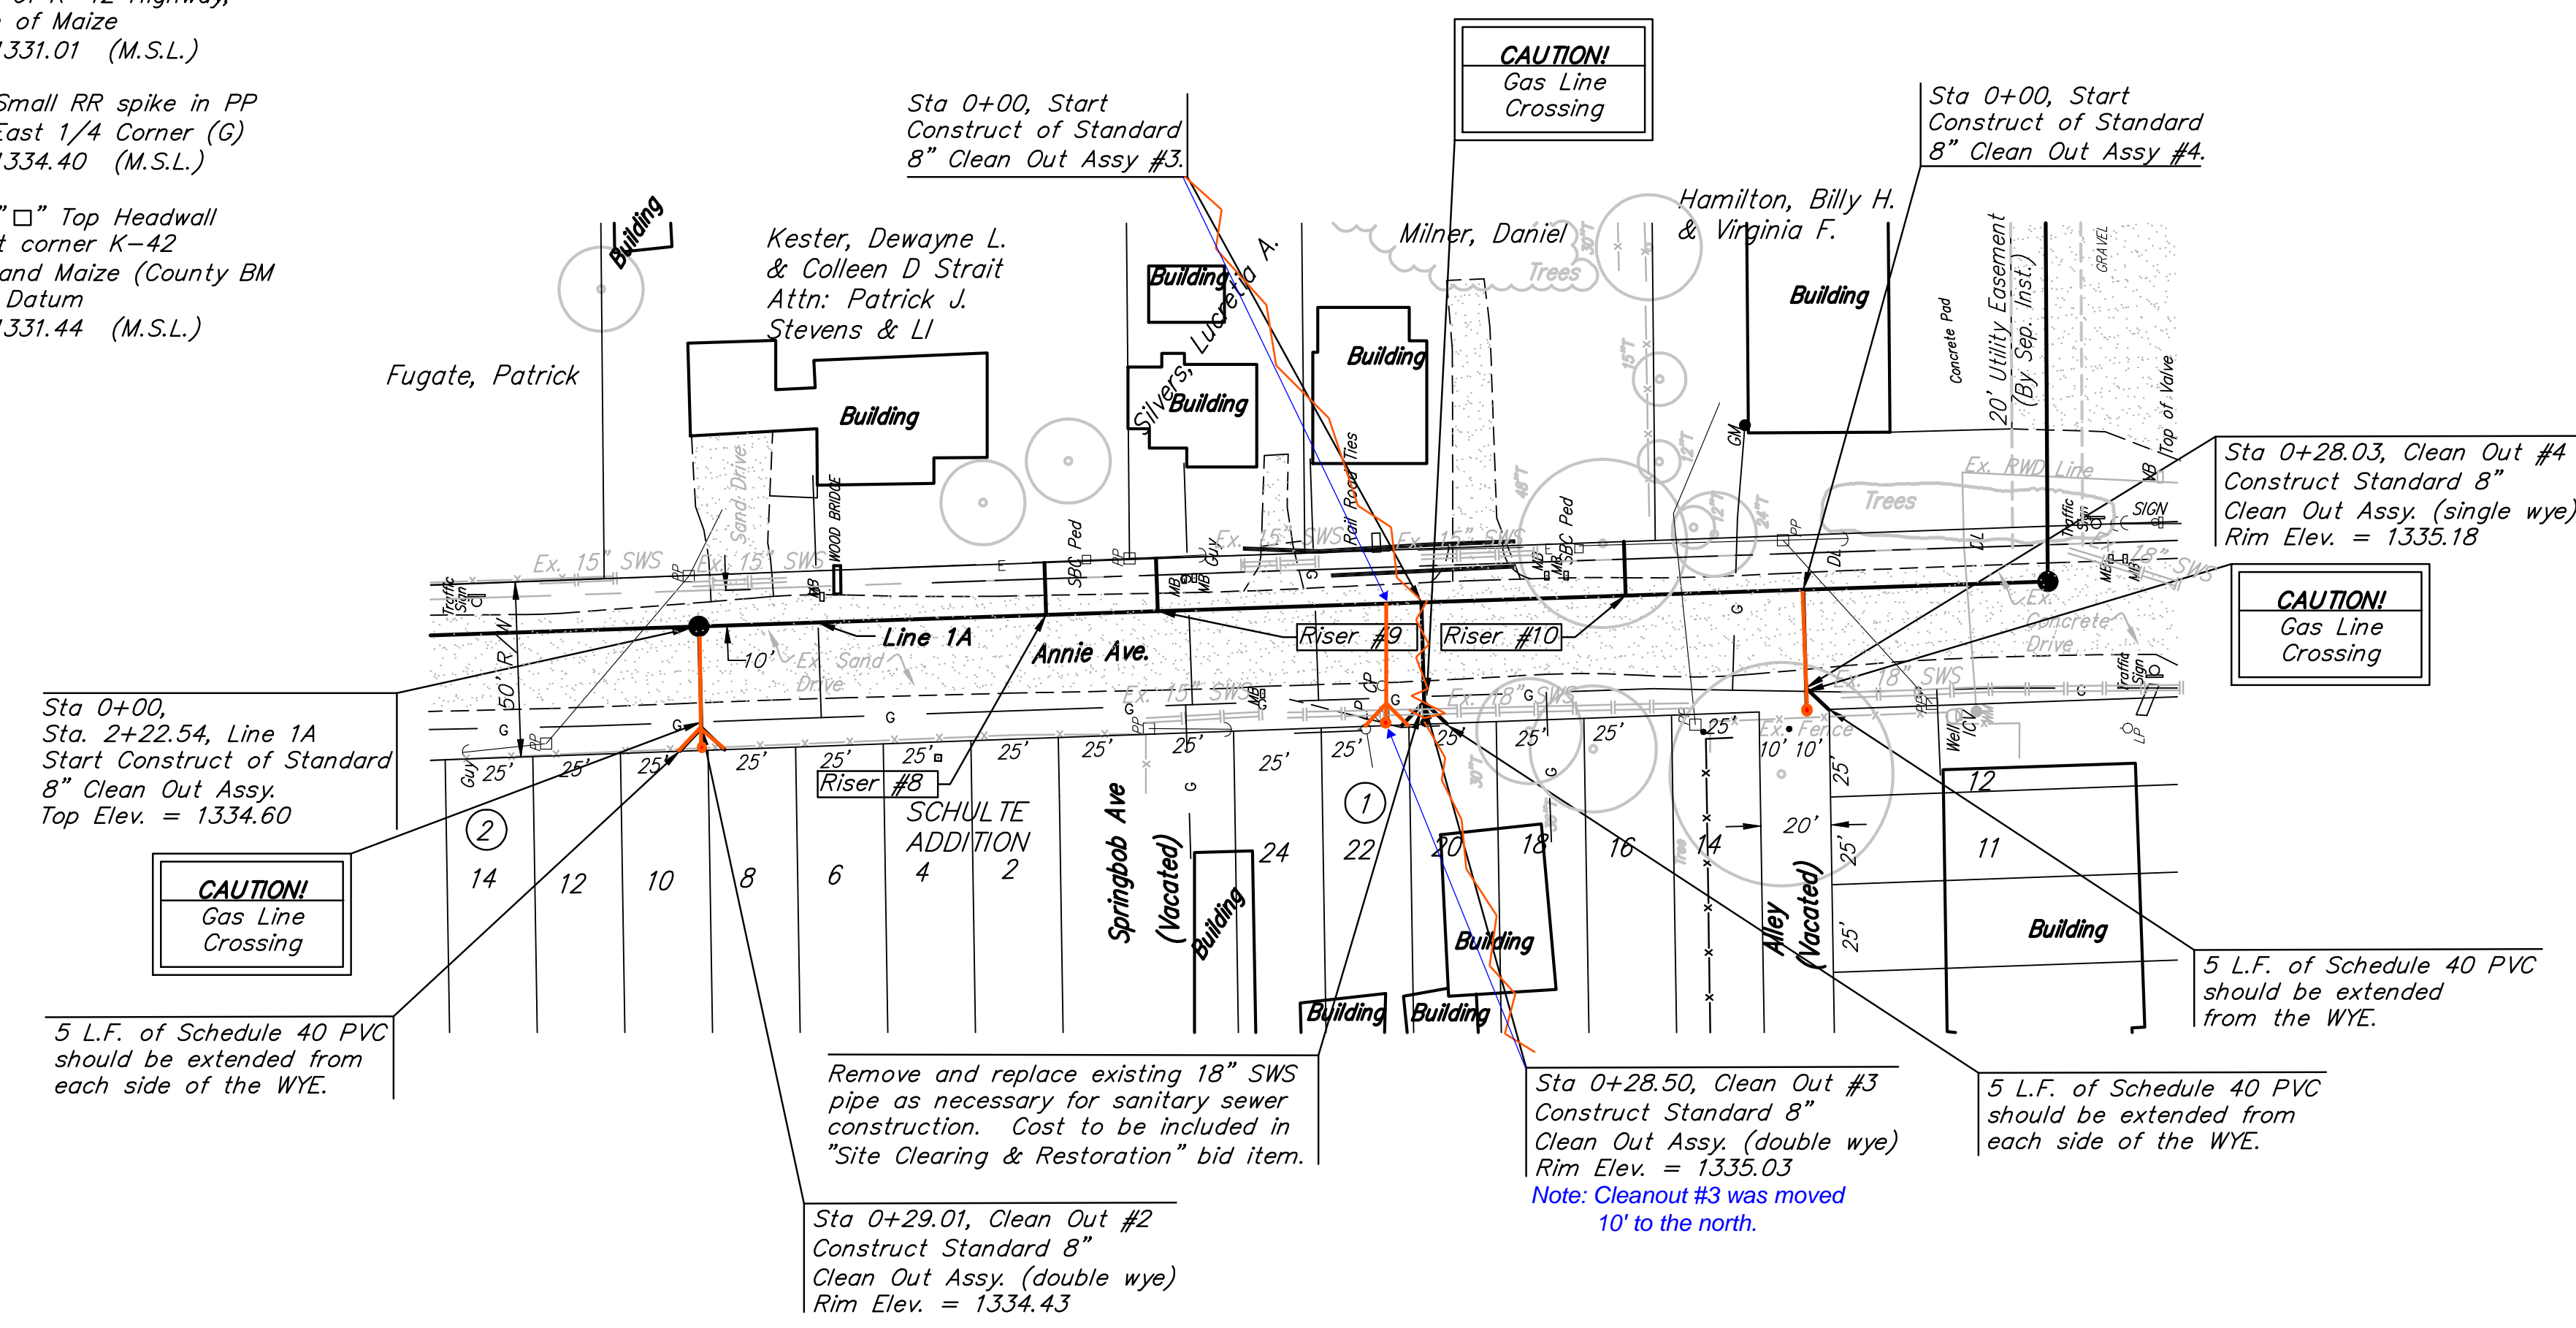

**Baughman** Schulte Sewer  
**Clean Outs**  
 Sanitary Sewer Improvements

Baughman Company, P.A. 315 Ellis St. Wichita, KS 67211 P 316-262-7271 F 316-262-0149  
 ENGINEERING | SURVEYING | PLANNING | LANDSCAPE ARCHITECTURE

PROJECT NUMBER: 468-84309 & 468-84025  
 DESIGN: TJW  
 DRAWN: JRW  
 APPROVED: NBW  
 DATE: 9/07

REVISIONS:

SCALE: NOTED  
 SHEET: **8 OF 17**

E:\Eng\Schulte Sewer\SS\02-SS1.dwg 07-03-E776