


TRACT 205-3 (Revised)

May 31, 2005

Lot 1
Sharon Ryan Addn.
City of Wichita, Sedgwick County, Kansas



J:\00011ph2\TRACT MAPS\205-3.dwg 6/1/2005 8:18:44 AM CDT

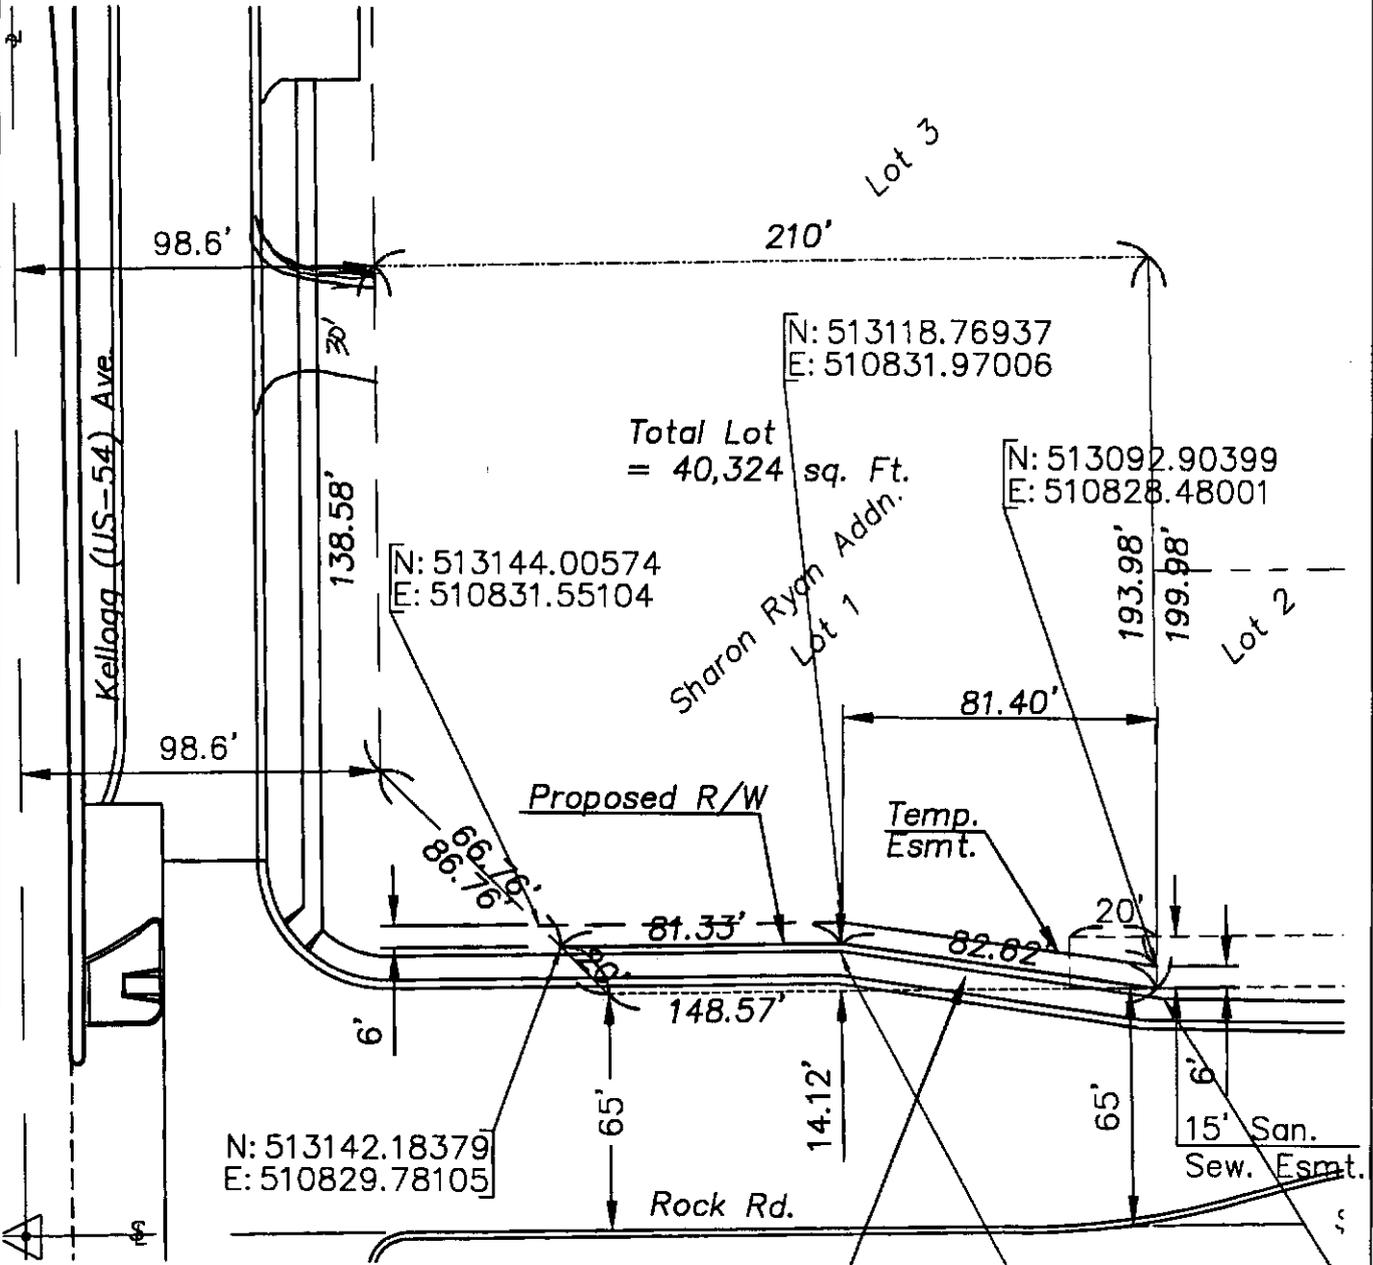

Total Lot = 40,324 sq. Ft.

N: 513142.18379
E: 510829.78105

N: 513118.76937
E: 510831.97006

N: 513092.90399
E: 510828.48001

N: 513144.00574
E: 510831.55104

N: 513092.35239
E: 510825.77537

N: 513118.91304
E: 510829.56734

Partial Take
1,623 sq. ft.

City of Wichita



Cook, Flatt & Strobel
ENGINEERS, P.A.