
TRACT 205–3 (Revised)

May 31, 2005

Lot 1
Sharon Ryan Addn.
City of Wichita, Sedgwick County, Kansas

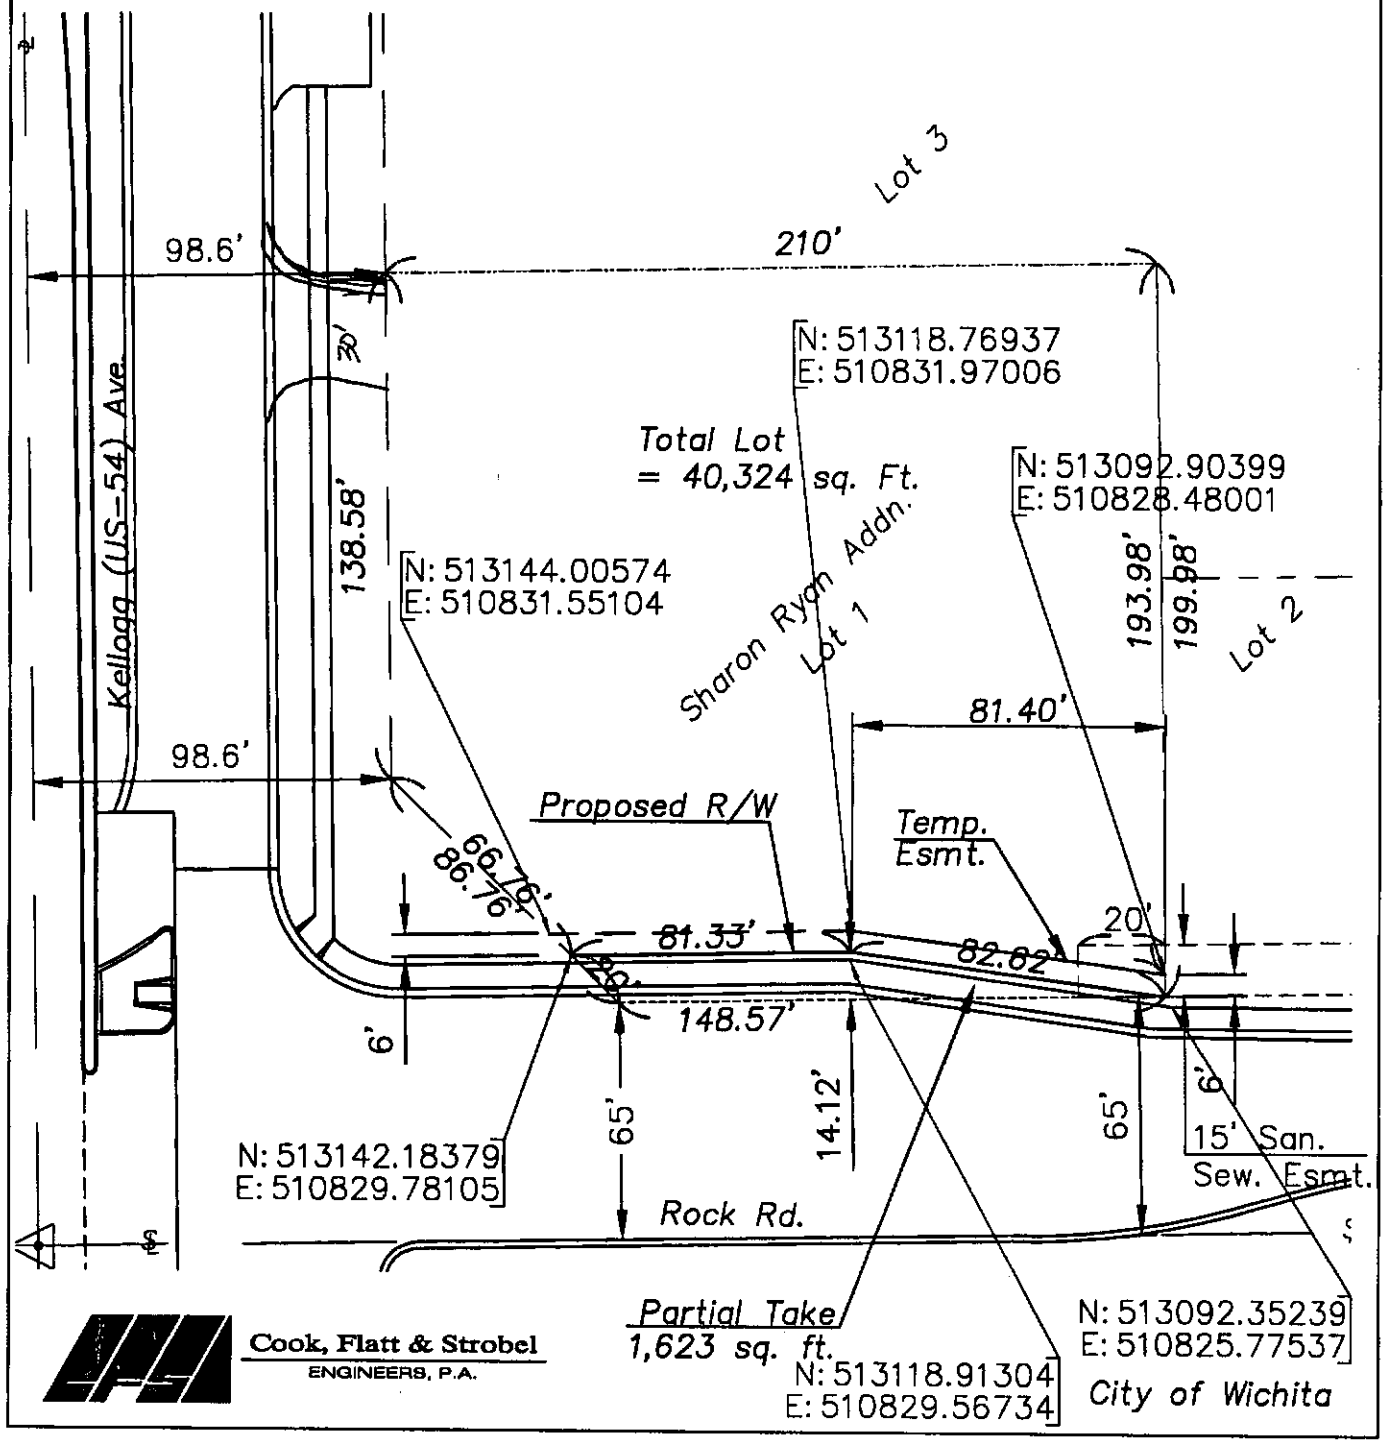


Cook, Flatt & Strobel
ENGINEERS, P.A.

J:\00011ph2\TRACT MAPS\205-3.dwg 6/1/2005 8:18:44 AM CDT