



Bellechase 2nd Addition

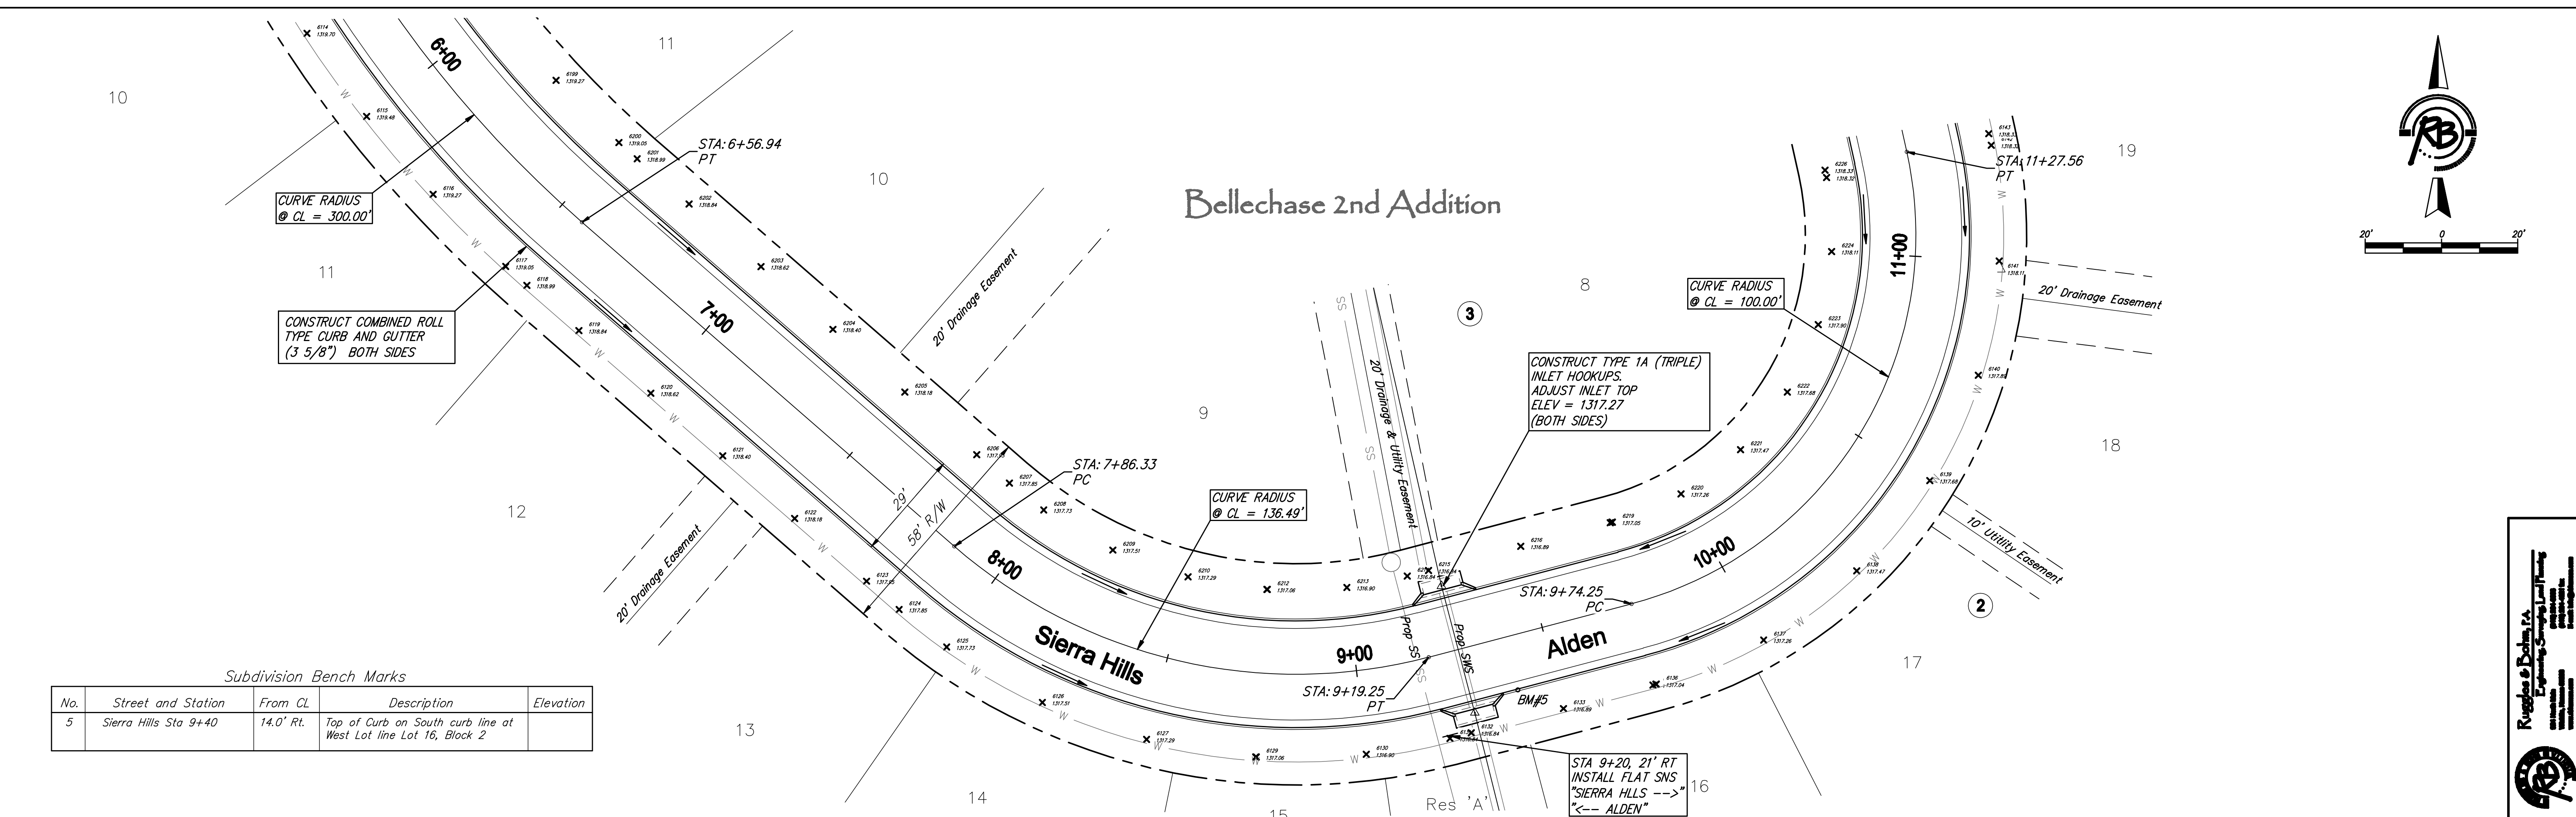

Subdivision Bench Marks

No.	Street and Station	From CL	Description	Elevation
5	Sierra Hills Sta 9+40	14.0' Rt.	Top of Curb on South curb line at West Lot line Lot 16, Block 2	

Ruggles & Babin, P.A.

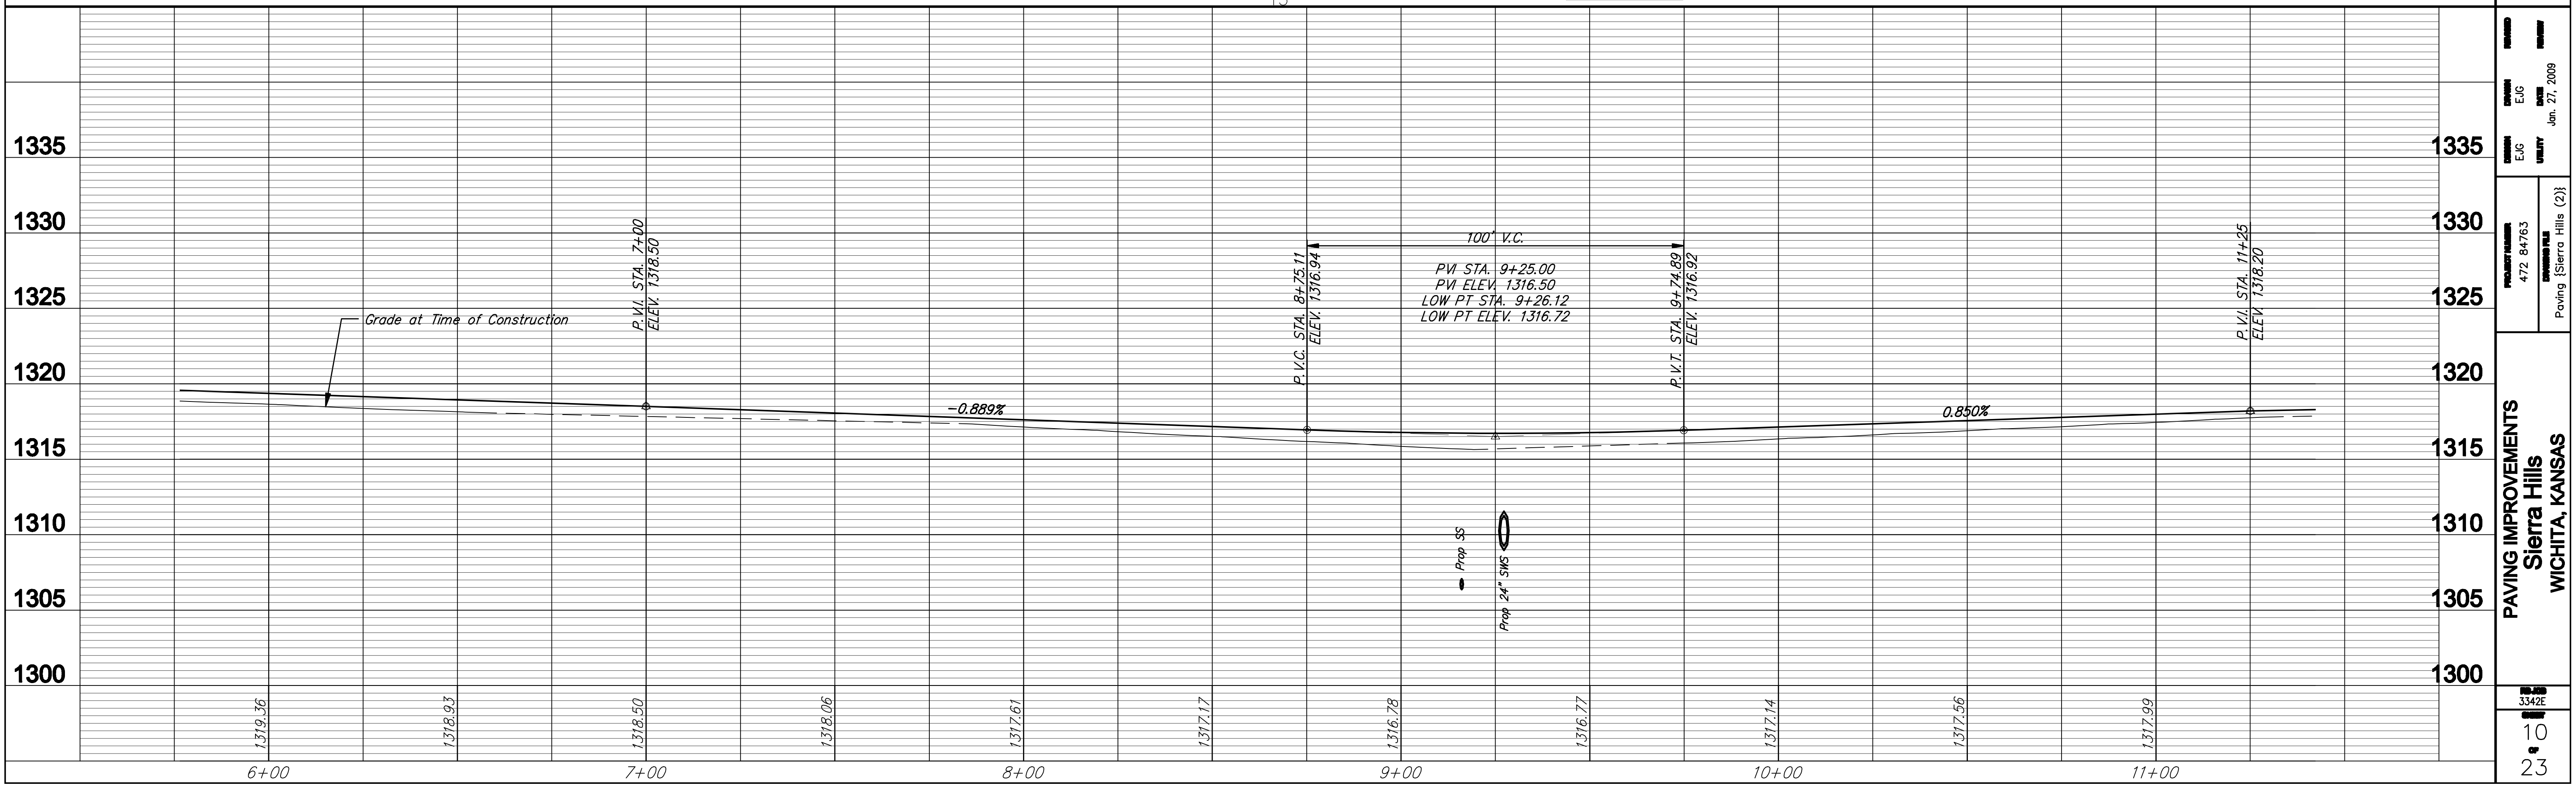

PAVING IMPROVEMENTS
Sierra Hills
WICHITA, KANSAS

PROJECT NUMBER: 472-84763
 DRAWING TITLE: PAVING [Sierra Hills (2)]
 DATE: Jan. 27, 2009

3342E
 10
 23