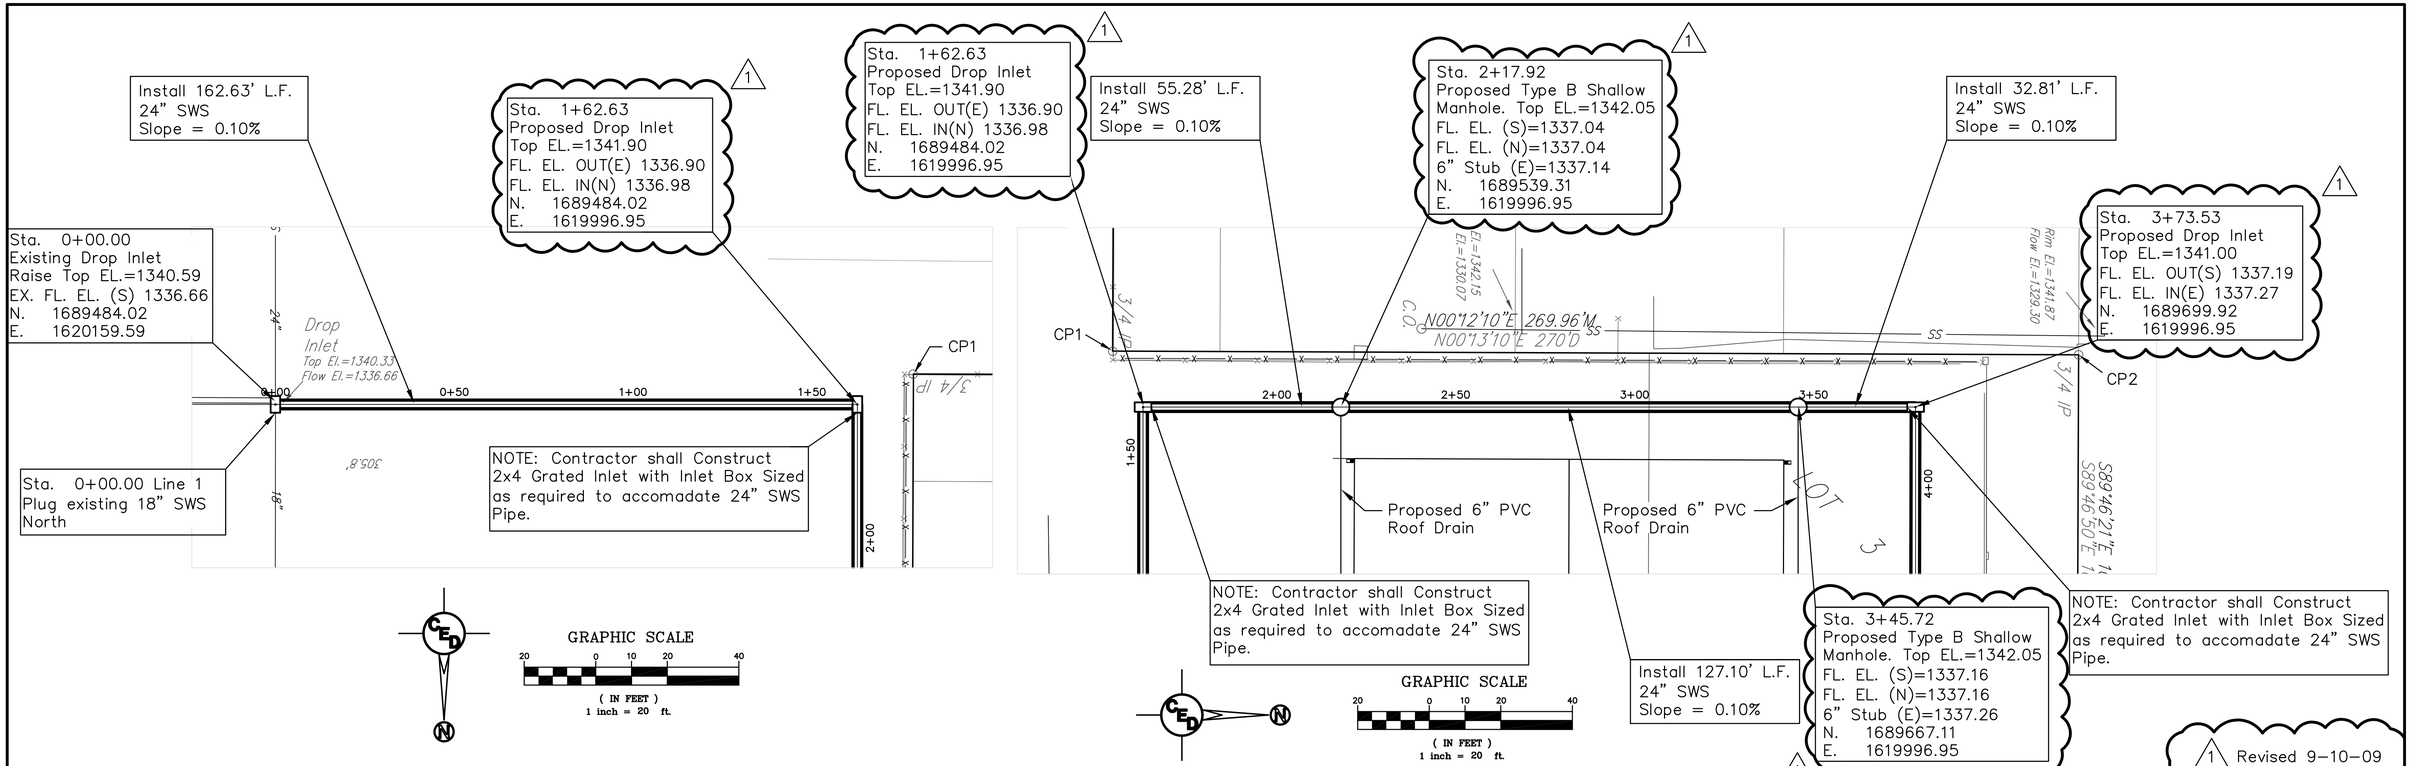

SWS LINE 1

SWS LINE 1

NOTE:
SEE SHEET 2 FOR LEGEND

SURVEY DISCLAIMER:
TOPOGRAPHIC SURVEY AND CONTOUR MAP USED IN PREPARING PLANS WAS PROVIDED BY SAVOY COMPANY, P.A., 535 S. EMPORIA, SUITE 104, WICHITA, KS. ENGINEER DOES NOT GUARANTEE SURVEY ELEVATIONS FOR ACCURACY. CONTRACTOR SHALL VERIFY ELEVATIONS AND NOTIFY ENGINEER OF ANY DISCREPANCIES.

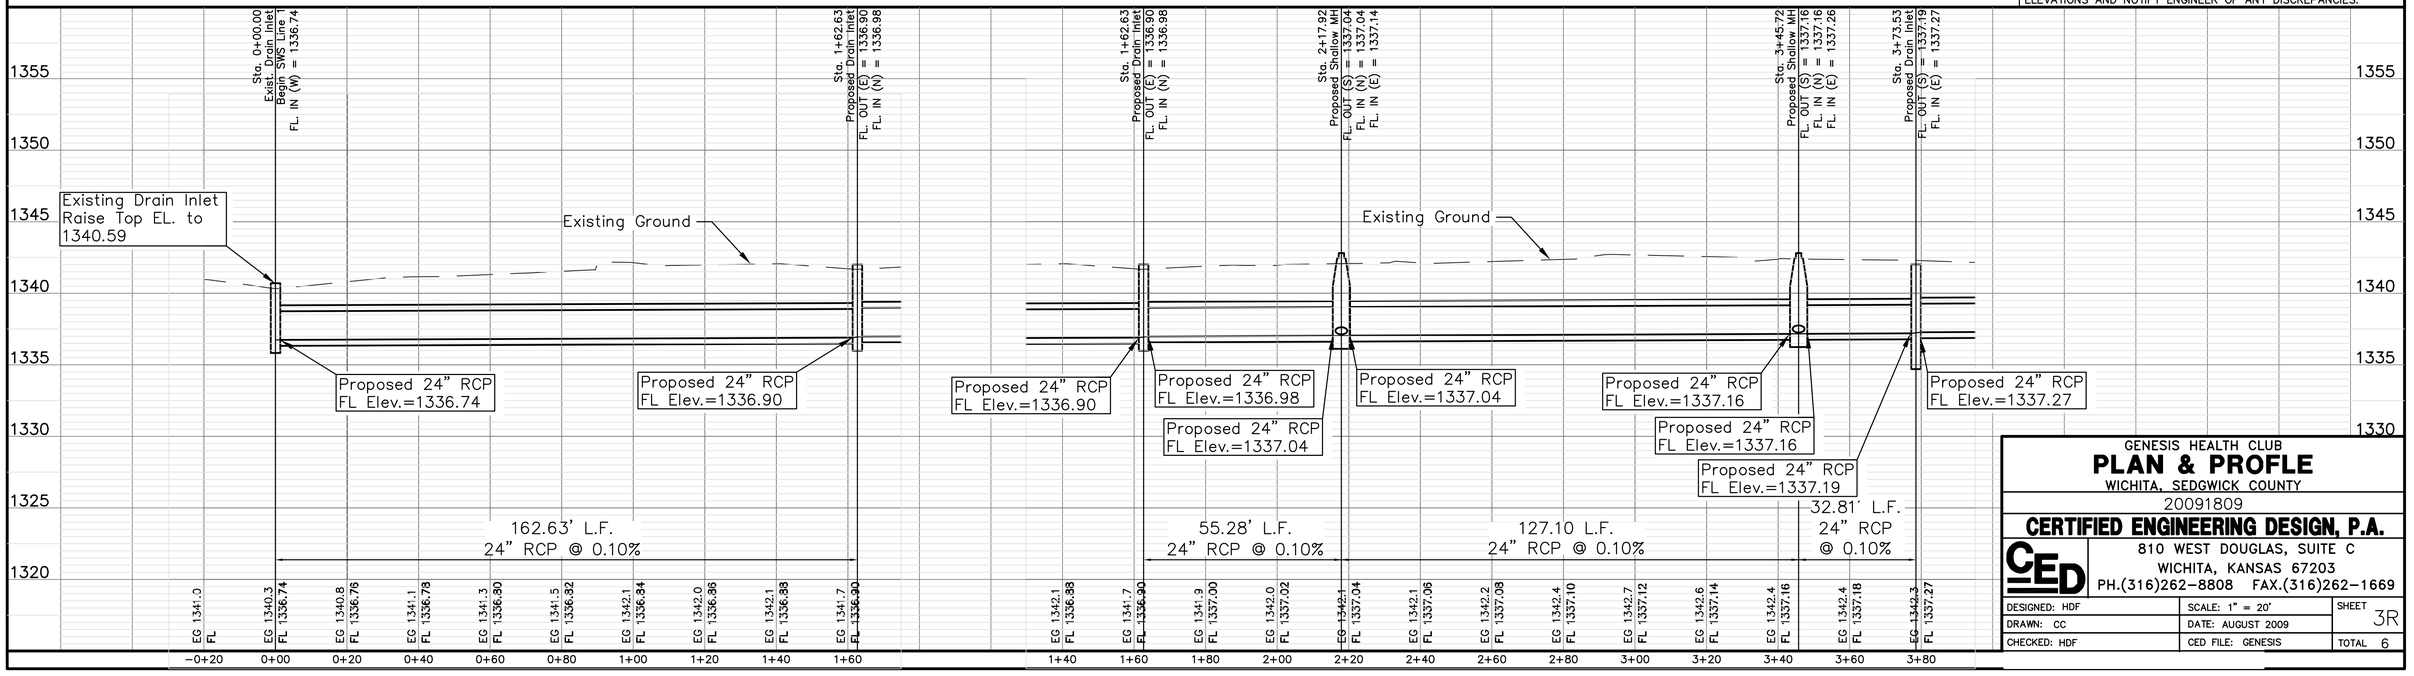

GENESIS HEALTH CLUB
PLAN & PROFILE
WICHITA, SEDGWICK COUNTY
20091809

CERTIFIED ENGINEERING DESIGN, P.A.
810 WEST DOUGLAS, SUITE C
WICHITA, KANSAS 67203
PH.(316)262-8808 FAX.(316)262-1669

DESIGNED: HDF	SCALE: 1" = 20'	SHEET 3R
DRAWN: CC	DATE: AUGUST 2009	
CHECKED: HDF	CED FILE: GENESIS	TOTAL 6