




FIRE PROTECTION LINE
 SCALE: 1" = 40' HORIZ.
 1" = 5' VERT.

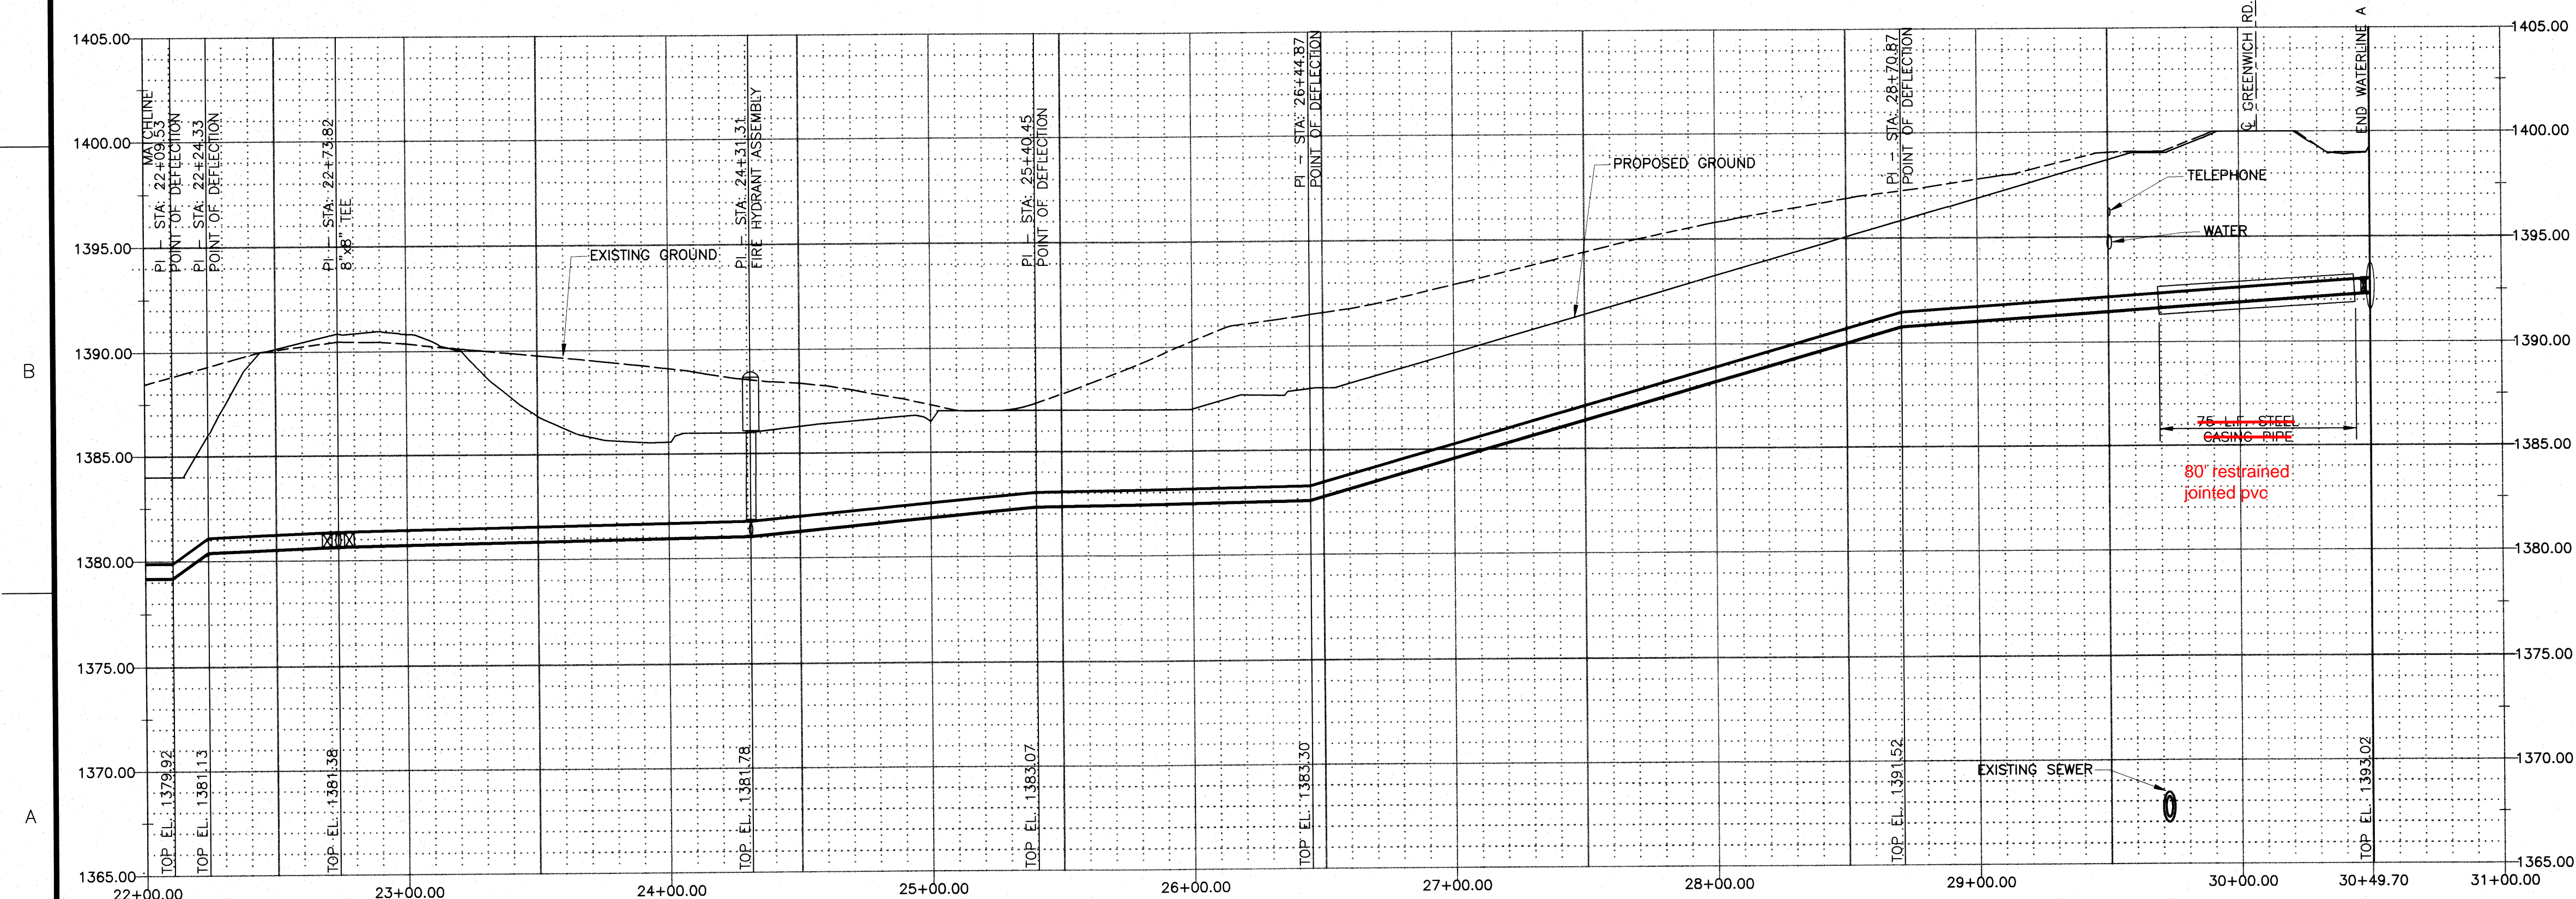


FIRE PROTECTION LINE
 SCALE: 1" = 40' HORIZ.
 1" = 5' VERT.

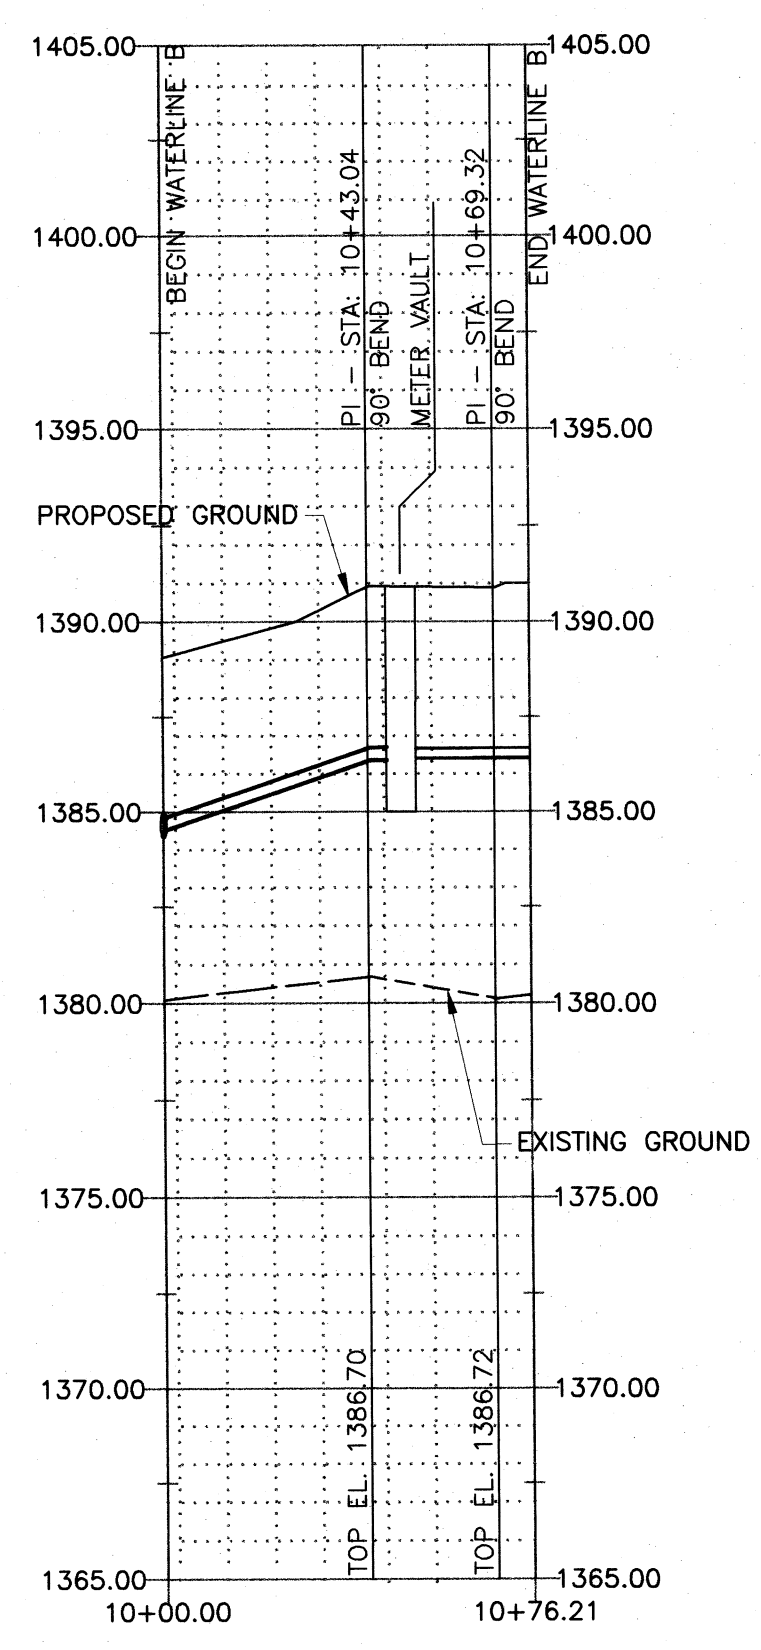

DOMESTIC SERVICE LINE
 SCALE: 1" = 40' HORIZ.
 1" = 5' VERT.

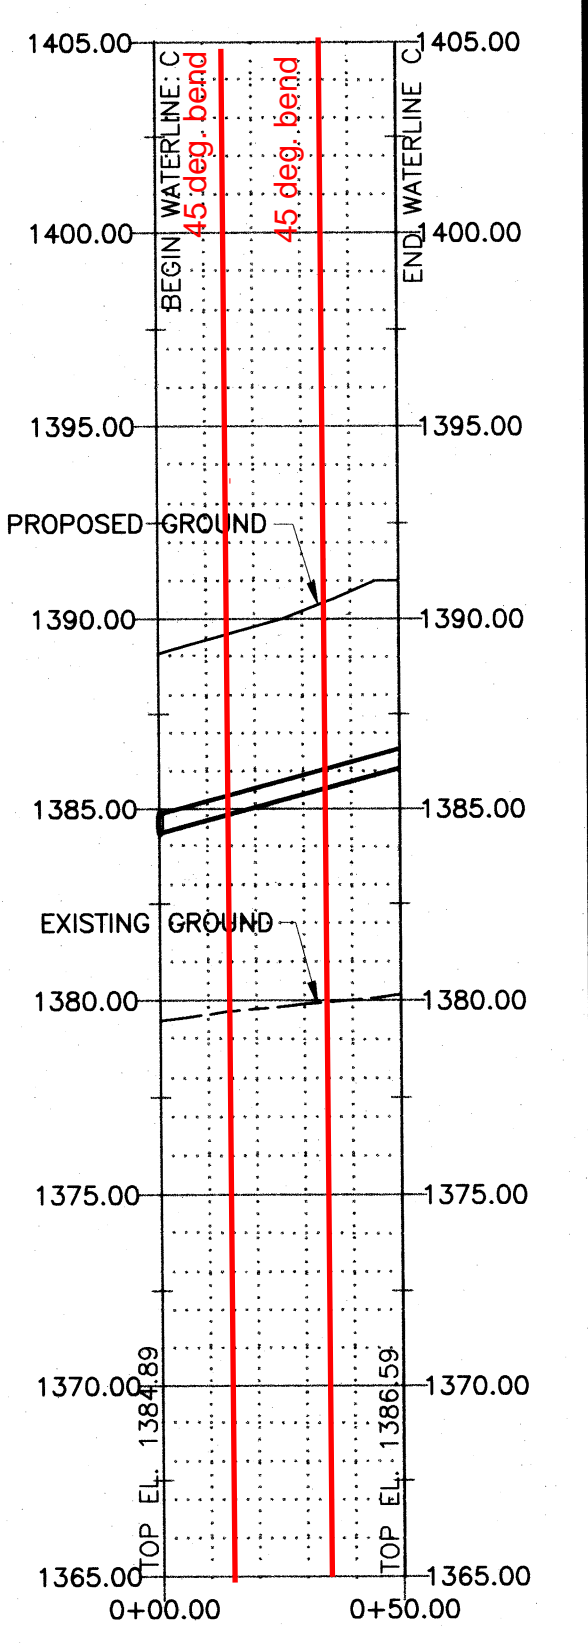

FIRE SERVICE LINE
 SCALE: 1" = 40' HORIZ.
 1" = 5' VERT.

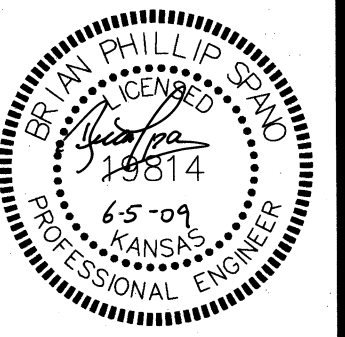

REVISIONS PER CITY OF WICHITA REVIEW

WILSON & COMPANY
 Engineers & Architects
 1700 East Iron - Salina, Kansas 67401
 Tel 785 - 827-0433 Fax 785 - 827-5949

FACILITY IMPROVEMENTS
CIRCLE UNIFIED SCHOOL DISTRICT U.S.D. NO 375
GREENWICH ROAD
NEW ELEMENTARY SCHOOL

DESIGN	DAG
DRAWN	TMH
DATE	July 09
FILE NO.	08-500-037-00

SHEET NO.
C 2.3