




BENCHMARKS

BM #1 - "□" Chiseled on Top of Curb Approx. 15' West and 2' South of SW Property Corner.
Elev. = 1275.95 NAVD 88.

BM #2 - "□" Chiseled on Top of Curb Approx. 5' East and 26.5' North of NE Property Corner.
Elev. = 1274.75 NAVD 88.

Contractor Shall Follow All Applicable Best Management Practices (BMP) For Erosion Control.

Contractor To Use Extreme Caution When Excavating Near Utility Lines. Contractor To Hand Dig To Expose All Utility Lines Prior To Construction. Verify Depth To Determine Conflict If Any.

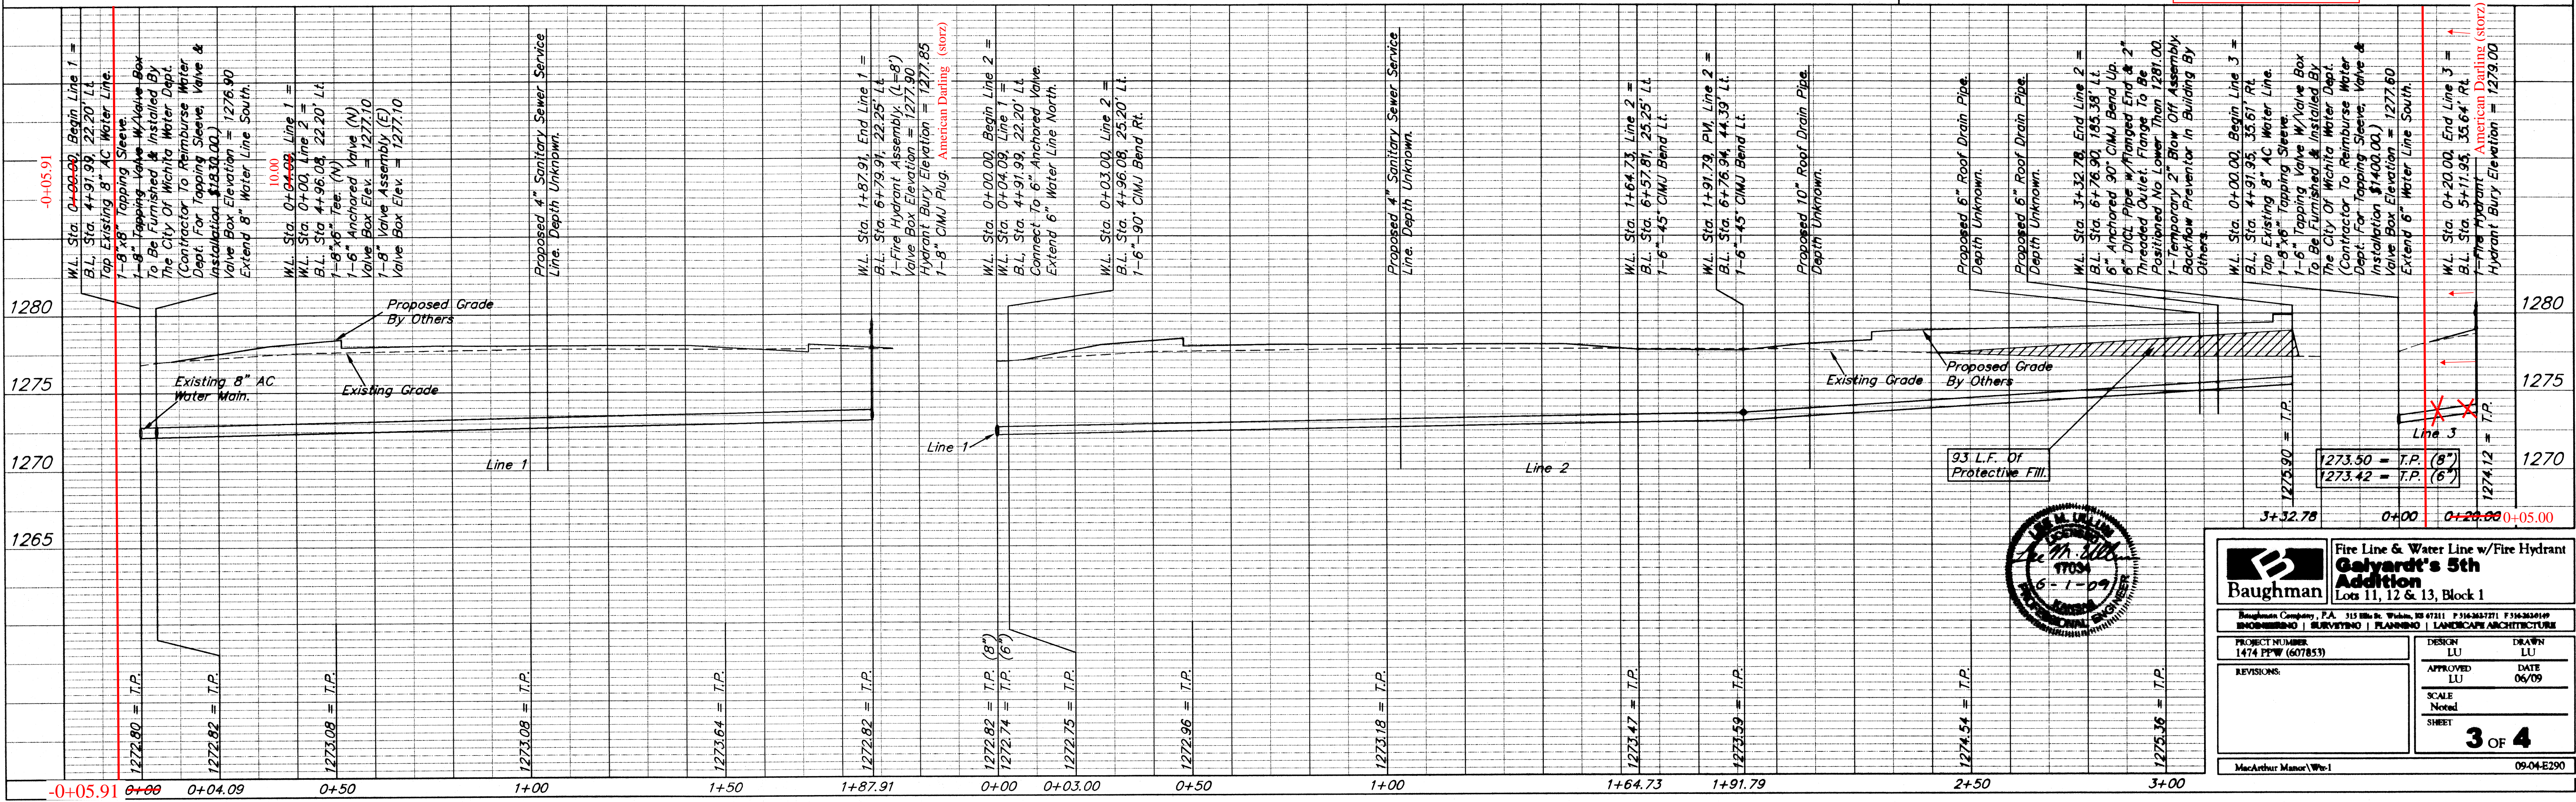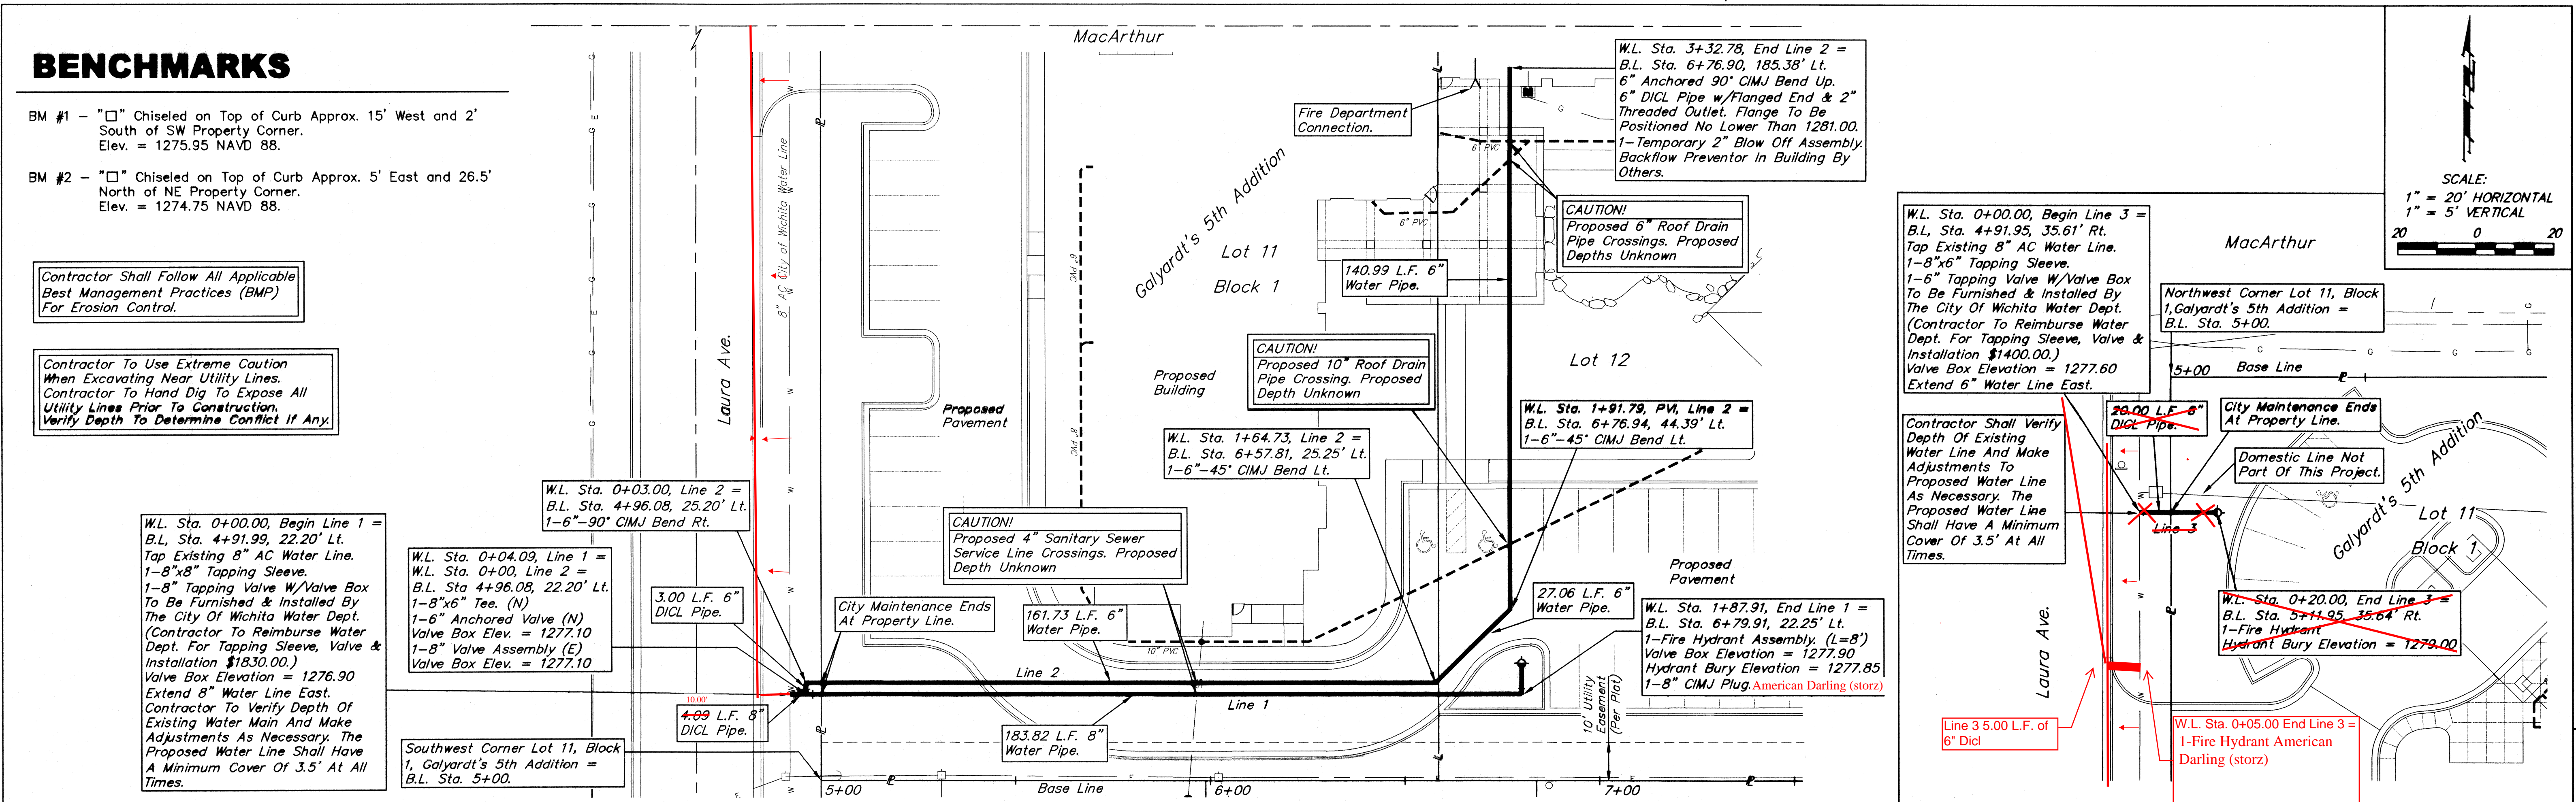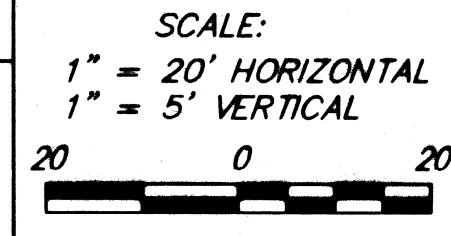

Baughman Fire Line & Water Line w/ Fire Hydrant
Galyardt's 5th Addition
Lots 11, 12 & 13, Block 1

PROJECT NUMBER: 1474 PPW (607853)
DESIGN: LU
APPROVED: LU
DATE: 06/09

REVISIONS:

SCALE: Noted
SHEET: 3 OF 4

MacArthur Manor W-1 09-04-E290