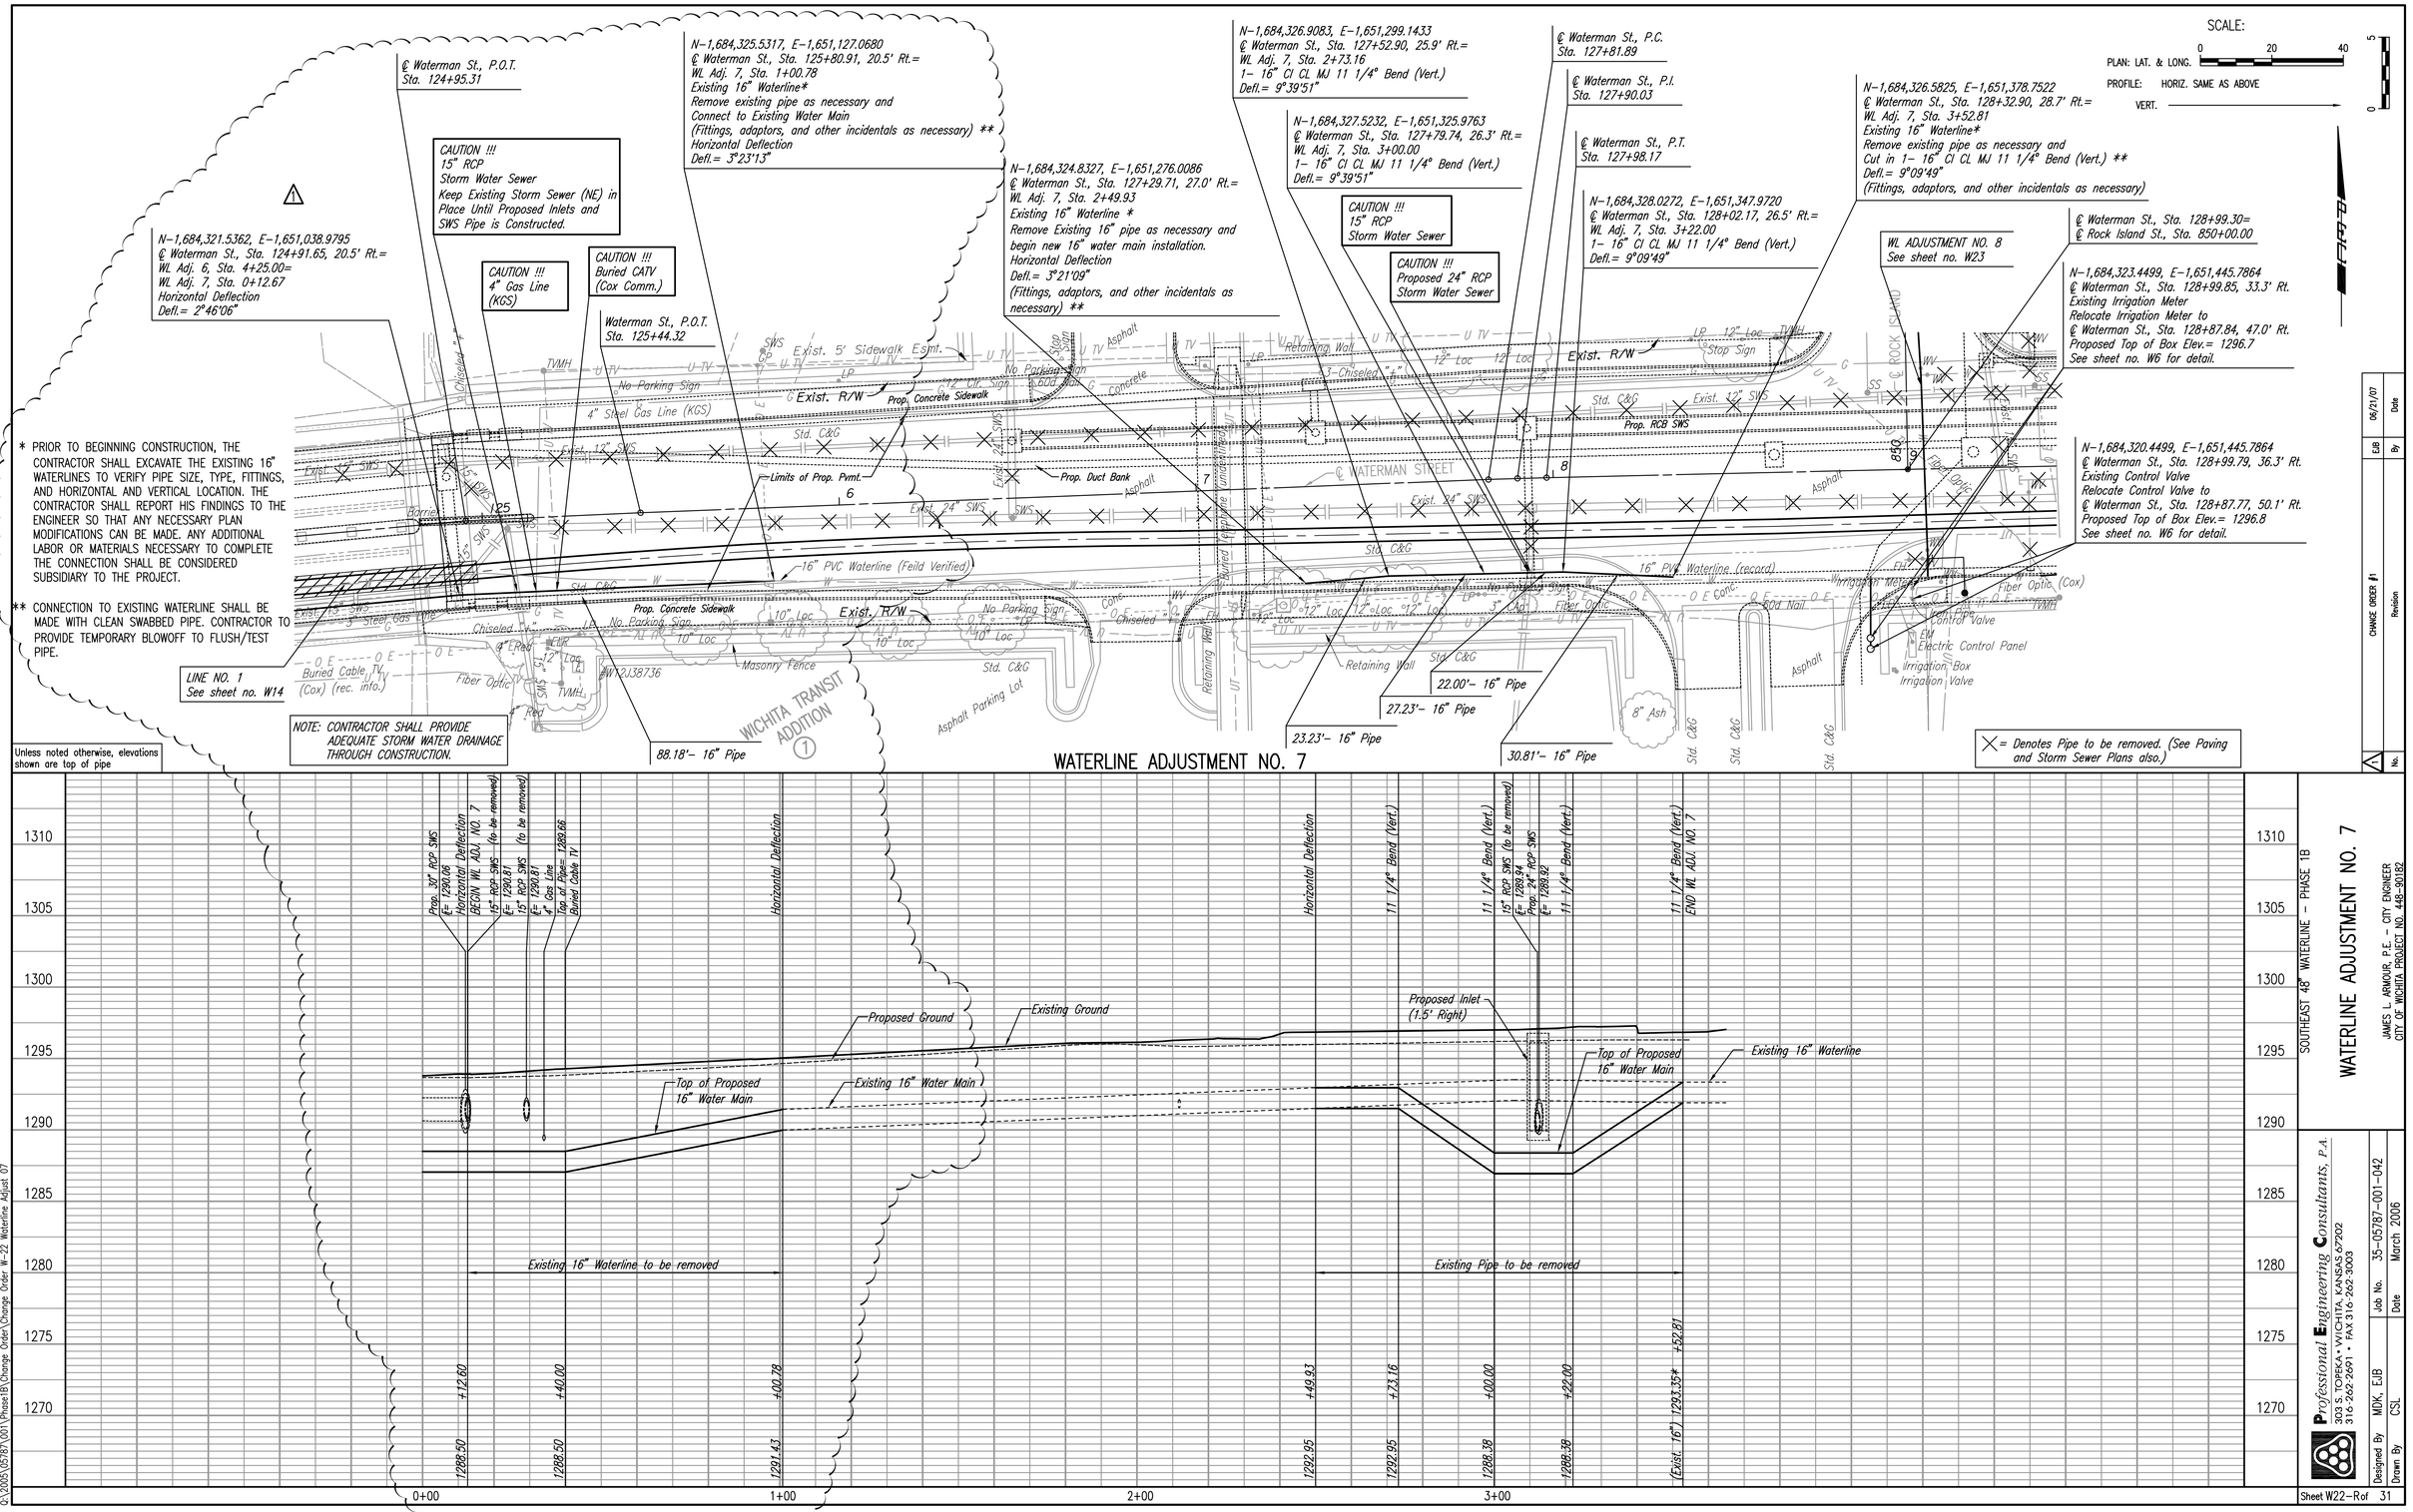

PLAN CHECKED CHECKED BY DATE

PROFILE CHECKED CHECKED BY DATE

CHANGE ORDER #1 — No. | Revision | By | Date | EJB | 06/21/07

SOUTHEAST 48" WATERLINE – PHASE 1B

WATERLINE ADJUSTMENT NO. 7

JAMES L. ARMOUR, P.E. — CITY ENGINEER
CITY OF WICHITA PROJECT NO. 448-90102

Professional Engineering Consultants, P.A.
303 S. TOPEKA • WICHITA, KANSAS 67202
316-262-2691 • FAX 316-262-3003

Designed By MDK, EJB | Job No. 35-05787-001-042
Drawn By CSL | Date March 2006

Sheet W22-R of 31

Saved 06-22-2007 9:35:52 AM by JAN
Plotted On 06-21-2007 10:25:09 AM by BEJ
Q:\2005\05787\001\Phase1B\Change Order\Change Order W-22 Waterline Adjust 07