SERVICE BOX CONSTRUCTION/INSTALLATION DETAILS

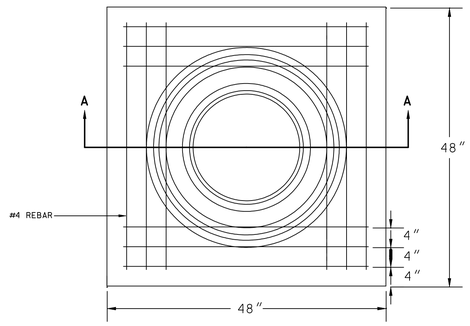

PRE-CAST CONCRETE SERVICE BOX

(36″ I.D. X 54″ RCP) with 6″ CAP

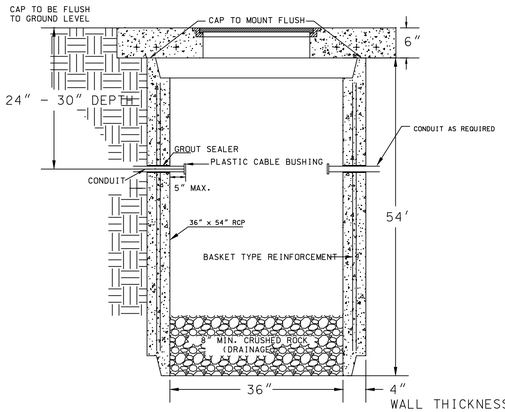

SECTION A–A

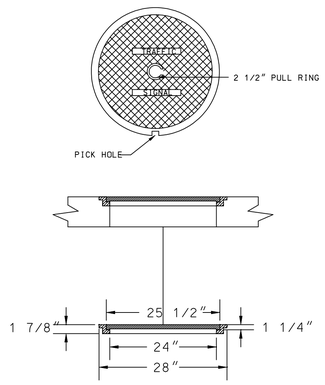

RING & COVER DETAIL

170 CONTROLLER PAD DETAILS

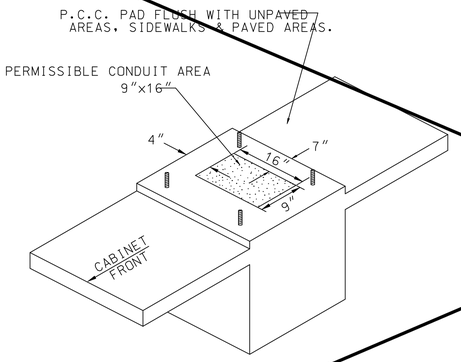

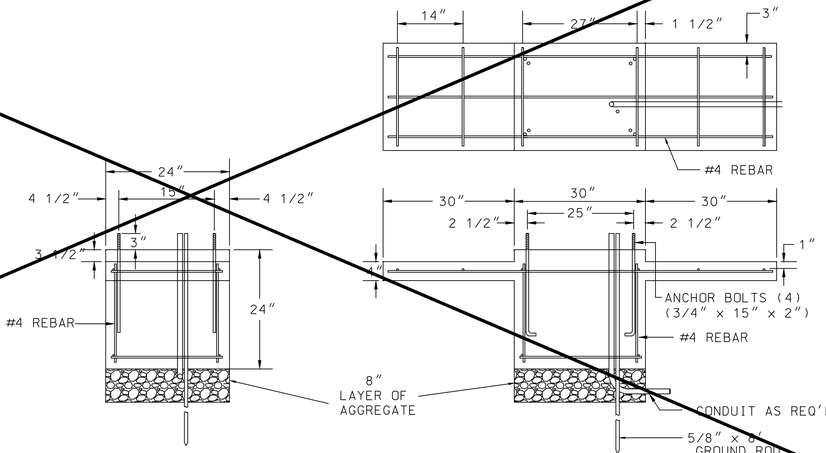

JUNCTION BOX DETAILS

PRE-FAB Junction Box
(24″ I.D. X 36″ R.C.P.)

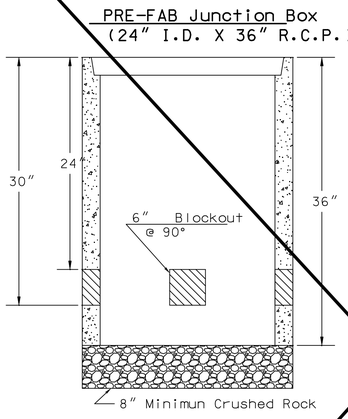

SECTION A–A

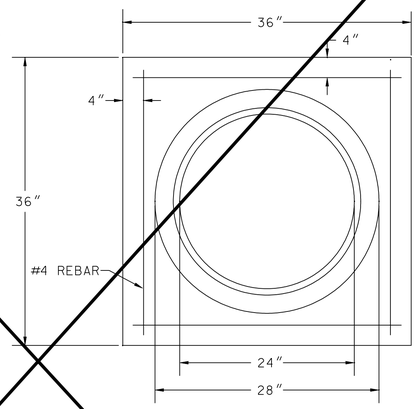

JUNCTION BOX CAP

36″ x 36″ x 6″
TOP OF CAP TO BE FLUSH WITH GROUND LEVEL.

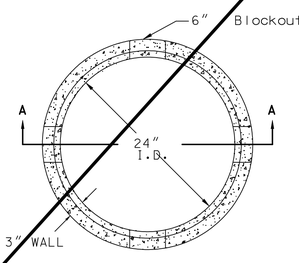

**SEE SERVICE BOX INSTALLATION FOR RING & COVER DETAILS.

NOTES:

SERVICE & JUNCTION BOX:

1. CONDUIT CONNECTION TO BE FLUSH TO WITHIN 125 mm OF INSIDE FACE OF SIDE WALL, CONDUIT TO DRAIN INTO SERVICE BOX.
2. CONDUIT CONNECTIONS TO SERVICE BOX SHALL BE TERMINATED WITH PLASTIC CABLE BUSHING.
3. CONDUIT SHALL BE SEALED WITH APPROVED SEALER AT INSIDE WALL FACE.
4. ALL SERVICE & JUNCTION BOXES TO HAVE 200 mm OF CRUSHED ROCK.

TRENCHING:

1. DEPTH TO BE 30″ MINIMUM WITH ROCK & STUBBLE FREE BACKFILL TO SERVE AS BEDDING MATERIAL. MAINTAIN MINIMUM CONDUIT DEPTH IN TRENCH.
2. BACKFILL TO BE COMPACTED IN 6″ LOOSE LIFTS BY HAND OR MECHANICAL TAMPING TO A 95% STANDARD DENSITY.

CONDUIT:

1. SLOPE CONDUIT TO DRAIN AS DIRECTED BY THE ENGINEER.
2. 3″ RIGID STEEL CONDUIT BTWN. SERVICE BOXES.
   1 1/4″ " " BTWN. SERVICE & JUNCTION BOXES.
   3/4″ " " " BTWN. JUNCTION BOXES.
   3/4″ " " " BTWN. JUNCTION BOX & DETECTOR LOOP SAW CUT

SERVICE/JUNCTION BOX, CONTROLLER PAD CONSTRUCTION/INSTALLATION DETAILS

CONDUIT/DETECTOR WIRE INSTALLATION DETAILS

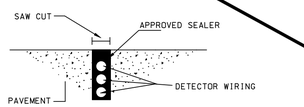

STD. CURB & GUTTER

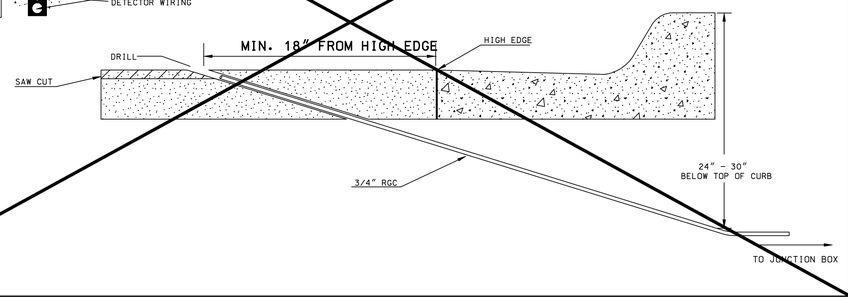

REV.	DATE	COMMENTS	INT

THE CITY OF WICHITA

CITY ENGINEER'S OFFICE
CITY HALL – SEVENTH FLOOR
455 NORTH MAIN STREET
WICHITA, KANSAS 67202
(316) 268-4501
(316) 268-4114 FAX

Greenwich and 29st Street

SERVICE/JUNCTION BOX, CONTROLLER PAD CONSTRUCTION/INSTALLATION DETAILS

PROJECT NUMBER 472-84415

DRAWN BY: T.M.	SCALE	REVISED BY:
DATE: April, 2002	NO SCALE	DATE:

CITY OF WICHITA
DEPARTMENT OF PUBLIC WORKS

DIVISION OF TRAFFIC ENGINEERING
PAUL D. GUNZELMAN, P.E. TRAFFIC ENGINEER

SHEET 50 OF 81

Dsnr: JPS Oper: DRP Scale: 1"=1' Plot Scale
I:/2005/05777/Singing-Marking/05777-sb-dtl(96).dgn Last Rev: 8-3-2006 By: svb