


**SEWER SERVICE TABLE**

NUMBER		LOCATION			FOR INFORMATION ONLY		
		LOT NO.	BLOCK NO.	LINE NO.	STATION \ DIRECTION	APPROXIMATE LENGTH 4" PIPE	
						VERTICAL	HORIZONTAL
1	8" X 4" Tee Saddle	10	-	11	11+46/Lt. 11+46.6	6.0'	5.0'
2	8" X 4" Tee Saddle	11	-	11	11+51/Rt. 11+43.6	6.0'	5.0'

*NOTE: Vertical Riser Pipe shall be extended to 2' minimum above ground water elevation and 4' maximum below proposed ground elevation.*

*NOTE: Line 10 and 11 bid on separate project.  
Project No. 468-84334, OCA No. 744220*

**REVISED: 1/28/09**  
**REVISED: 12/31/07**  
**REVISED: 12/20/07**

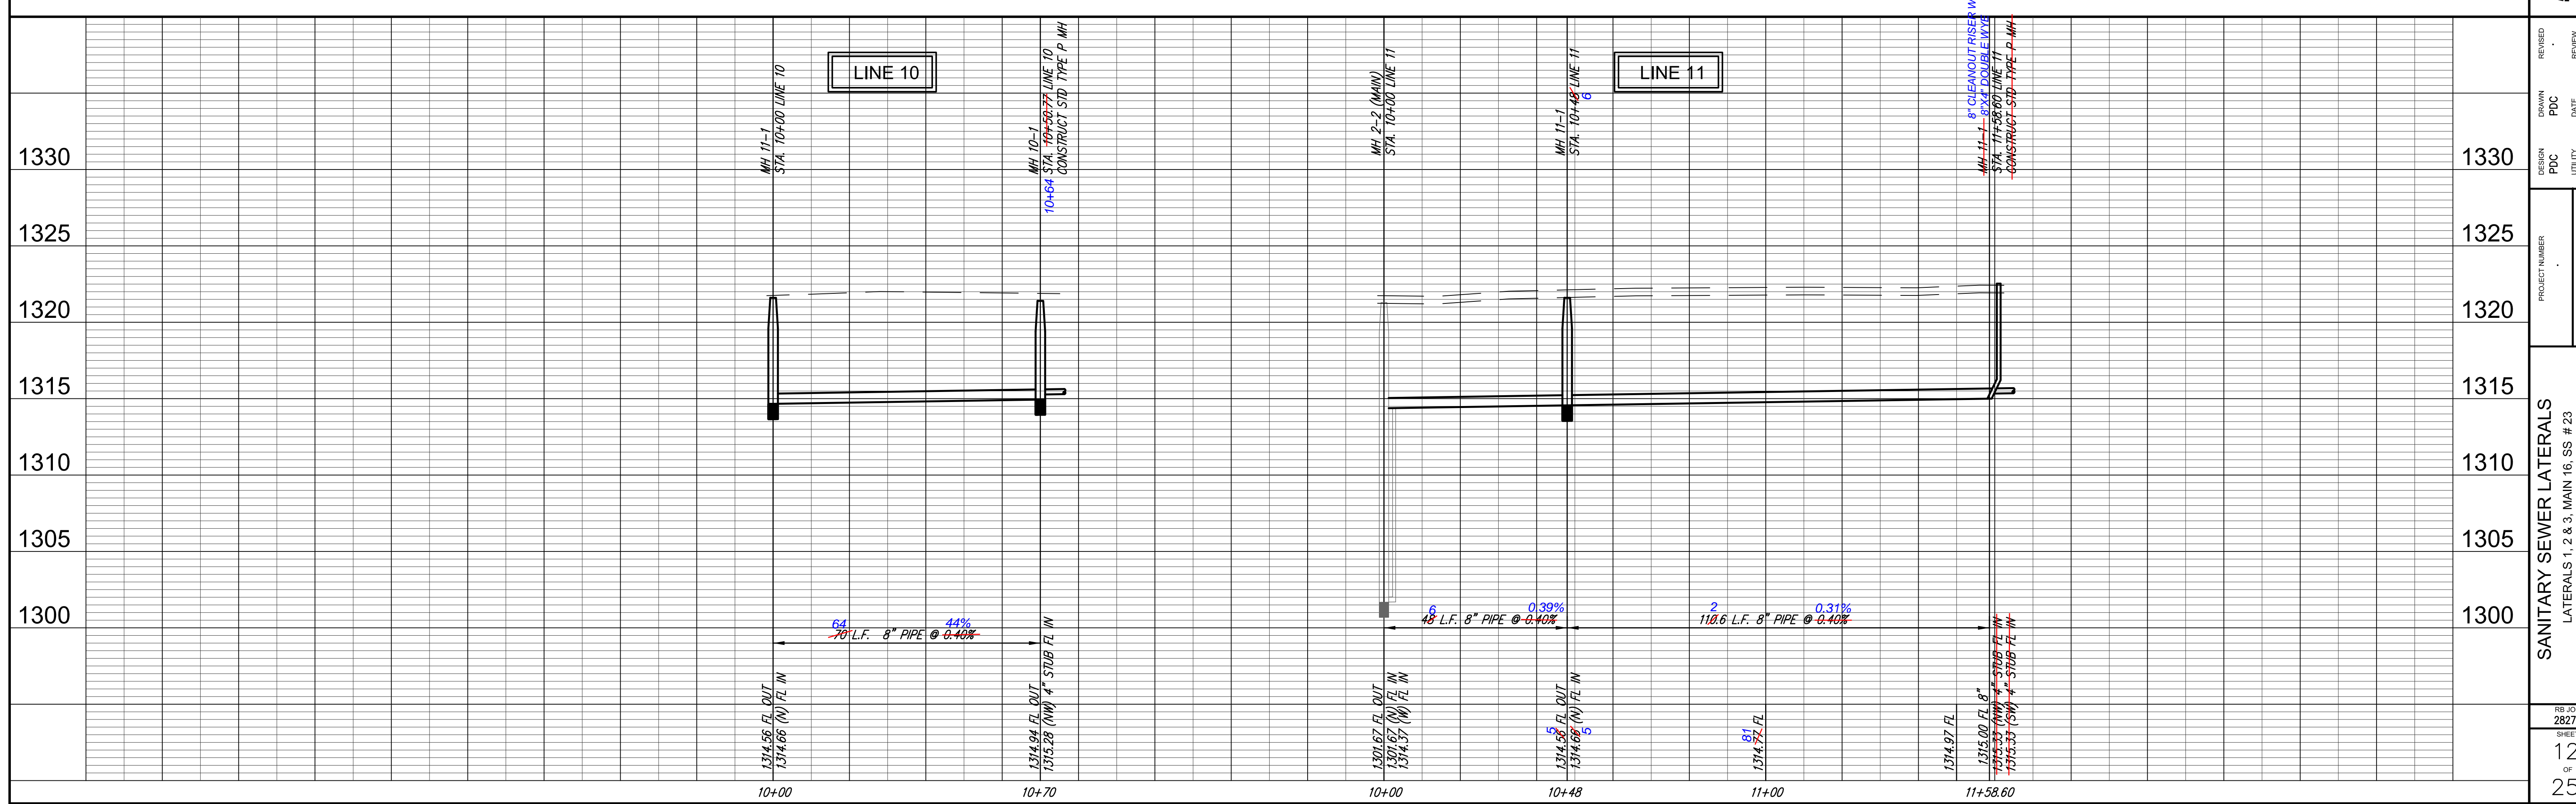

**Ruggles & Bohm, P.A.**  
 Engineering, Surveying, and Planning  
 604 North Main Street  
 Wichita, Kansas 67203  
 www.ruggles.com  
 E-mail: info@ruggles.com

REVISION	REVIEW	DATE
3/26/07	REVIEW	
DESIGN	UTILITY	
DRAWN	DATE	
PDC		
PROJECT NUMBER	DRAWING FILE	
	Engg Base	
SANITARY SEWER LATERALS		
LATERALS 1, 2 & 3, MAIN 16, SS # 23		
LINE 10 & LINE 11		
RB JOB	2827X	
SHEET	12	
OF	25	