


# GREENWAY 2ND ADDITION

CL STA. 20+74.65 (PC)  
N. 5066.697' E. 3575.311'  
OFFICE CALCULATED POINT  
(NO MONUMENT)

COUNTY	STATE	PROJECT NUMBER	FISCAL YEAR	SHEET NO.	TOTAL SHEETS
KANSAS	KANSAS	87 N-0237-01	2006	7	78

CL STA. 20+74.65 TO STA. 22+26.84  
 RE=530.00'  
 DELTA=24°06'23"  
 L=222.99'  
 C=221.35'  
 C, BEARING= S 79d08'32" E

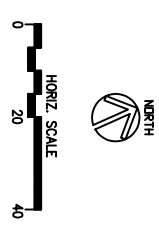

- LEGEND:**
- (LP) = LOW POINT
  - (HP) = HIGH POINT
  - (PC) = POINT OF CURVATURE
  - (PT) = POINT OF TANGENCY
  - TC = TOP OF CURB
  - ON = GROUND
  - FL = FLOWLINE
  - ME = MATCH EXISTING ELEVATION
  - FD = DIRECTION OF STORMWATER FLOW
  - [Hatched Box] = PAVEMENT REMOVAL

**NOTES:**  
 1. UNLESS OTHERWISE INDICATED, DIMENSIONS ARE MEASURED TO BACK OF CURB.


**BENCHMARK:**  
 IC IN TOP OF CURB AT SOUTH SIDE OF DRIVE ENTRANCE RETURN TO GREENWAY PARK APARTMENTS, PAVNEE AVENUE  
 ELEV. = 98.87' (CITY DATUM)

**REMOVE & RESET PARK SIGN. COORDINATE NEW LOCATION WITH PARKS DEPARTMENT. REMOVE & RELOCATE PARK ENTRANCE SIGN.**

PAVEMENT REMOVAL, THIS SHEET  
 CONC. AND/OR ASPH. SIDEWALK, DRIVE REMOVED, THIS SHEET  
 TREES, LARGE REMOVED, THIS SHEET  
 CONCRETE PAVEMENT (C) (REMOVED), THIS SHEET  
 CURB AND/OR DRIVE (D) (REMOVED), THIS SHEET  
 CURB AND/OR DRIVE (E) (REMOVED), THIS SHEET  
 MEDIAN C&G (TYPE 1), THIS SHEET  
 SIDEWALK CONCRETE, 4", THIS SHEET  
 2.5" BRICK PAVERS, THIS SHEET  
 4.5" BRICK PAVERS, THIS SHEET  
 INLET HOOK-UP, THIS SHEET  
 WATER VALVE ADJUSTMENT, THIS SHEET  
 STREET LIGHT CONDUIT (2"), THIS SHEET

2171	SY
180	SY
2424	EA
377	DI
876	LF
688	LF
3950	SF
228	SF
2	EA
1	EA
355	LF

## PAWNEE AVENUE

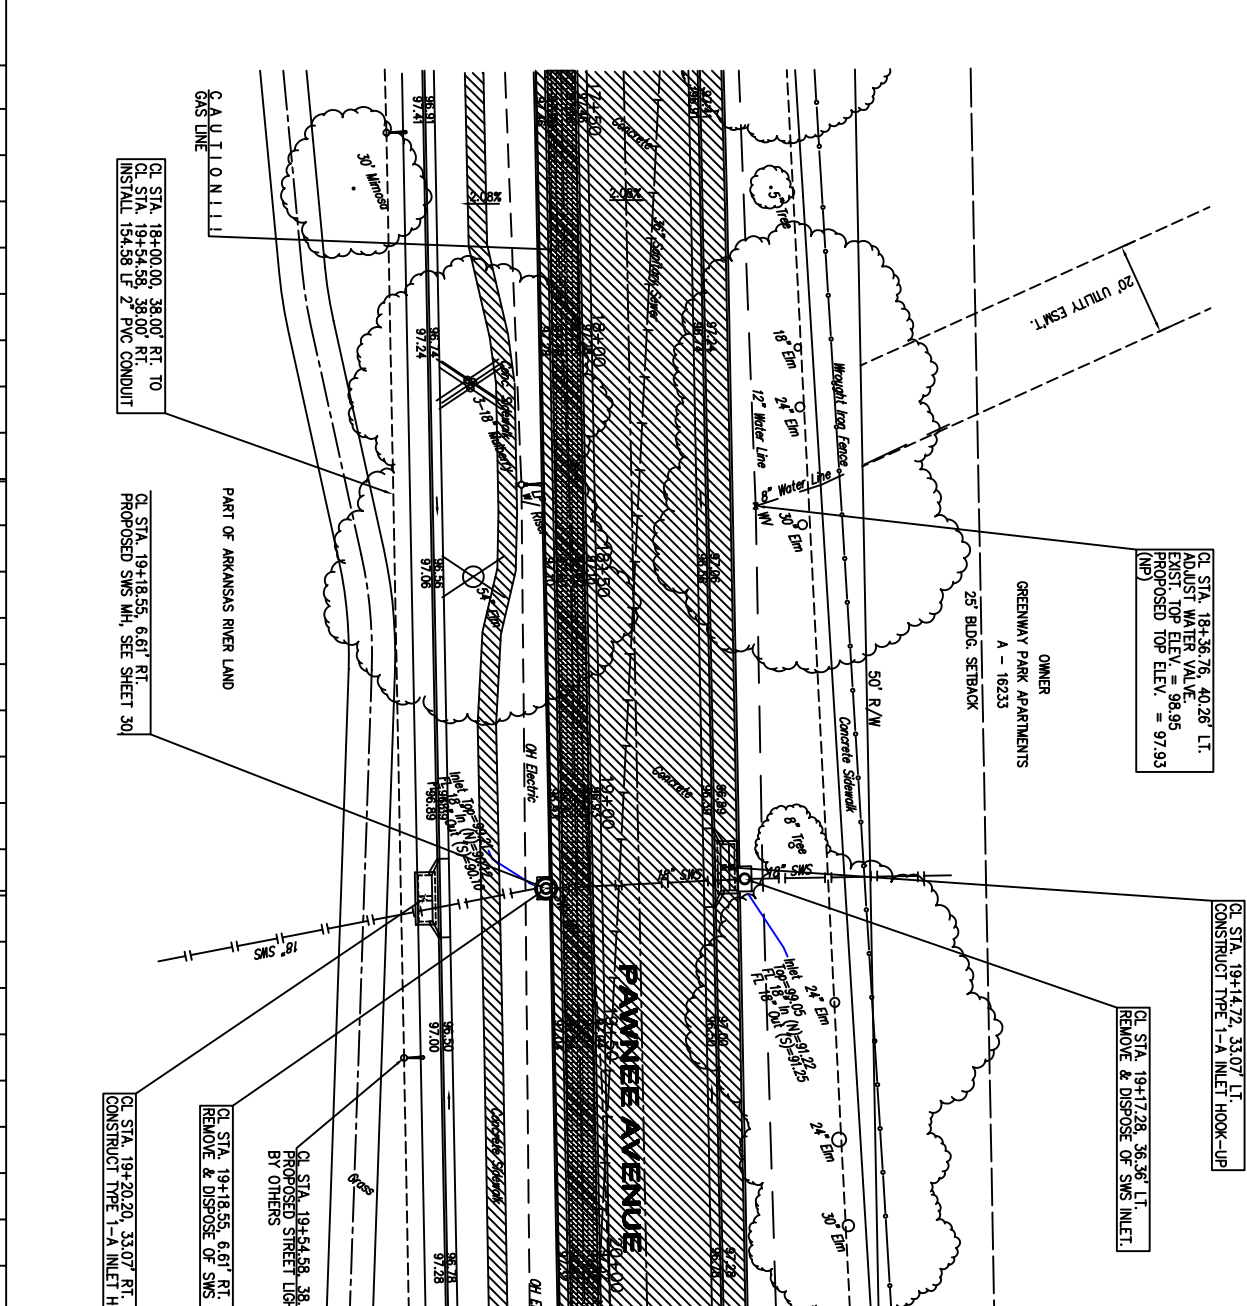

115	115	18+00	18+30	18+60	18+90	19+20	19+50	19+80	20+10	20+40	20+70	21+00	21+30	21+60	21+90	22+20	22+50	22+80	23+10	23+40	23+70	24+00	291+30	291+60	291+90	292+20	292+50	292+80	293+10
-----	-----	-------	-------	--------	--------	