


STATE	PROJECT NO.	FISCAL YEAR	SHEET NO.	TOTAL SHEETS
KANSAS	54-87 K-8258-08	2005	221	223

DATE	BY

FINAL SURVEY PLOTTED AREAS CHECKED

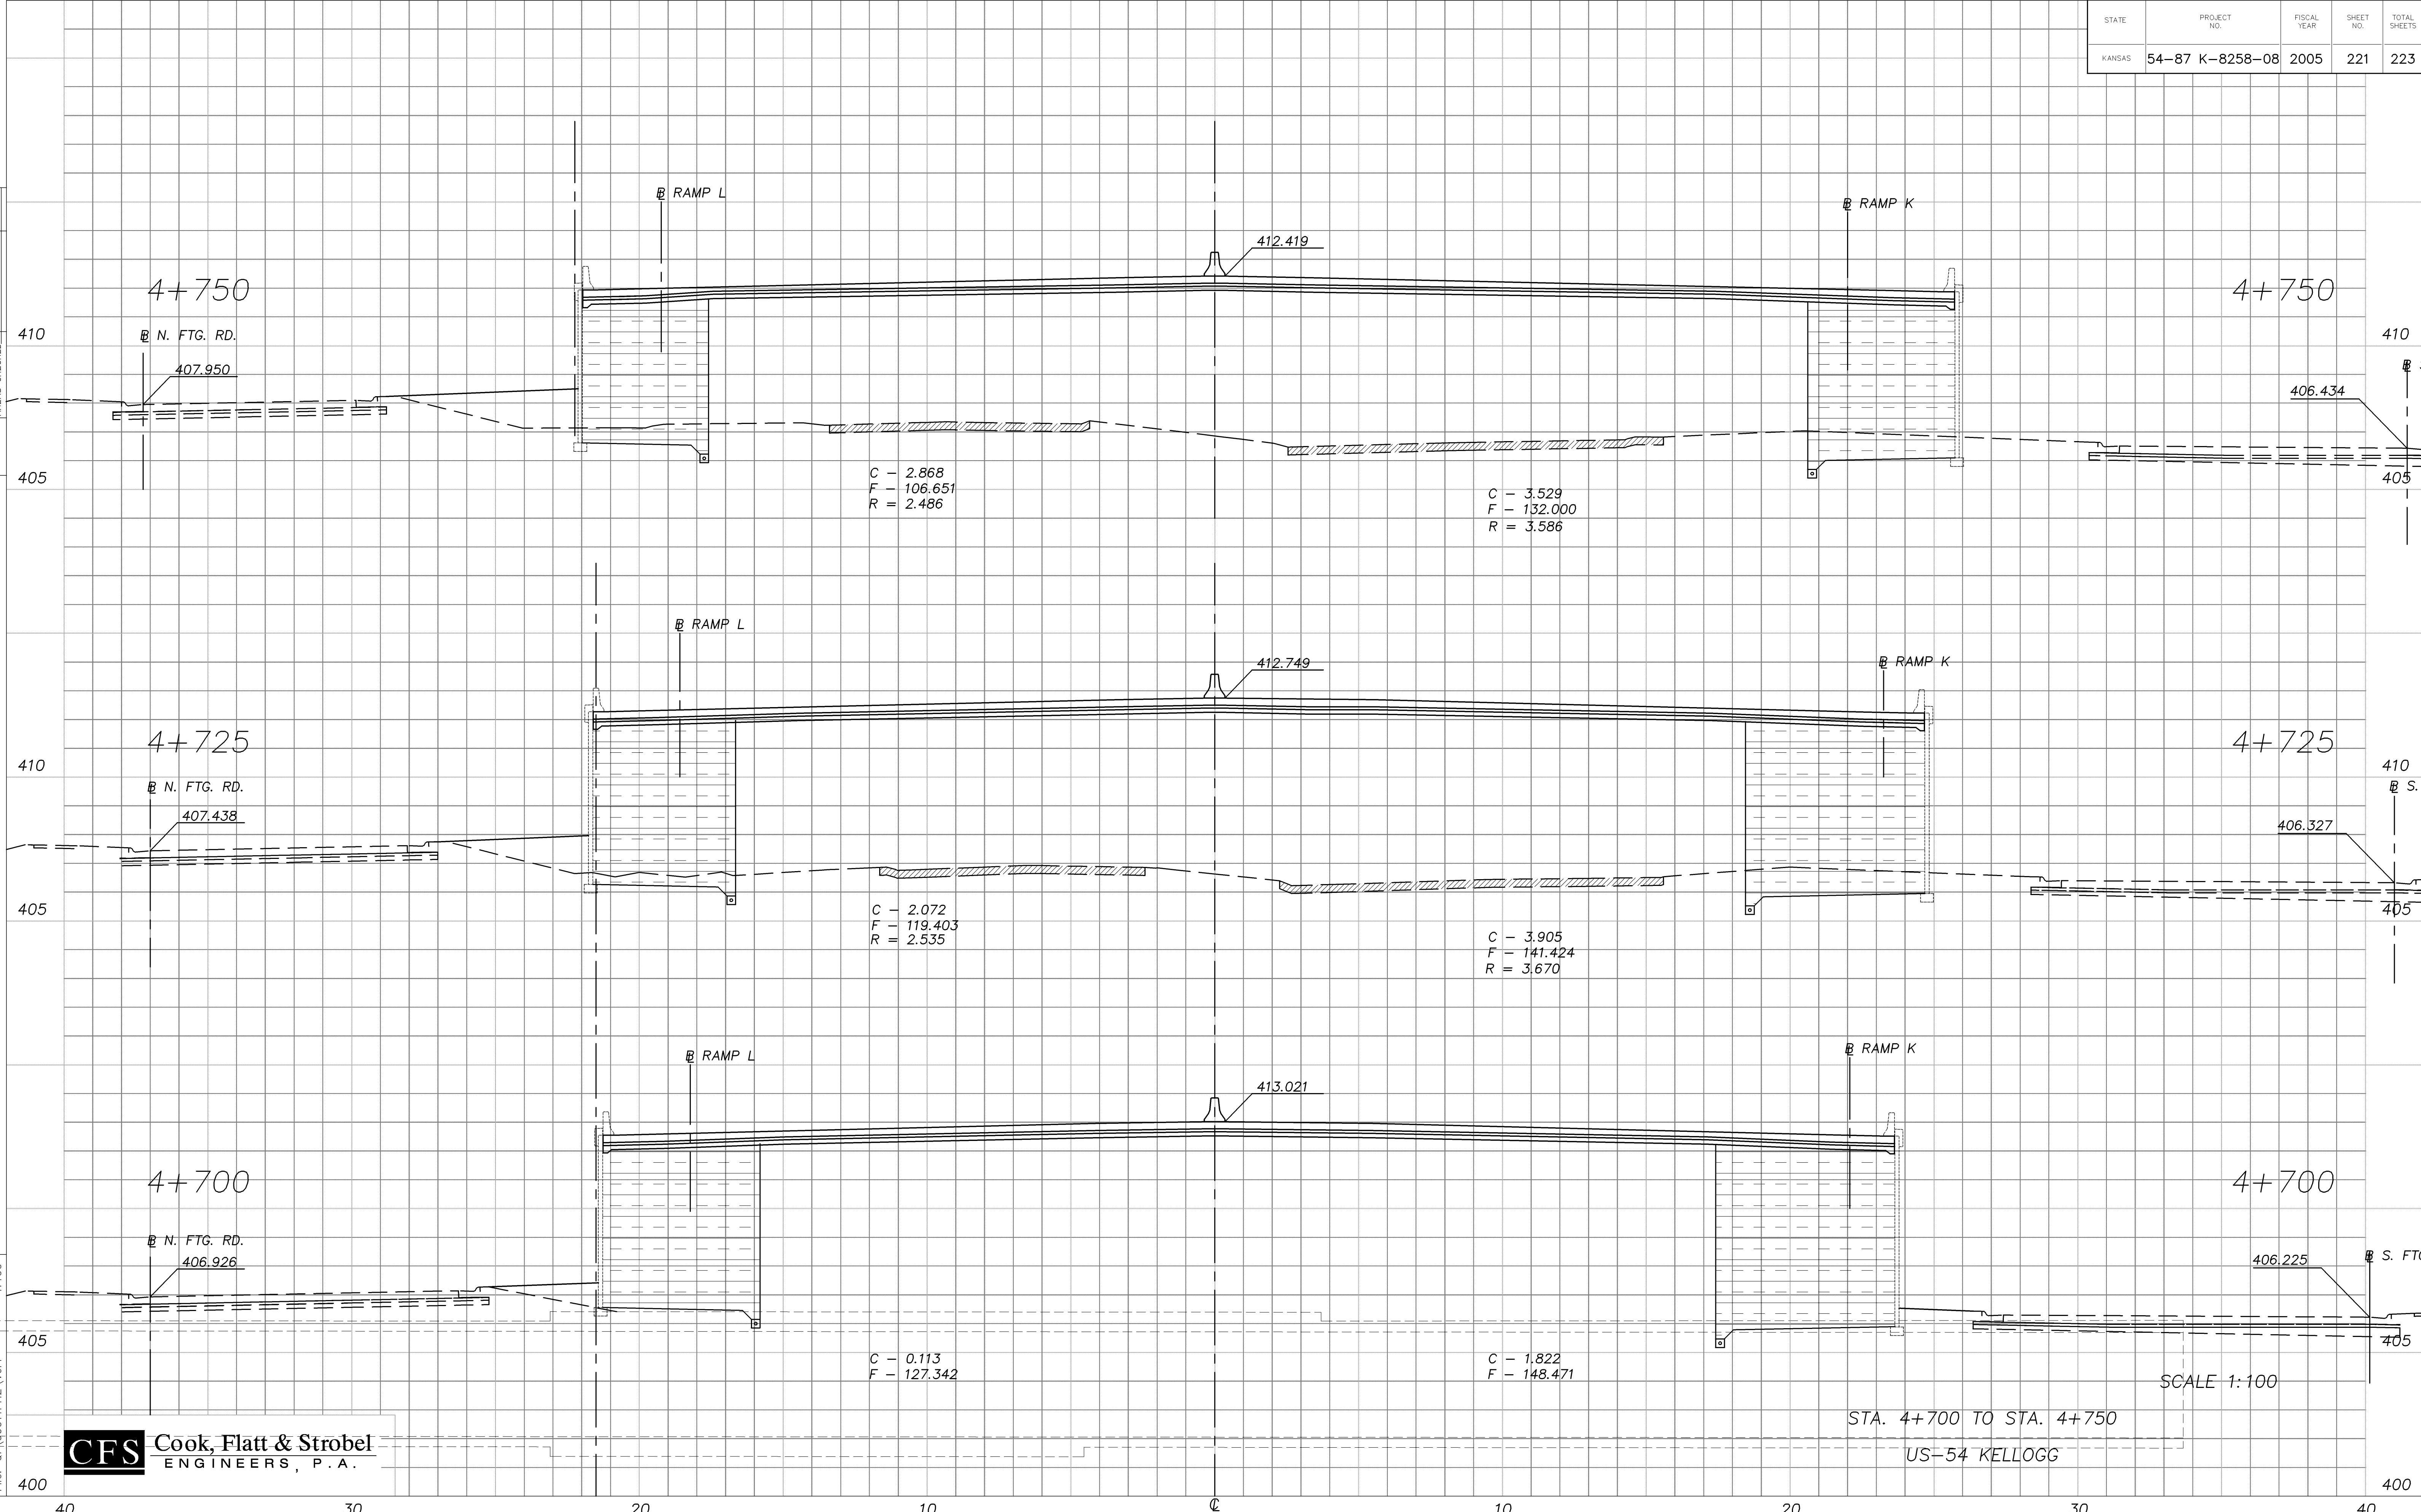

STA. 4+700 TO STA. 4+750
US-54 KELLOGG

SCALE 1:100



Drawn by: Plotted: 1:100
File: O:\00011PH2\Vol4