
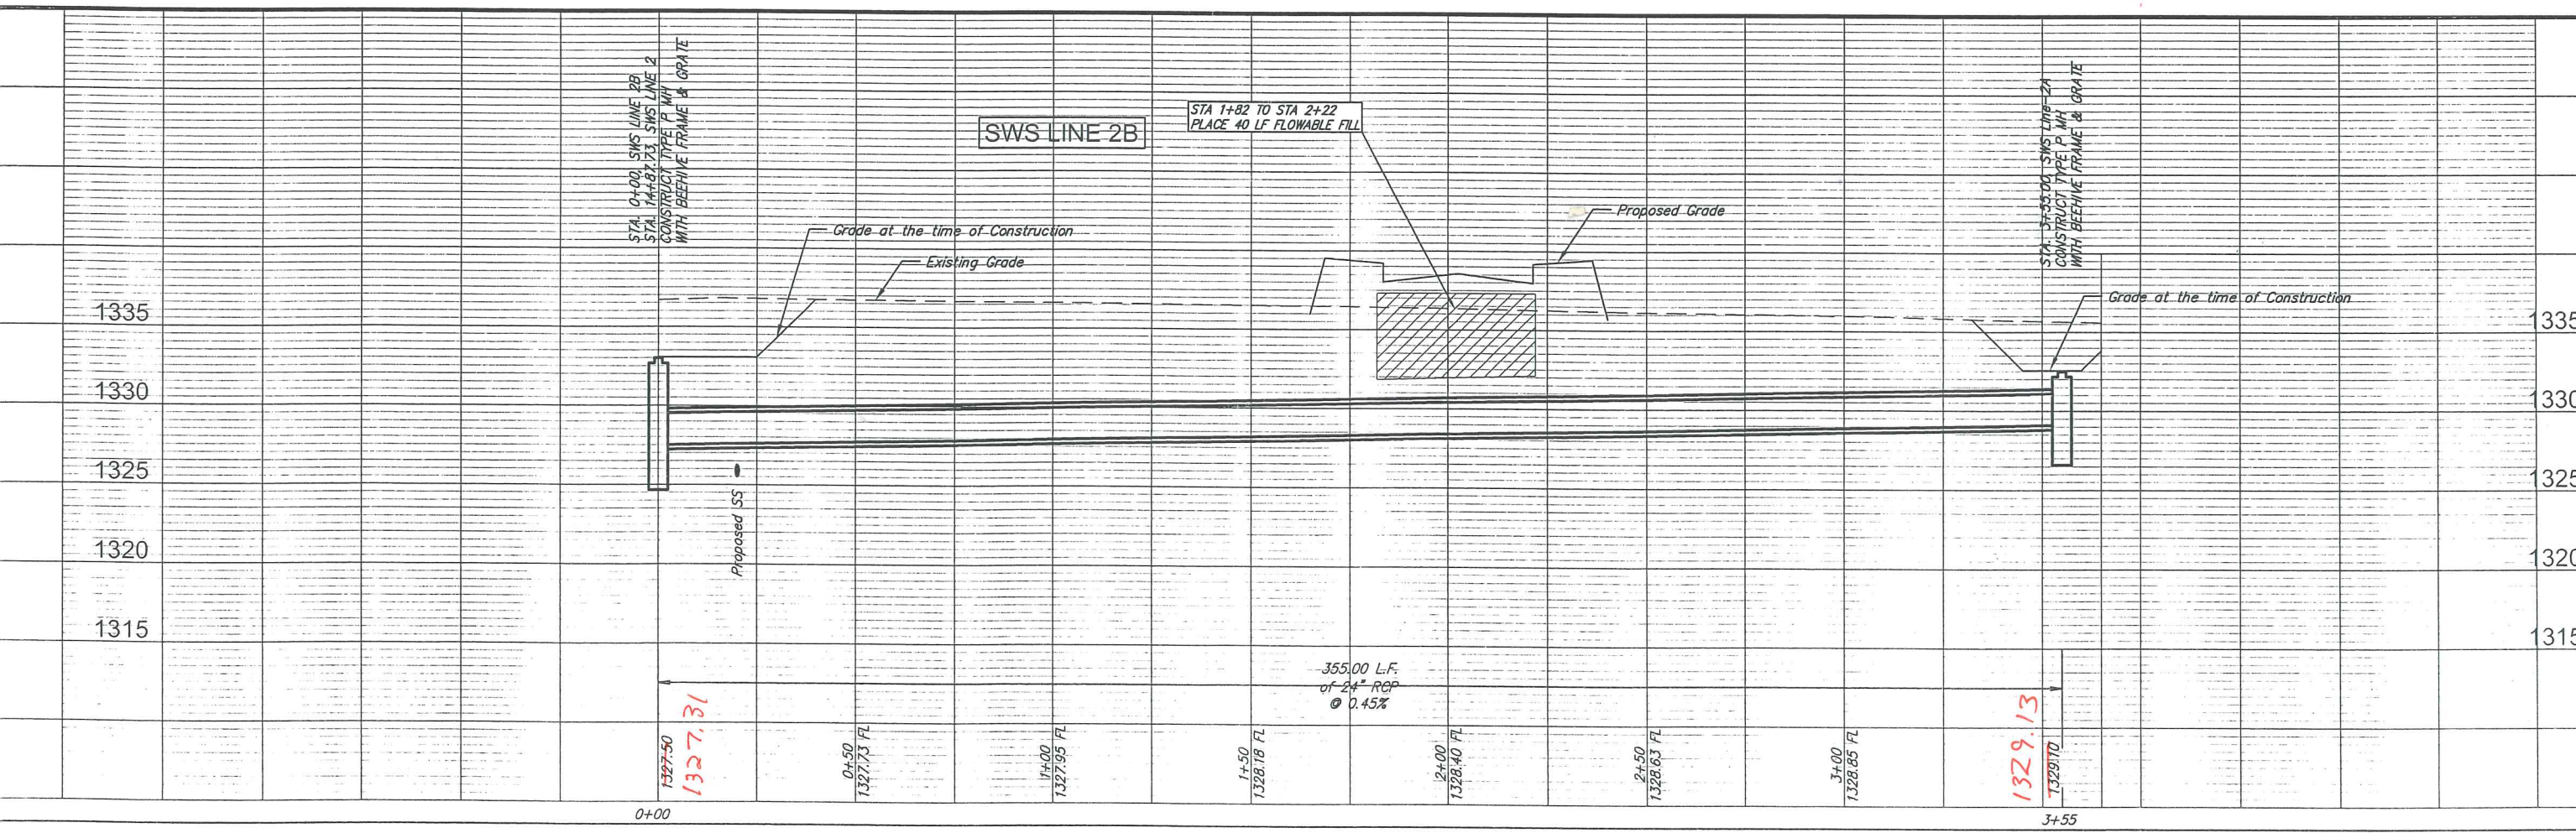
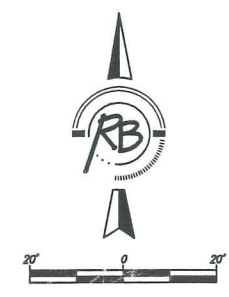


Sierra Hills 2nd Addition

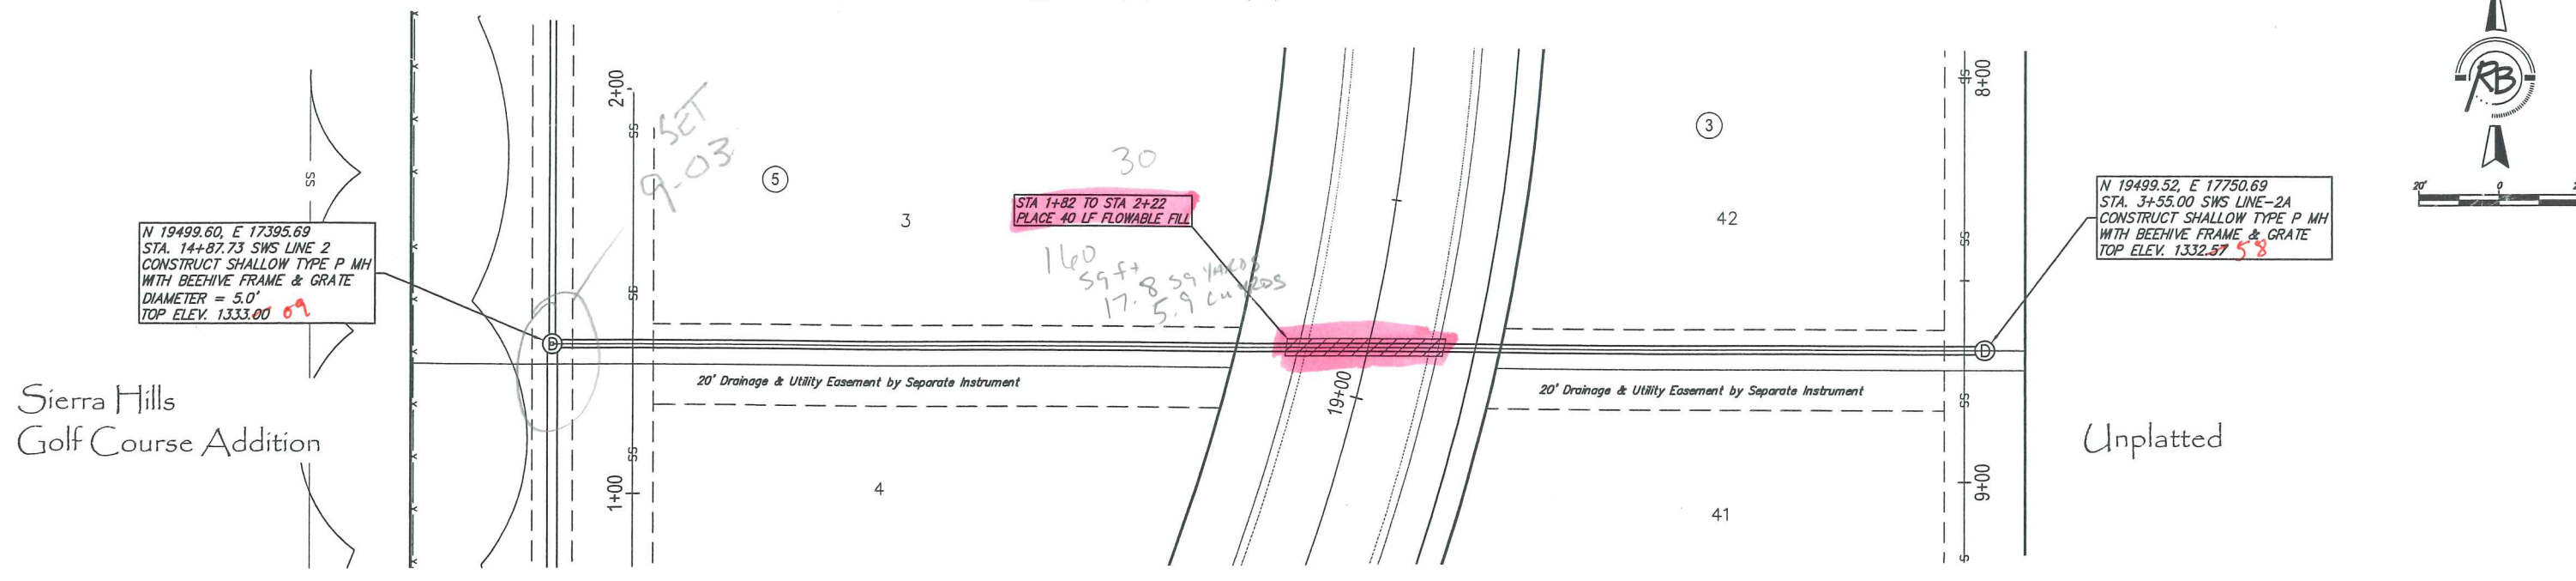

Ruggles & Bohm, P.A.
 Engineering, Surveying, Land Planning

PROJECT NUMBER: 1872PPS
 DRAWING FILE: Engineering Base (SWS Line 2A)

SIERRA HILLS 2ND ADDITION
 SWS Line 2B
 WICHITA, KANSAS

RB JOB: 3268E
 SHEET: 12 of 23

DESIGN: EJC
 DRAWN: EJC
 REVIEW: EJC
 UTILITY: DATE: APR 30, 2009