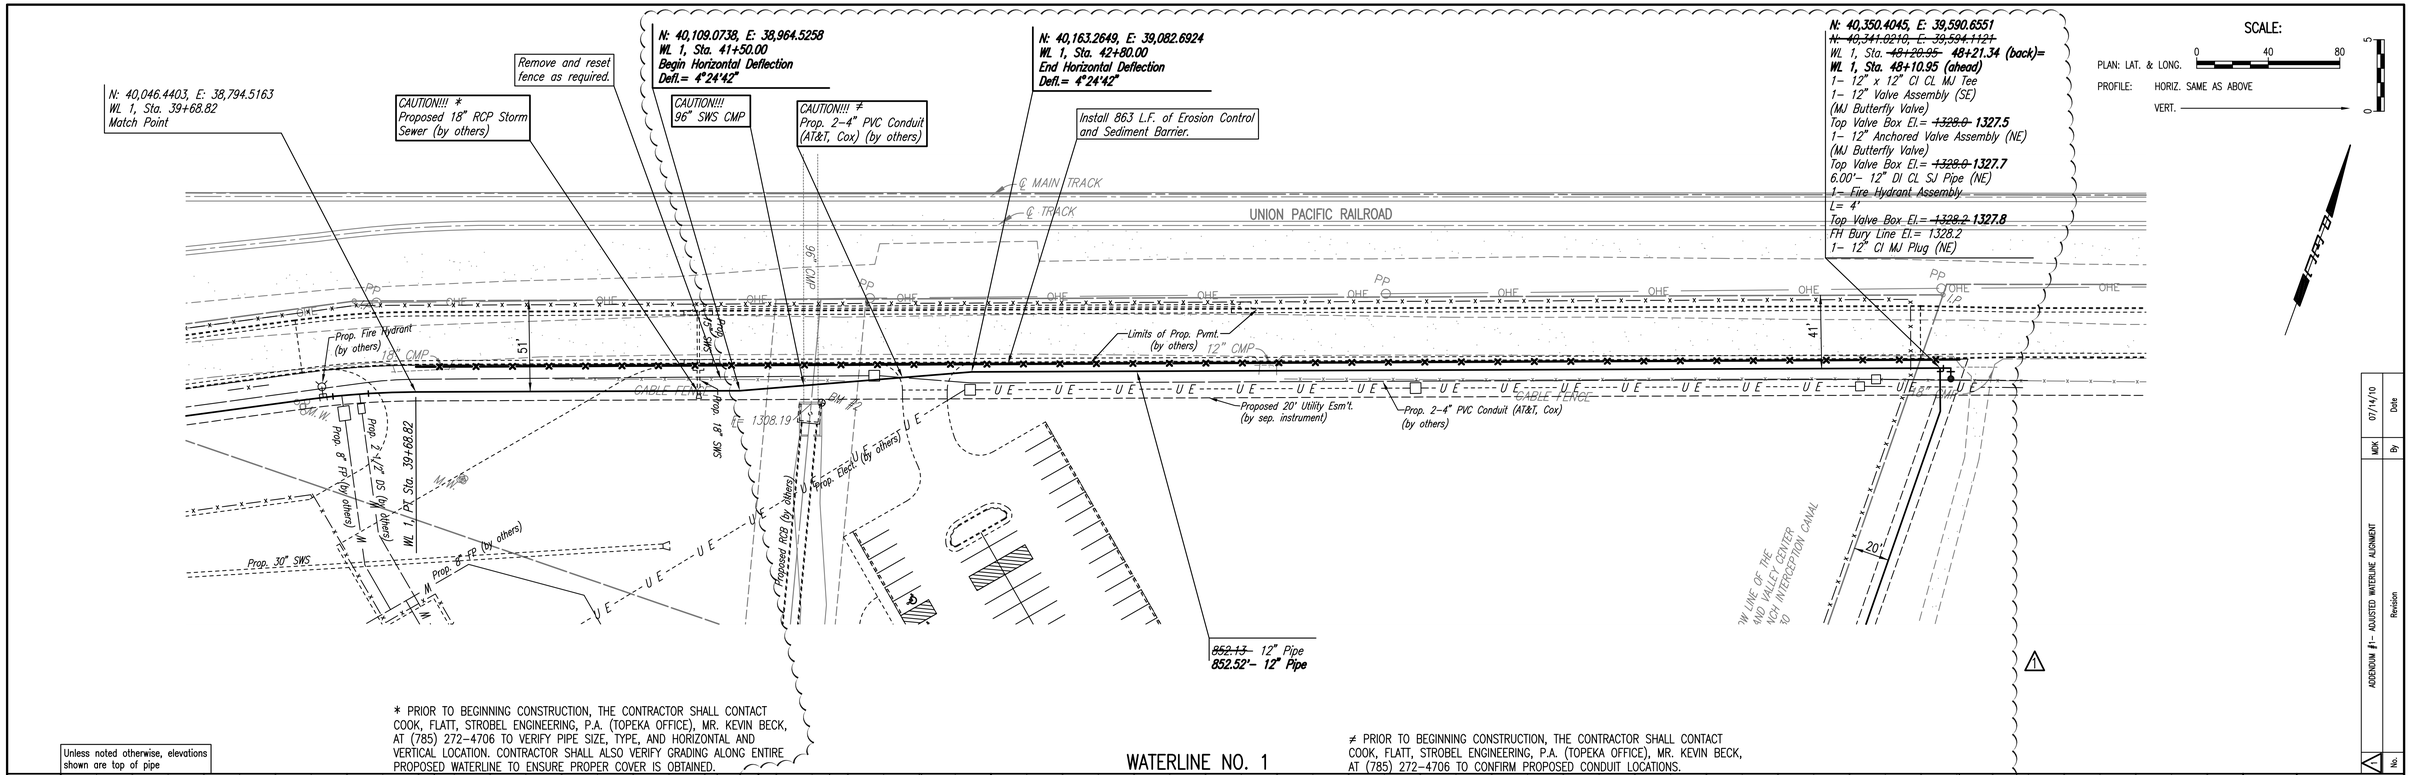

Unless noted otherwise, elevations shown are top of pipe

* PRIOR TO BEGINNING CONSTRUCTION, THE CONTRACTOR SHALL CONTACT COOK, FLATT, STROBEL ENGINEERING, P.A. (TOPEKA OFFICE), MR. KEVIN BECK, AT (785) 272-4706 TO VERIFY PIPE SIZE, TYPE, AND HORIZONTAL AND VERTICAL LOCATION. CONTRACTOR SHALL ALSO VERIFY GRADING ALONG ENTIRE PROPOSED WATERLINE TO ENSURE PROPER COVER IS OBTAINED.

≠ PRIOR TO BEGINNING CONSTRUCTION, THE CONTRACTOR SHALL CONTACT COOK, FLATT, STROBEL ENGINEERING, P.A. (TOPEKA OFFICE), MR. KEVIN BECK, AT (785) 272-4706 TO CONFIRM PROPOSED CONDUIT LOCATIONS.

WATERLINE NO. 1

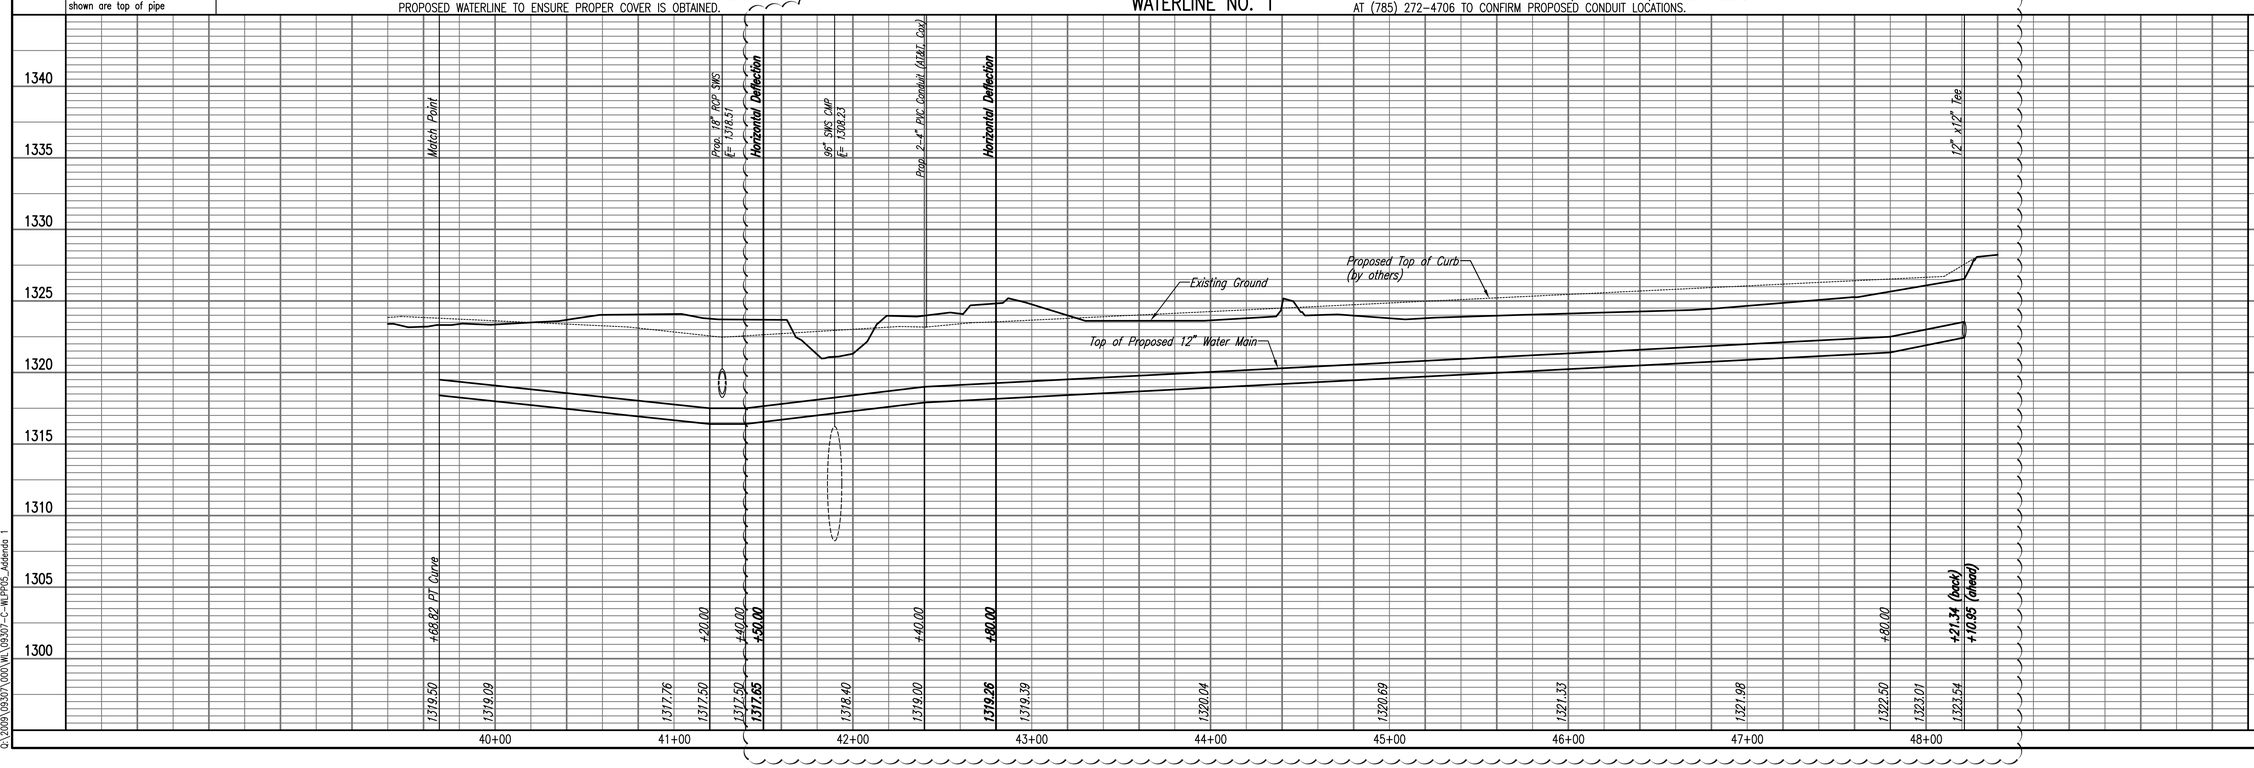

PLAN	BY	DATE
CHECKED		
CHECKED		

PROFILE	BY	DATE
CHECKED		
CHECKED		

No.	Revision	By	Date
1	ADDENDUM #1 - ADJUSTED WATERLINE ALIGNMENT	MDK	07/14/10

HEARTLAND PREPAREDNESS CENTER
WATERLINE IMPROVEMENTS

WATERLINE NO. 1

JAMES L. ARMOUR, P.E. – CITY ENGINEER
CITY OF WICHITA PROJECT NO. 448-90476

Professional Engineering Consultants, P.A.
303 S. TOPEKA • WICHITA, KANSAS 67202
316-262-2691 • FAX 316-262-3003

Designed By MDK
Drawn By JLM
Job No. 35-09307-259
Date January 2010

Sheet 9R of 17

Saved 07-14-2010 2:42:29 PM by JLM
Plot Scale 1:40 07-14-2010 2:42:32 PM by JLM
G:\2009\09307\000\WL\09307-C-WLP05_Addenda 1