

**MT VERNON STREET AND
DRAINAGE IMPROVEMENTS
FROM GREENWAY TO BROADWAY**

**Sanitary Sewer
Line 1**
SHEET TITLE 472-84289
448-90385
468-84514
PROJECT NUMBER

DESIGN BY JRA
DRAWN BY JSB
CHECKED BY JRA

ISSUED
May 27, 2008
REVISED

SHEET NO.
71 of 120

Sta. 0+00.00, Line 1=
@ Sta. 18+73.47, 11.25' Lt.
Exist. Manhole. Replace Exist.
Frame and Lid. Adjust Manhole Top
Exist. Top=100.19
Prop. Top=100.49

Remove and Replace 365.4 L.F.
of 8" Pipe


Sta. 1+72.15, Line 1=
@ Sta. 16+80.23, 9.72' Lt.
Remove Exist. Manhole

Sta. 3+65.44, Line 1=
@ Sta. 15+08.08, 9.20' Lt.
Exist. Manhole. Adjust Manhole Top
Exist. Top=100.47
Prop. Top=100.29

Note: Removed and replaced
existing type 'A' mh with
special type 'P' flat top mh
Top Elev. = 100.29
Flowline Out (W) = 96.44

Sta. 1+56.12, Line 1=
@ Sta. 17+17.36, 9.95' Lt.
Remove Exist. Manhole


Note: Abandoned line.
Demolished in place.

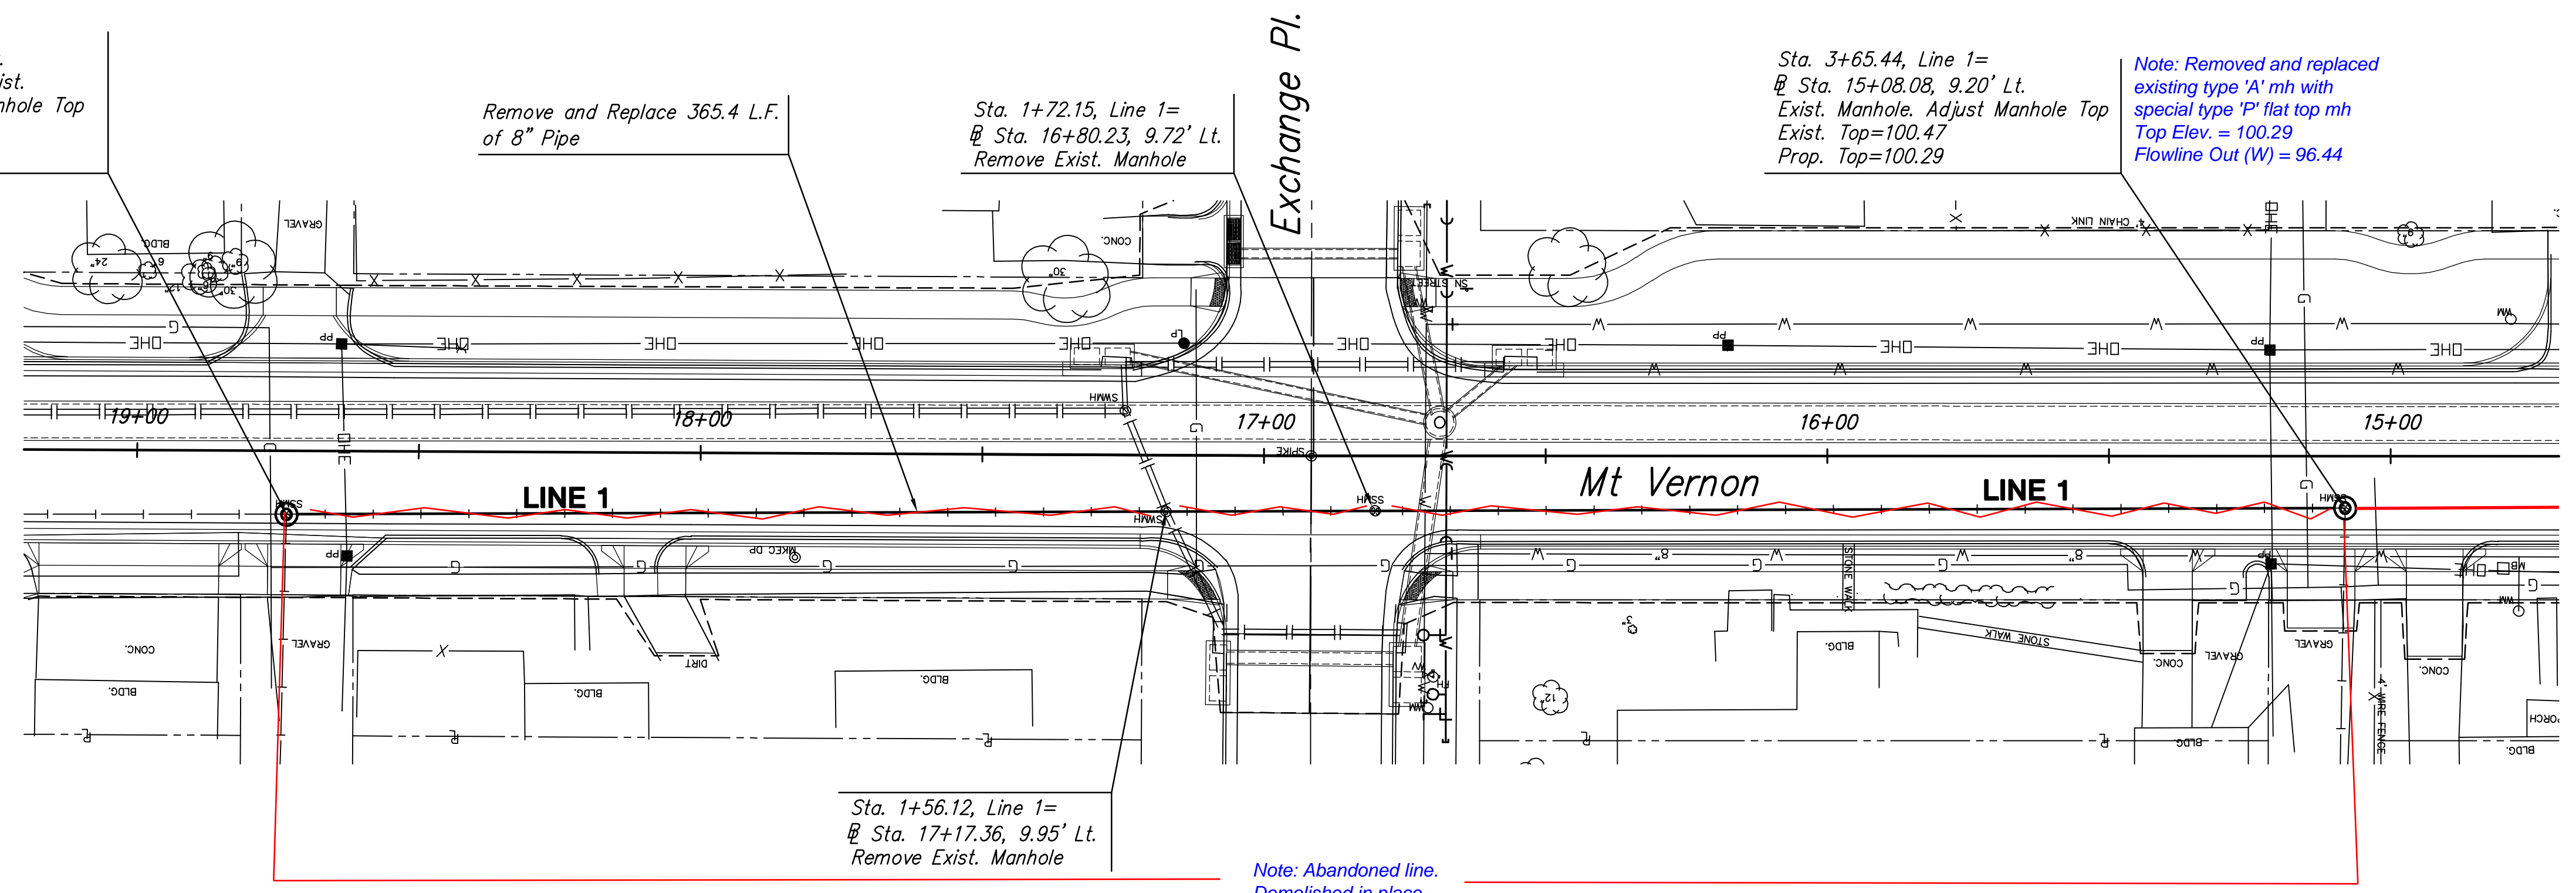

PLAN-LINE 1

PROFILE-LINE 1

SCALE: HORIZ. 1"=20'
SCALE: VERT. 1"=3'

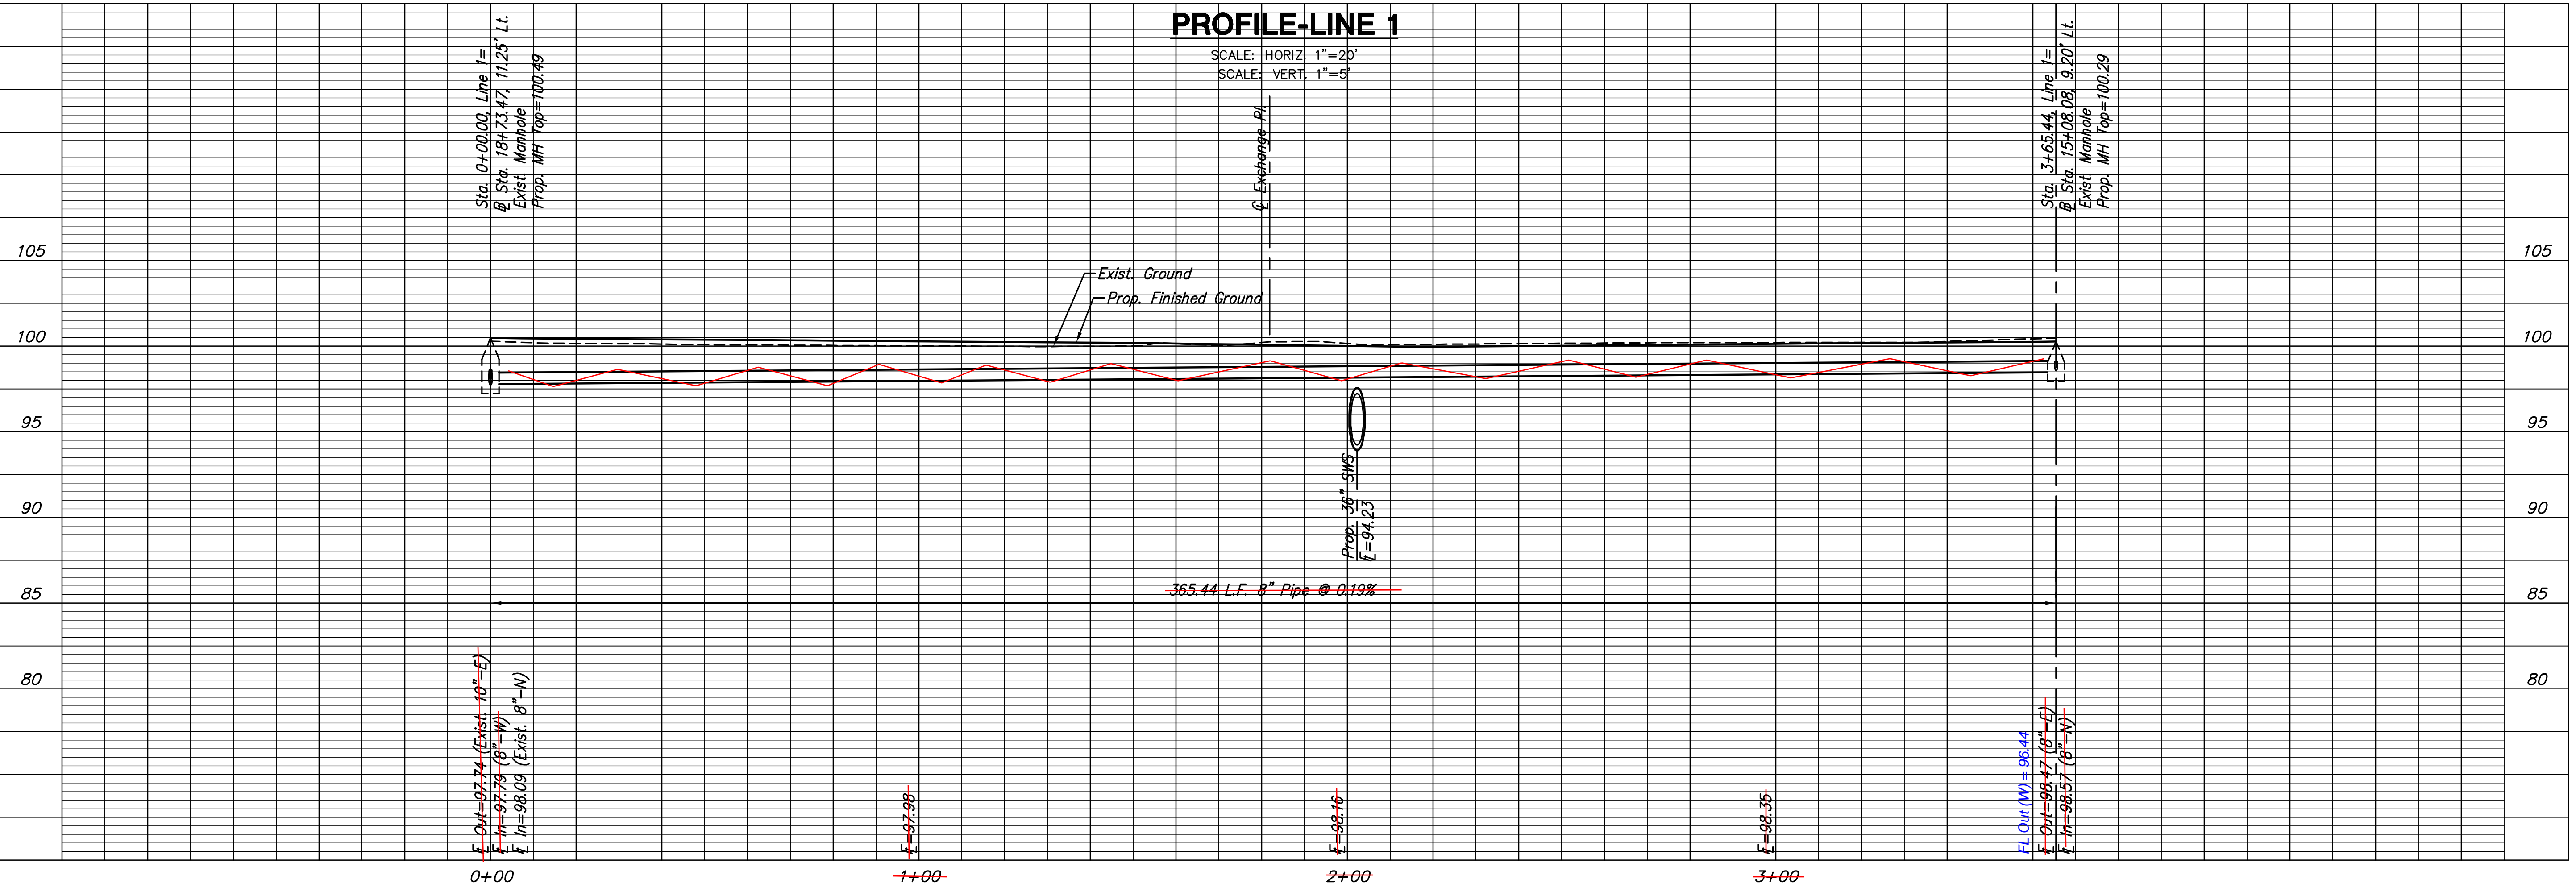

PLOTED: Tuesday, May 27, 2008 @ 04:38PM

J:\CIVIL\05620\DWG\PLAN\0562001.DWG