




BY	DATE

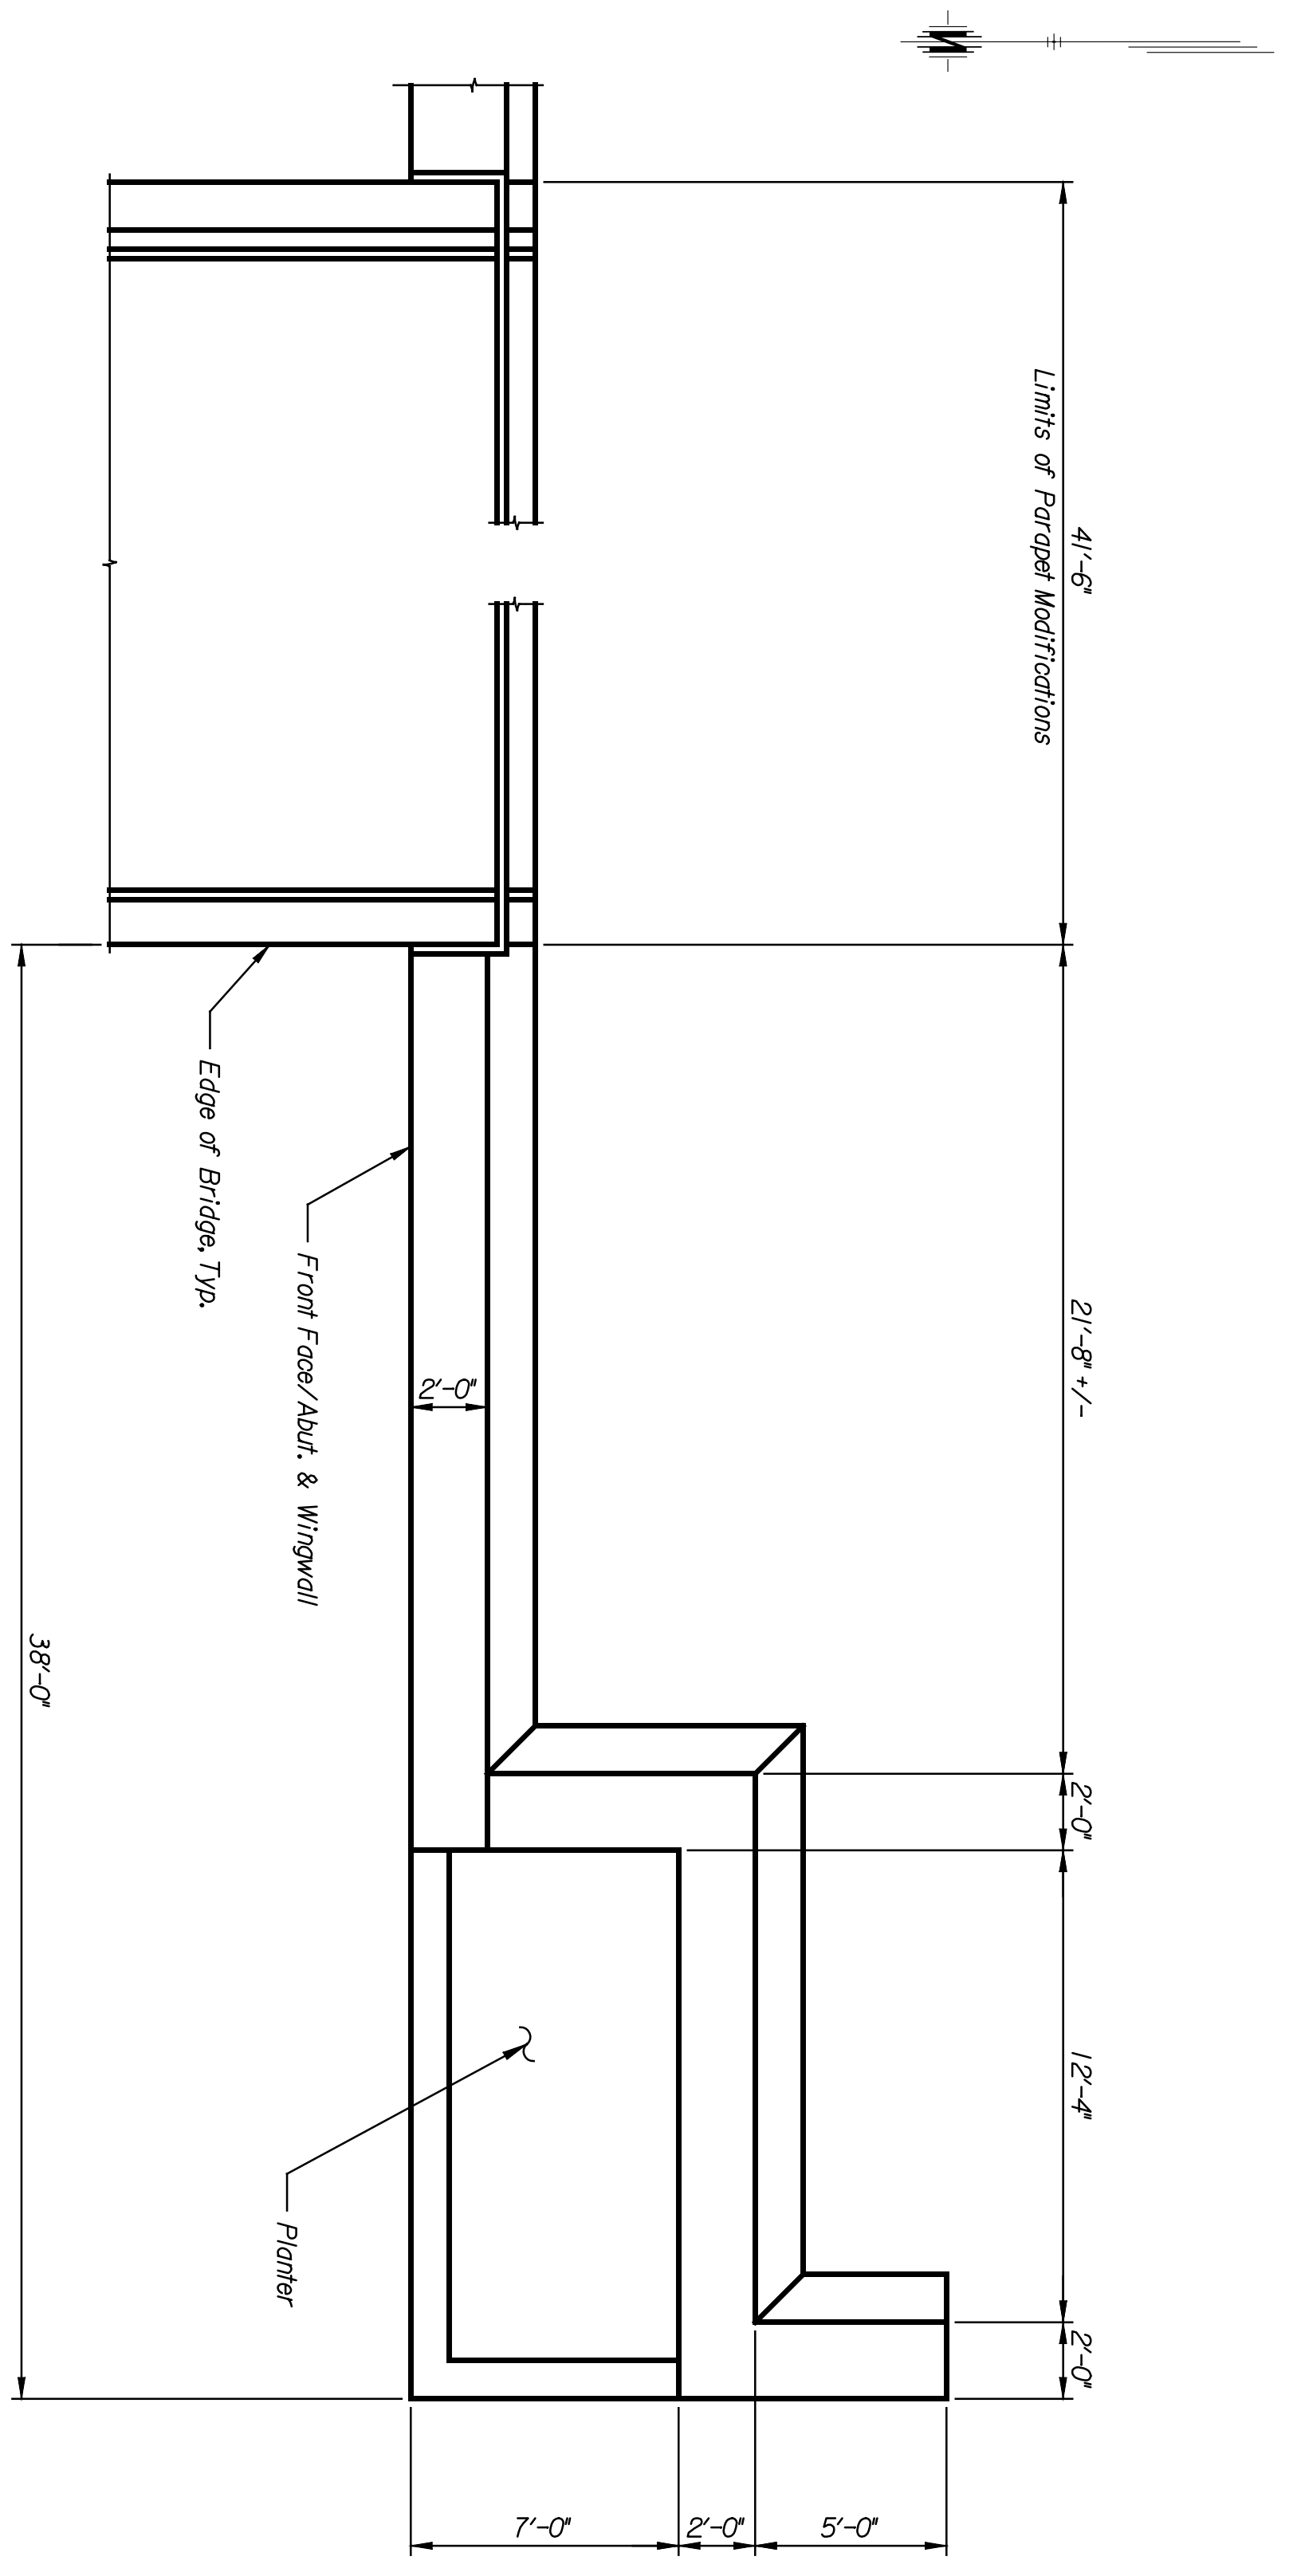

PLAN
 G
 Scale: 1/4" = 1'-0"
 B8.8

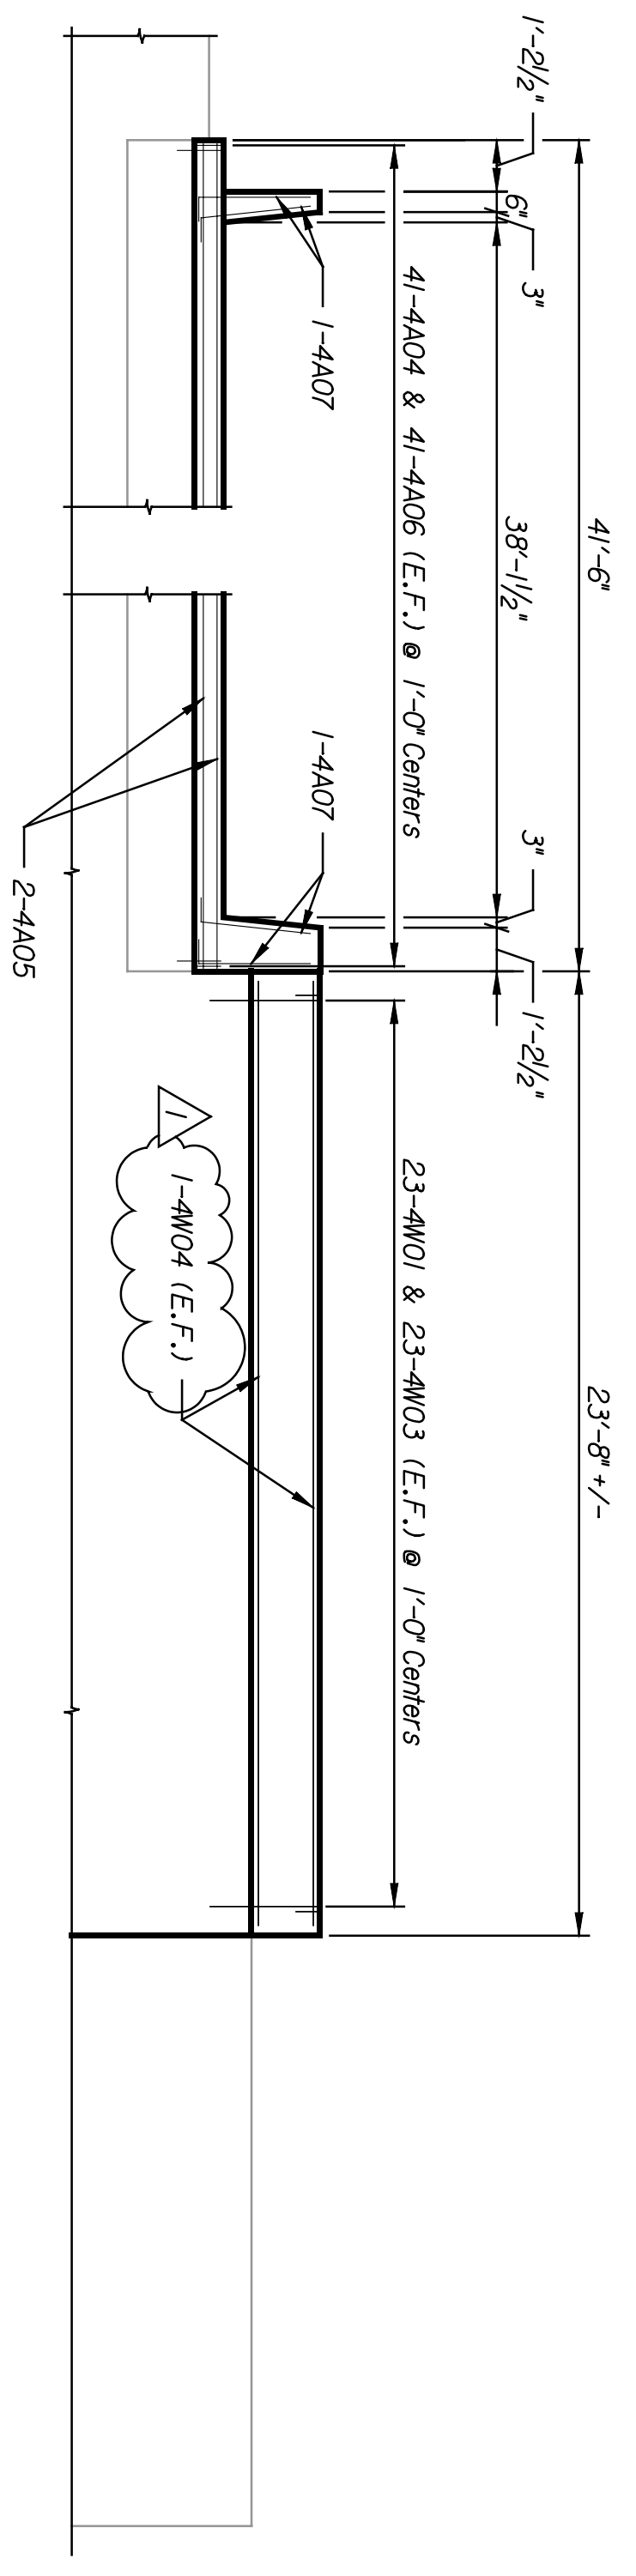


PARAPET AND WINGWALL ELEVATION
 D
 Scale: 1/4" = 1'-0"
 B8.8

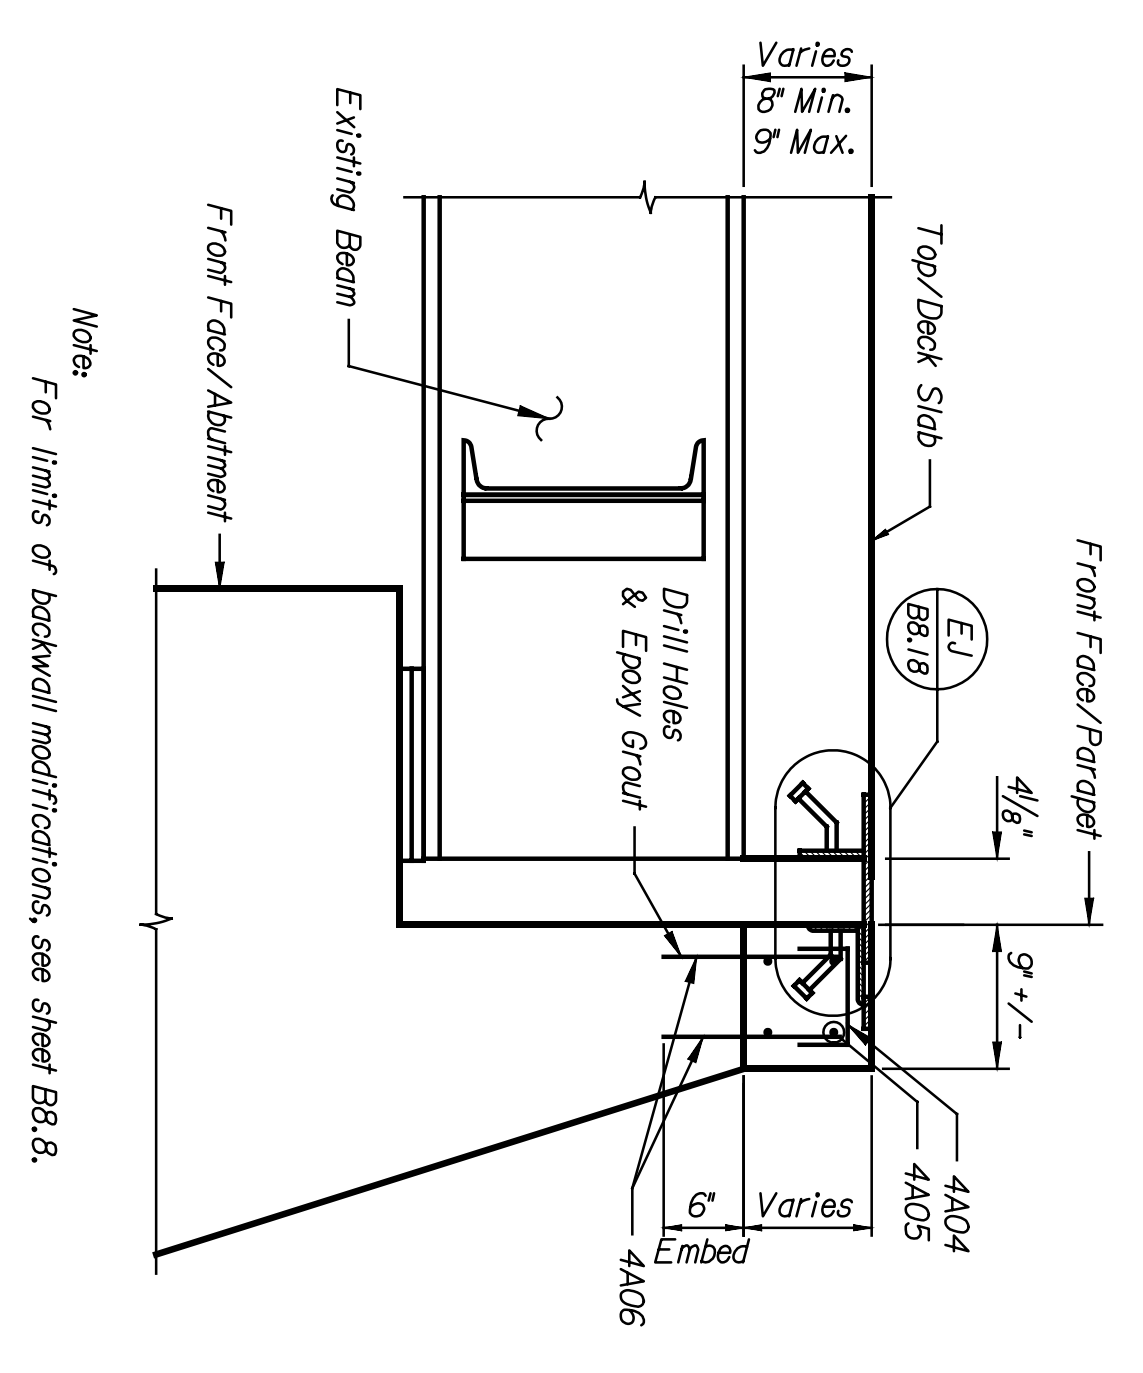

SECTION
 E
 Scale: 1" = 1'-0"
 B8.8

Notes:
 For limits of backwall modifications, see sheet B8.8.

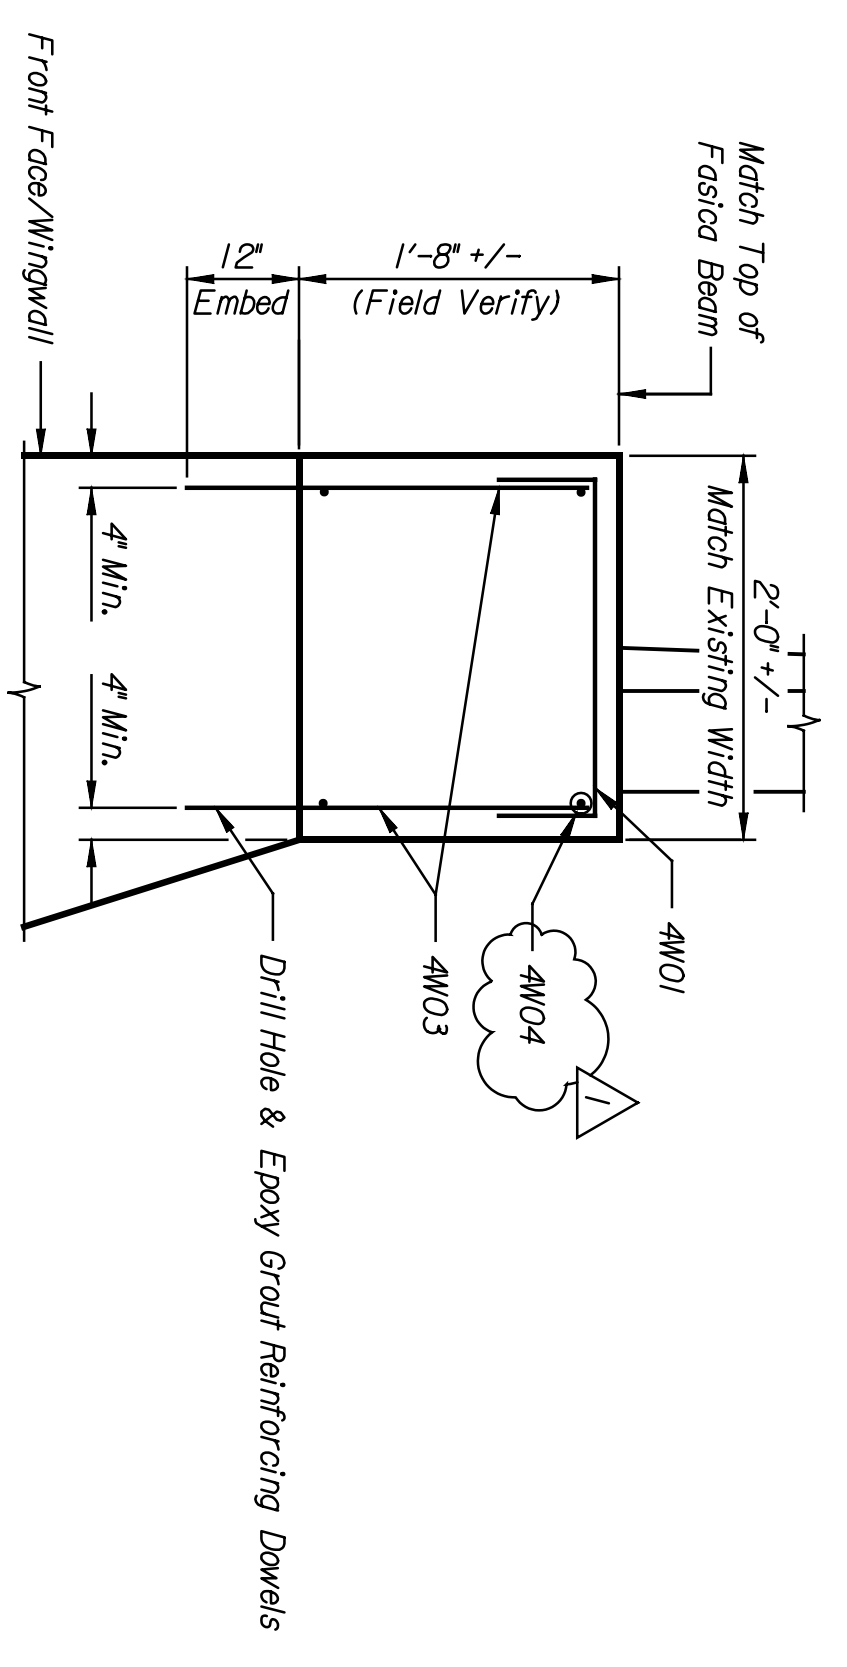

SECTION
 F
 Scale: 1" = 1'-0"
 B8.9

NOTE:
 Hole & Epoxy Grout is subsidiary to concrete.

This sheet designed by:

PNTEB
 ARCHITECTS ENGINEERS PLANNERS

STATE	PROJECT NO.	YEAR	SHEET NO.	TOTAL SHEETS
KANSAS	472-84071	2005	B8.10	

LOCATION:	WICHITA, KS	LINE SEGMENT:	7400
DESIGNED BY:	DMH	SCALE:	AS NOTED/APP'D
DATE:	9/04	REINFORCING CHANGE:	JWH
BY:	JWH	APPR'D:	
CITY OF WICHITA			
DOUGLAS AVENUE			
ABUTMENT 6 DETAILS			
SHEET NO.:	08	QUANTITIES:	DJL
DESIGNER:	DMH	DATE:	9/04
DESIGNER:	JWH	DATE:	9/04