


F.H.W.A. REGION NO.	STATE	PROJECT NO.	FISCAL YEAR	SHEET NO.	TOTAL SHEETS
7	KANSAS	54-87 K-8258-01	2007	516	556

BY	DATE

FINAL SURVEY

XS005
1:100
Plotted:
File: Q:\0001PH2\Vol4\
Drawn by:

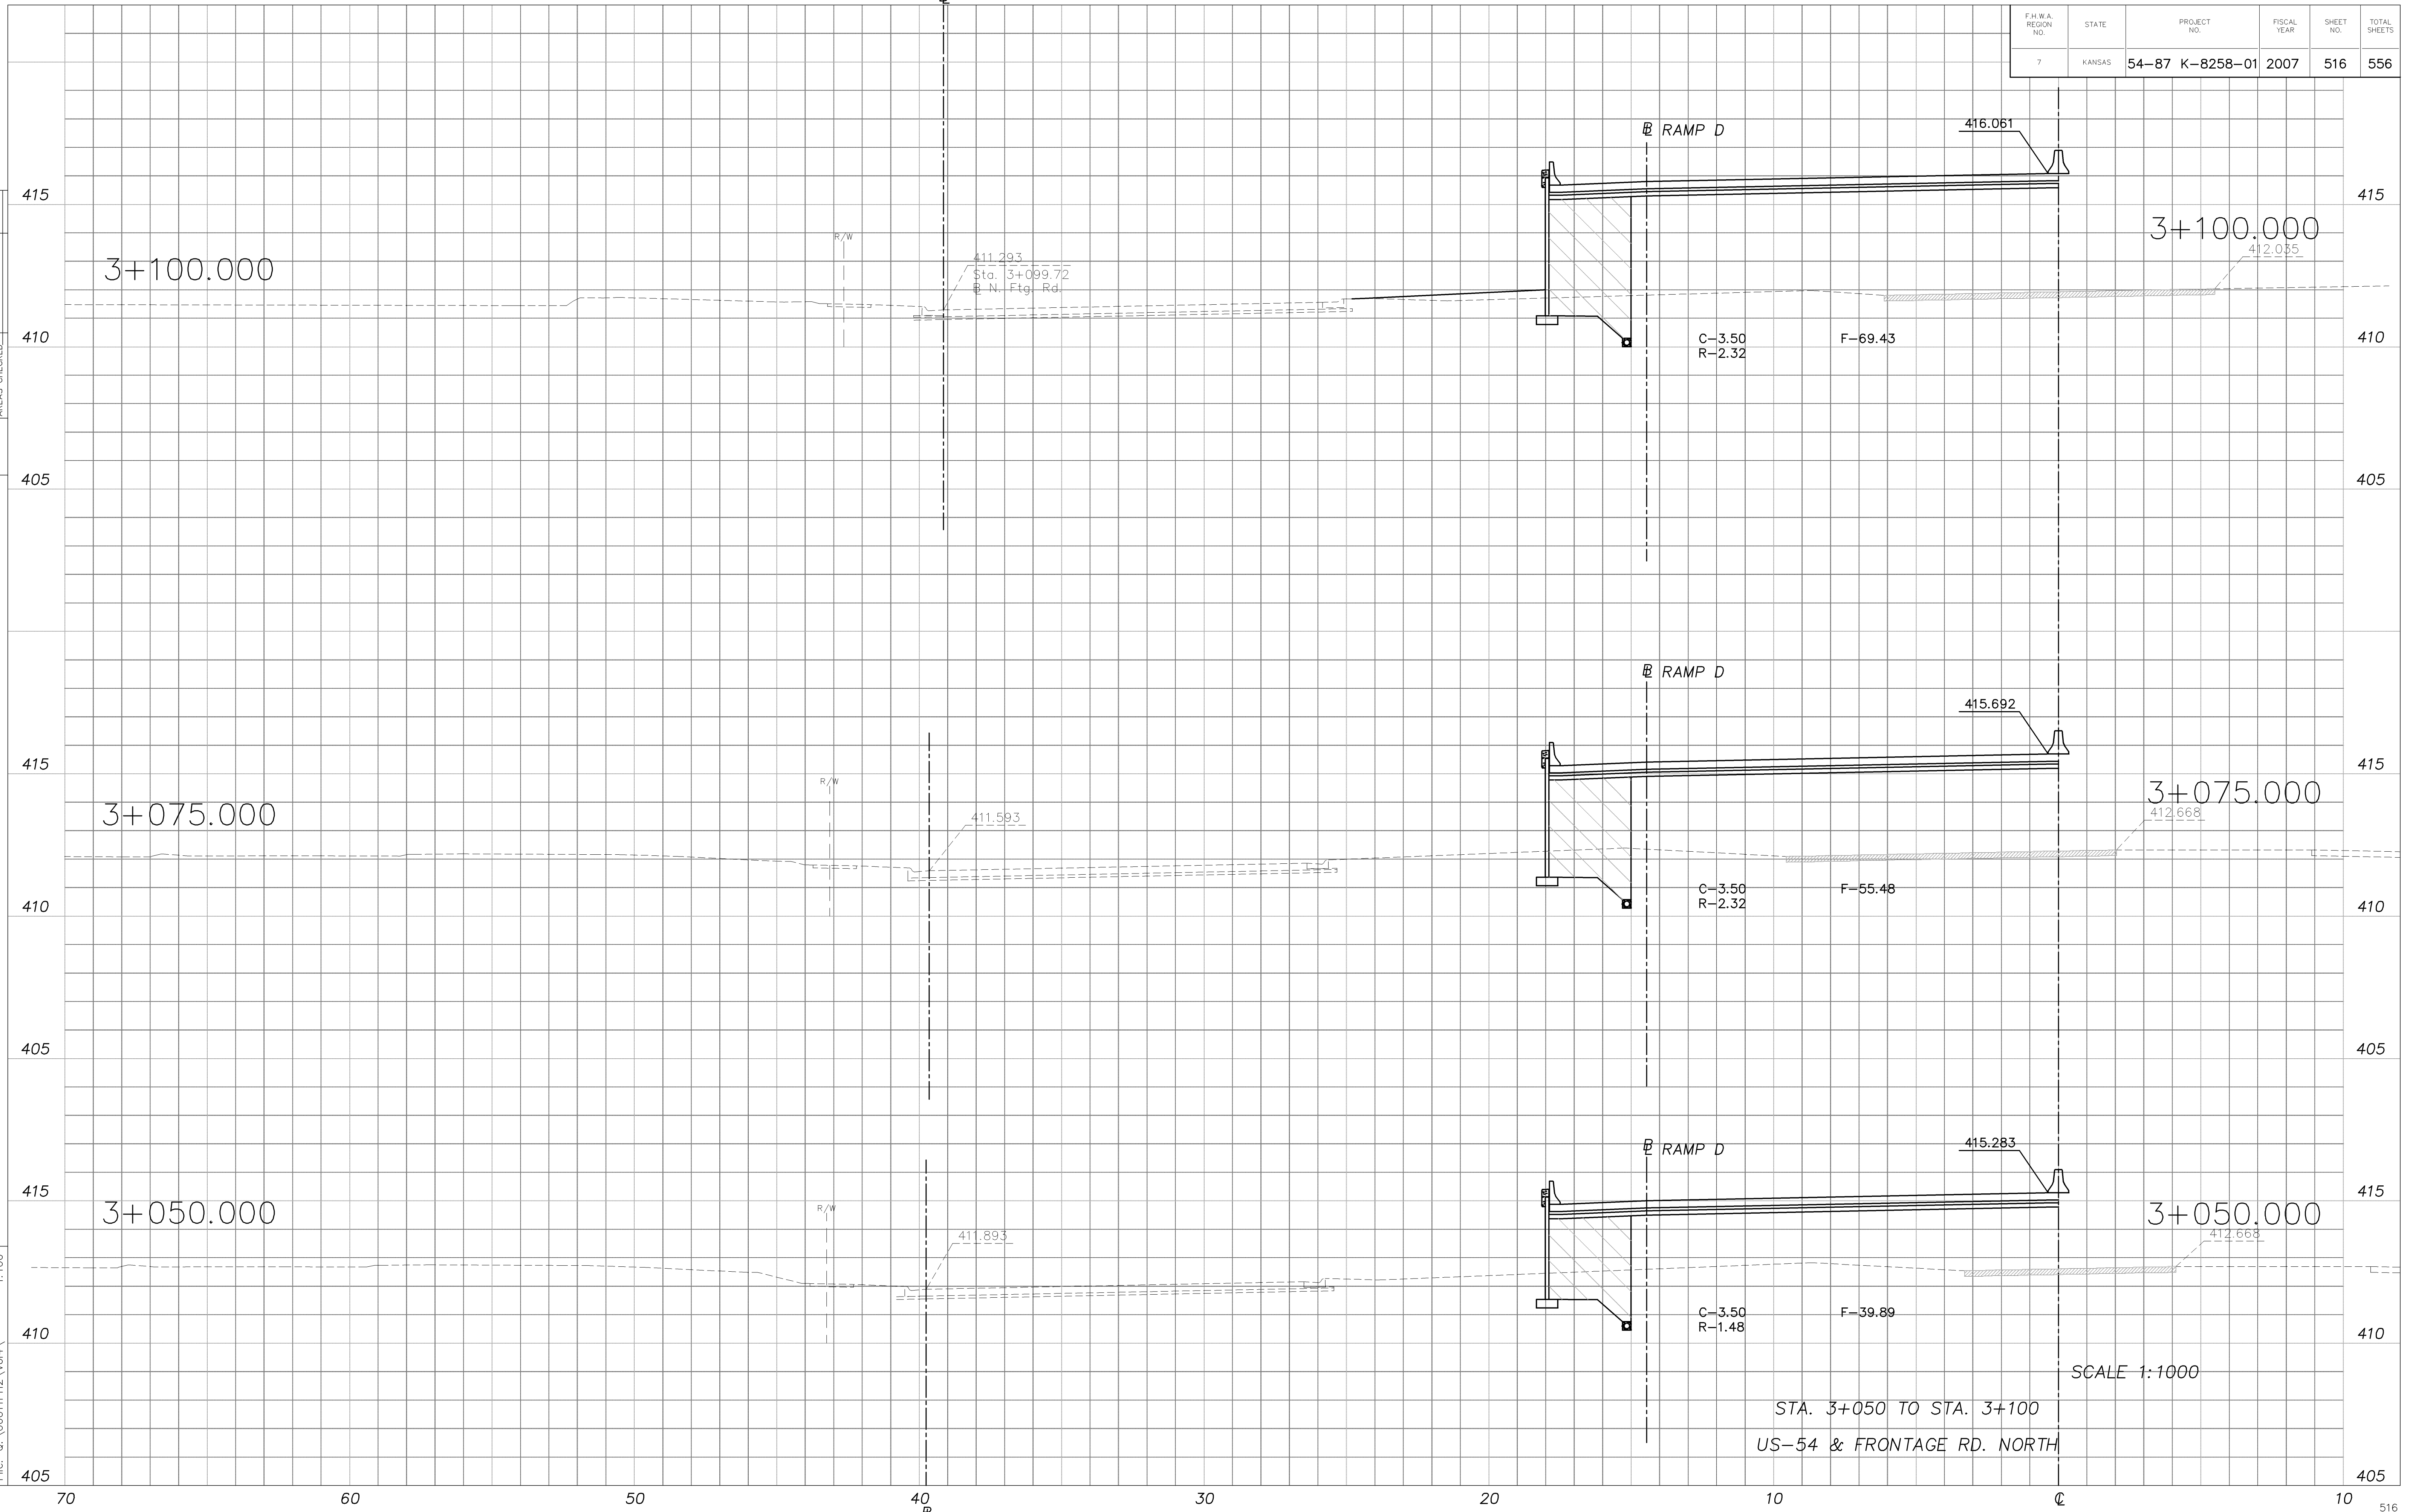

SCALE 1:1000

STA. 3+050 TO STA. 3+100  
US-54 & FRONTAGE RD. NORTH