
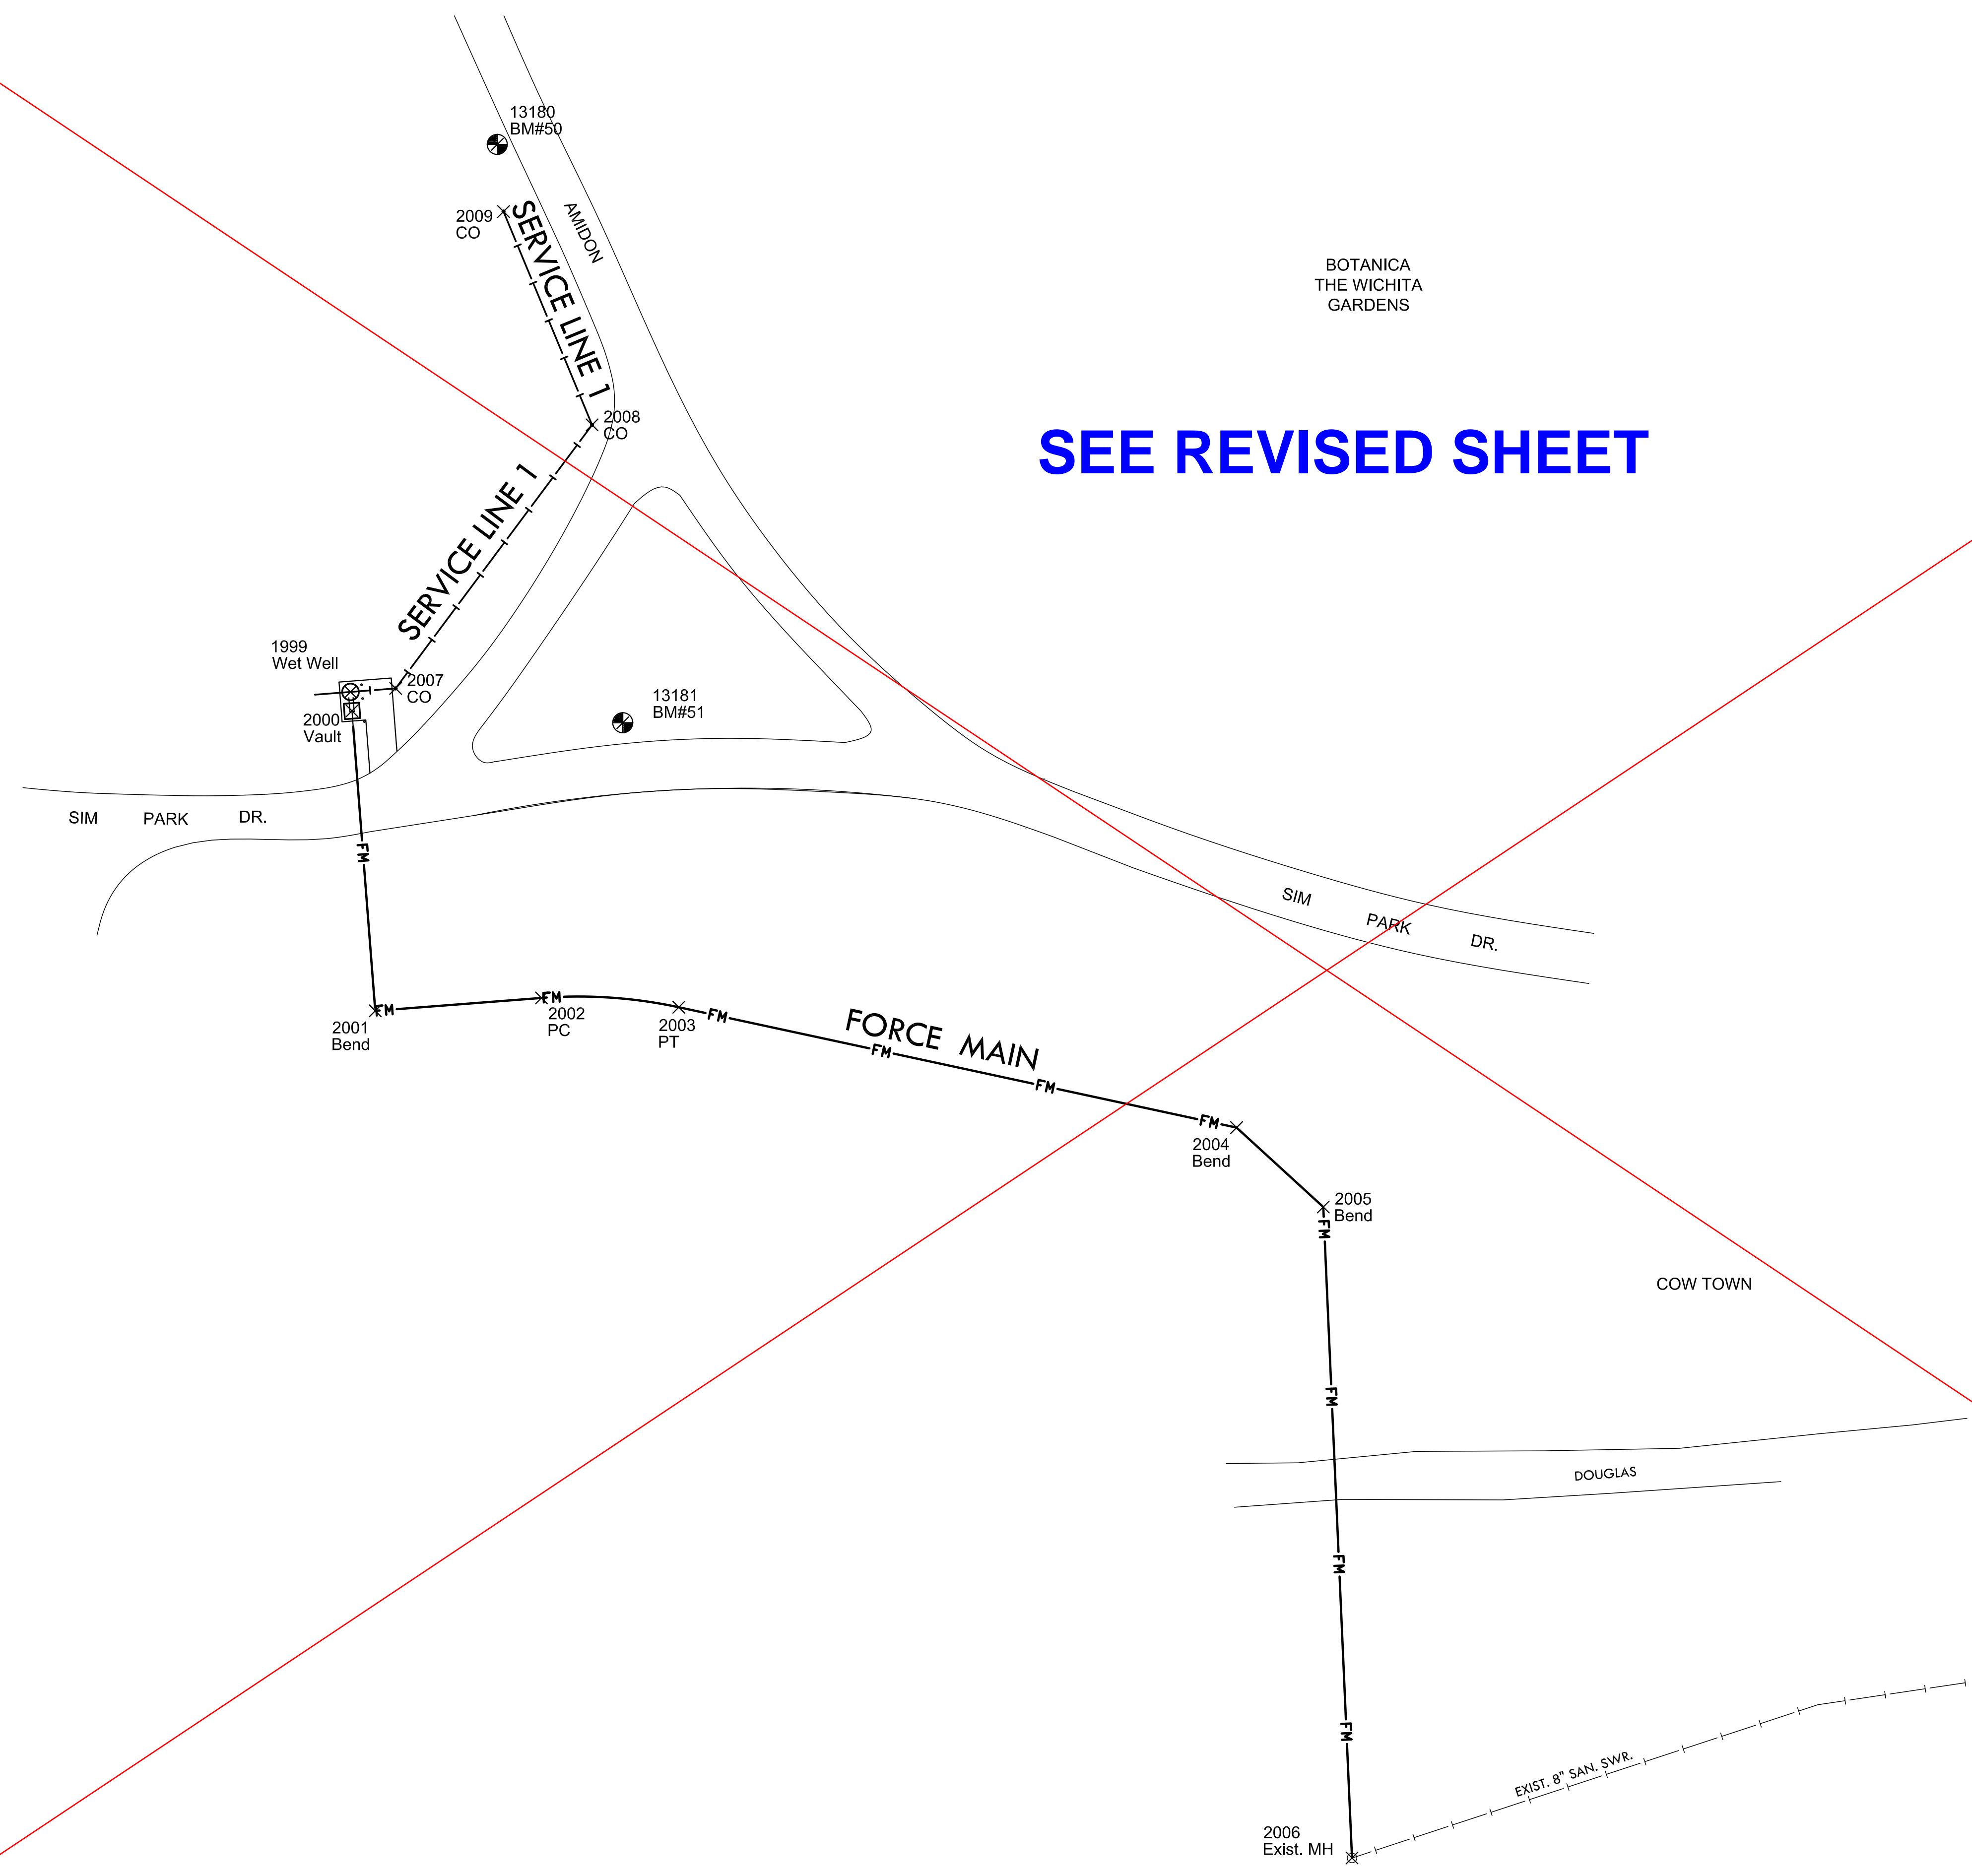


SANITARY SEWER LIFT STATION AND FORCE MAIN
BOTANICA - THE WICHITA GARDENS
 STREETS AND UTILITIES

SEE REVISED SHEET

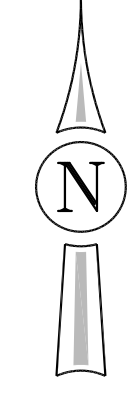

Control Points			
Point No.	Northing	Easting	Description
13180	1689086.87	1640976.10	BM#50
13181	1688844.05	1641028.79	BM#51

Force Main Points			
Number	Northing	Easting	Description
1999	1688856.98	1640914.47	Wet Well
2000	1688849.00	1640915.09	Vault
2001	1688723.07	1640924.85	Bend
2002	1688728.48	1640964.64	PC
2003	1688724.58	1641052.29	PT
2004	1688674.04	1641286.47	Bend
2005	1688640.71	1641322.88	Bend
2007	1688858.45	1640933.41	CO
2008	1688969.09	1641015.89	CO
2009	1689058.68	1640978.70	CO

PLOTTED: Tuesday, July 06, 2010 @ 03:12PM

BUBBLE MAP
 SHEET TITLE
468-84683
 PROJECT NUMBER

DFL
 DESIGN BY
DMU/KKL
 DRAWN BY
GJA
 CHECKED BY

ISSUED
July 2010
 REVISED

SHEET NO.
6 of 29

C:\CHIL\PROJECTS\468\SANITARY\FORCE MAIN\REVISED_BUBBLE_MAP.DWG