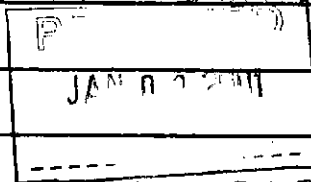


Signed JEFF PETERSONContractor RITCHIESDate 20/00Project BROADWAY TANDY / WILLIAMProject Number 472 B2412000 001 / INDEX CARD (705B63) (87N-0061-01)SWS (SEE AS BUILT)STA 0+121.972 Added Type B to STA 0+203.422CHANGED TO TYPE 10 INLET (PLAN TYPE 12) : 450 mm PCPSTA 0+203.422 Line D changed FROM TYPE 12 TO TYPE 10STA 0+017.190 Line D-2 changed FROM TYPE 12 TO TYPE 10 INLETSTA 0+0245.082 Type 10 cb INLET TO TYPE 10 DRIVE INLETSTA 0+008.655 Line F TO STA 23+222.5 - 4,800 M LTEXIST INLET THIS WAS NOT CHANGED

Signed JOE PETERSONContractor RITCHIES

Date

12/20/00

Project BROADWAY DOWNEY / WILLIAMProject Number 472 07412000 001 / Index Code (705863) (87N-0061-01)

DELETED DRIVEWAY STA 22+903.9 RT and STA 22+919.1 RT CHANGED
TO STA 22+911.9 RT

DELETED DRIVEWAY STA 23+191.350 LT ENLARGED DRIVEWAY
STA 23+178.656 LT

RECEIVED

JAN 11 2001

Signed JEFF PETERSONContractor PITCHESDate 1/20/00Project BROADWAY DEWEY / WILLIAMSProject Number 472 82412000 001 / Index Code (705863) (87N-0061-01)DELETED DRIVEWAYS:STA 23+191.350 LT 3.0m Drive AS per prop. owners
requestSTA 22+903.900 RT 6.80m DriveSTA 22+917.100 LT 6.80m Drive