
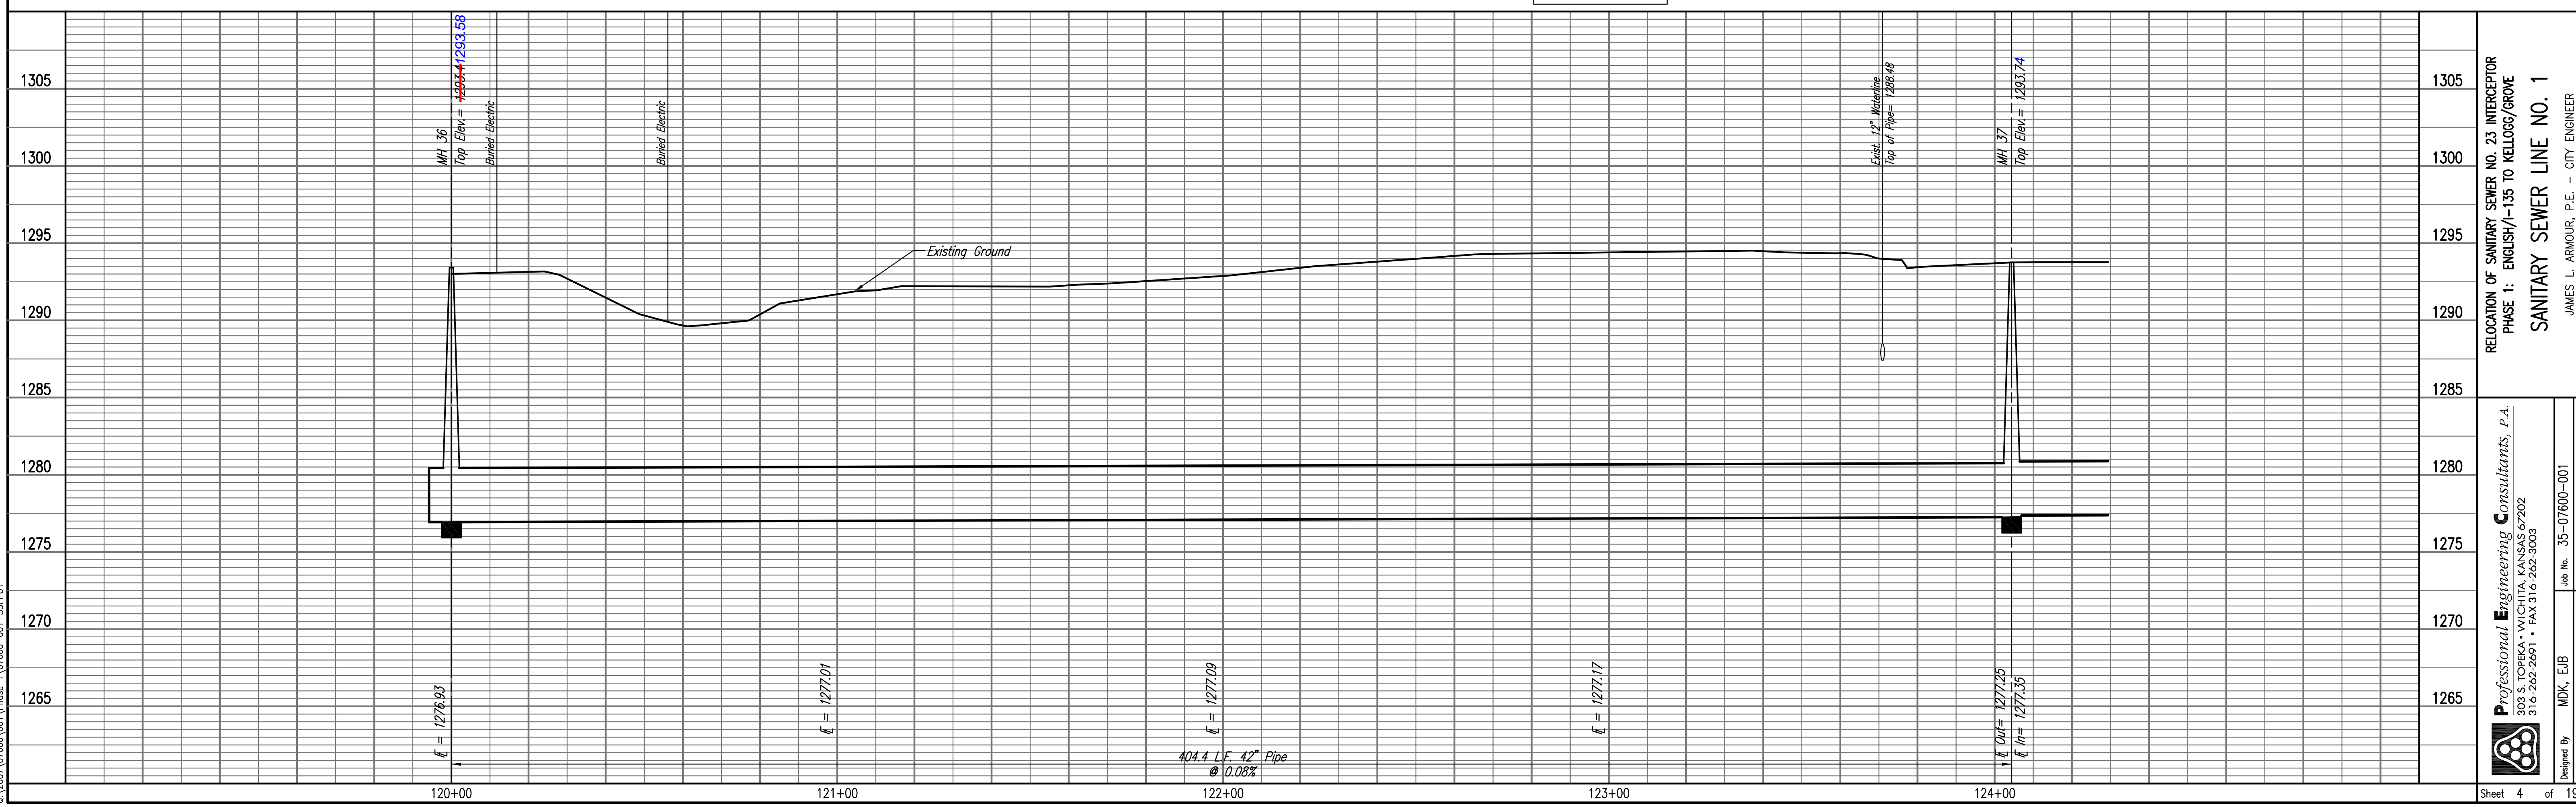
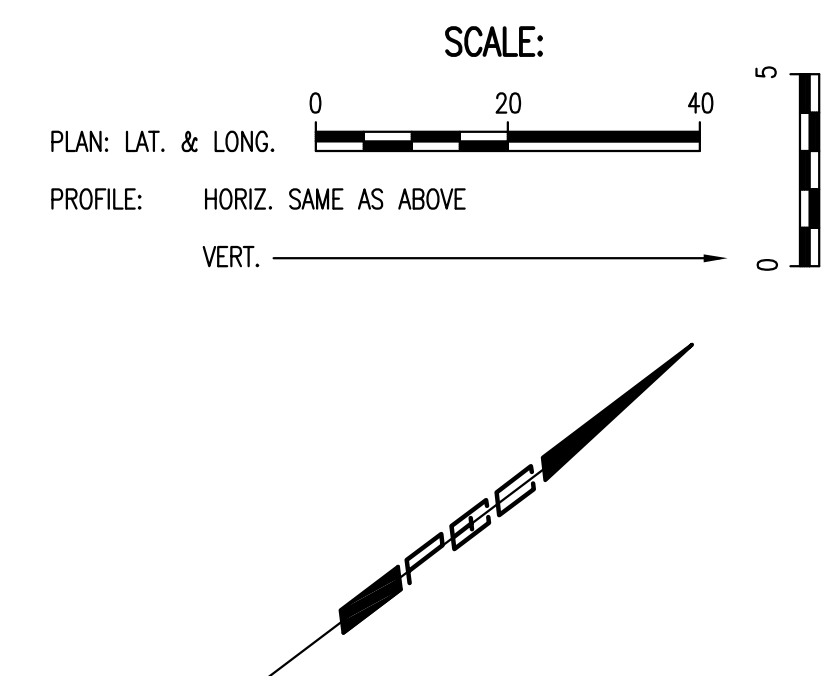


PLAN	CHECKED	DATE
	CHECKED	

PROFILE	CHECKED	DATE
	CHECKED	

Saved: 01-29-2007 09:20:00 AM by: JAM  
 Plot Scale: 1" = 40' (Horizontal), 1" = 4' (Vertical)  
 02/2007/07600/001/Phase 1/07600-01-SSPP01

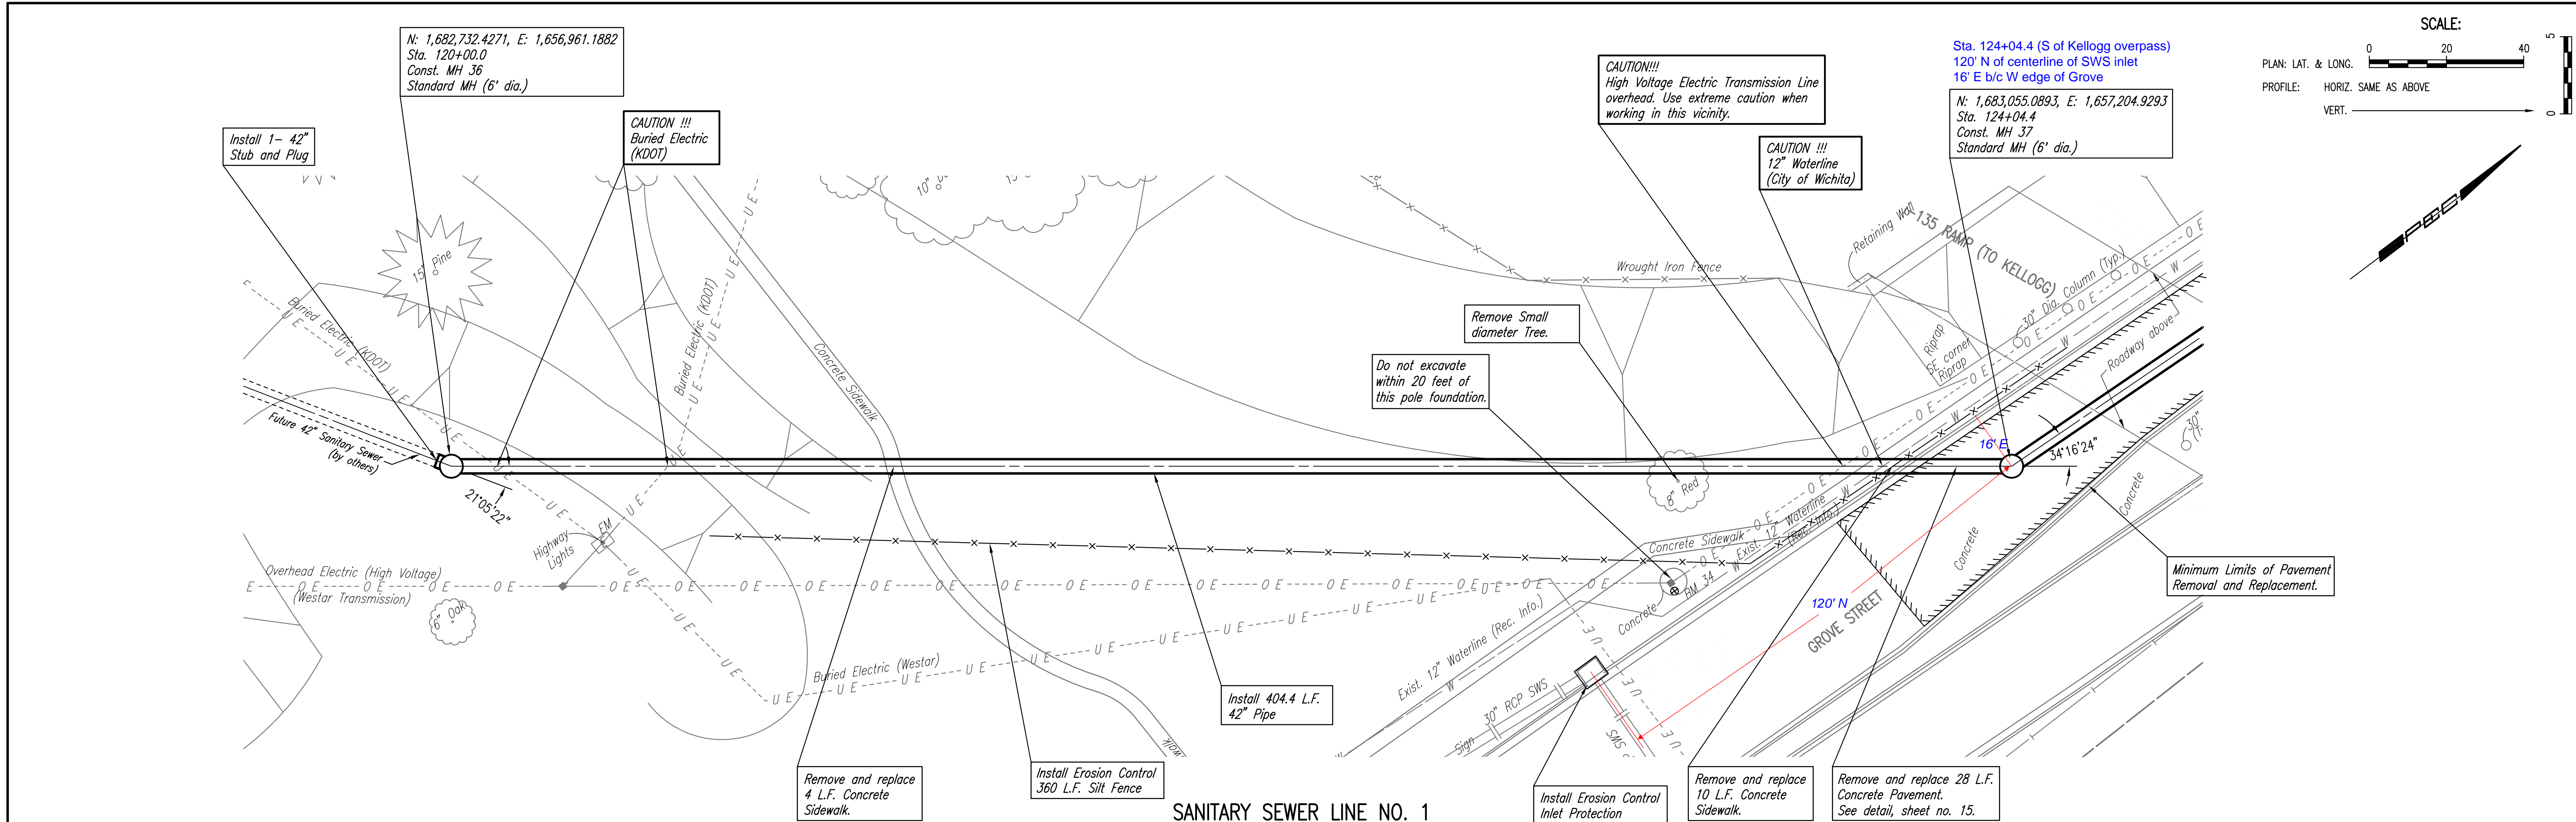

RELOCATION OF SANITARY SEWER NO. 23 INTERCEPTOR  
 PHASE 1: ENGLISH/1-155 TO KELLOGG/GROVE  
**SANITARY SEWER LINE NO. 1**  
 JAMES L. ARMOUR, P.E. - CITY ENGINEER  
 CITY OF WICHITA PROJECT NO. 468-84375

Professional Engineering Consultants, P.A.  
 603 S. TOPICKA AVENUE, WICHITA, KANSAS 67202  
 316-262-2691 • FAX 316-262-3003

Designed By: MDK, EJB  
 Drawn By: CSL, RWJ  
 Job No.: 35-07600-001  
 Date: AUGUST 2008

Sheet 4 of 19