
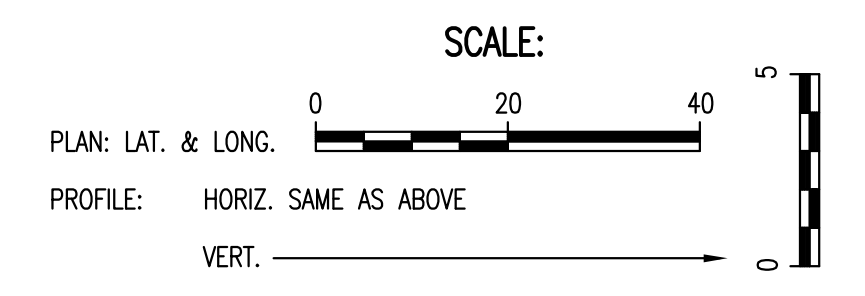



PLAN	CHECKED	BY	DATE
	CHECKED		

PROFILE	CHECKED	BY	DATE
	CHECKED		

Saved: 02-02-2009 9:49:04 AM by CSI
 Plot Scale: 1:20 02-03-2009 2:46:28 PM
 Q:\2007\07600\001\Phase 1\07600-01-SSPP04

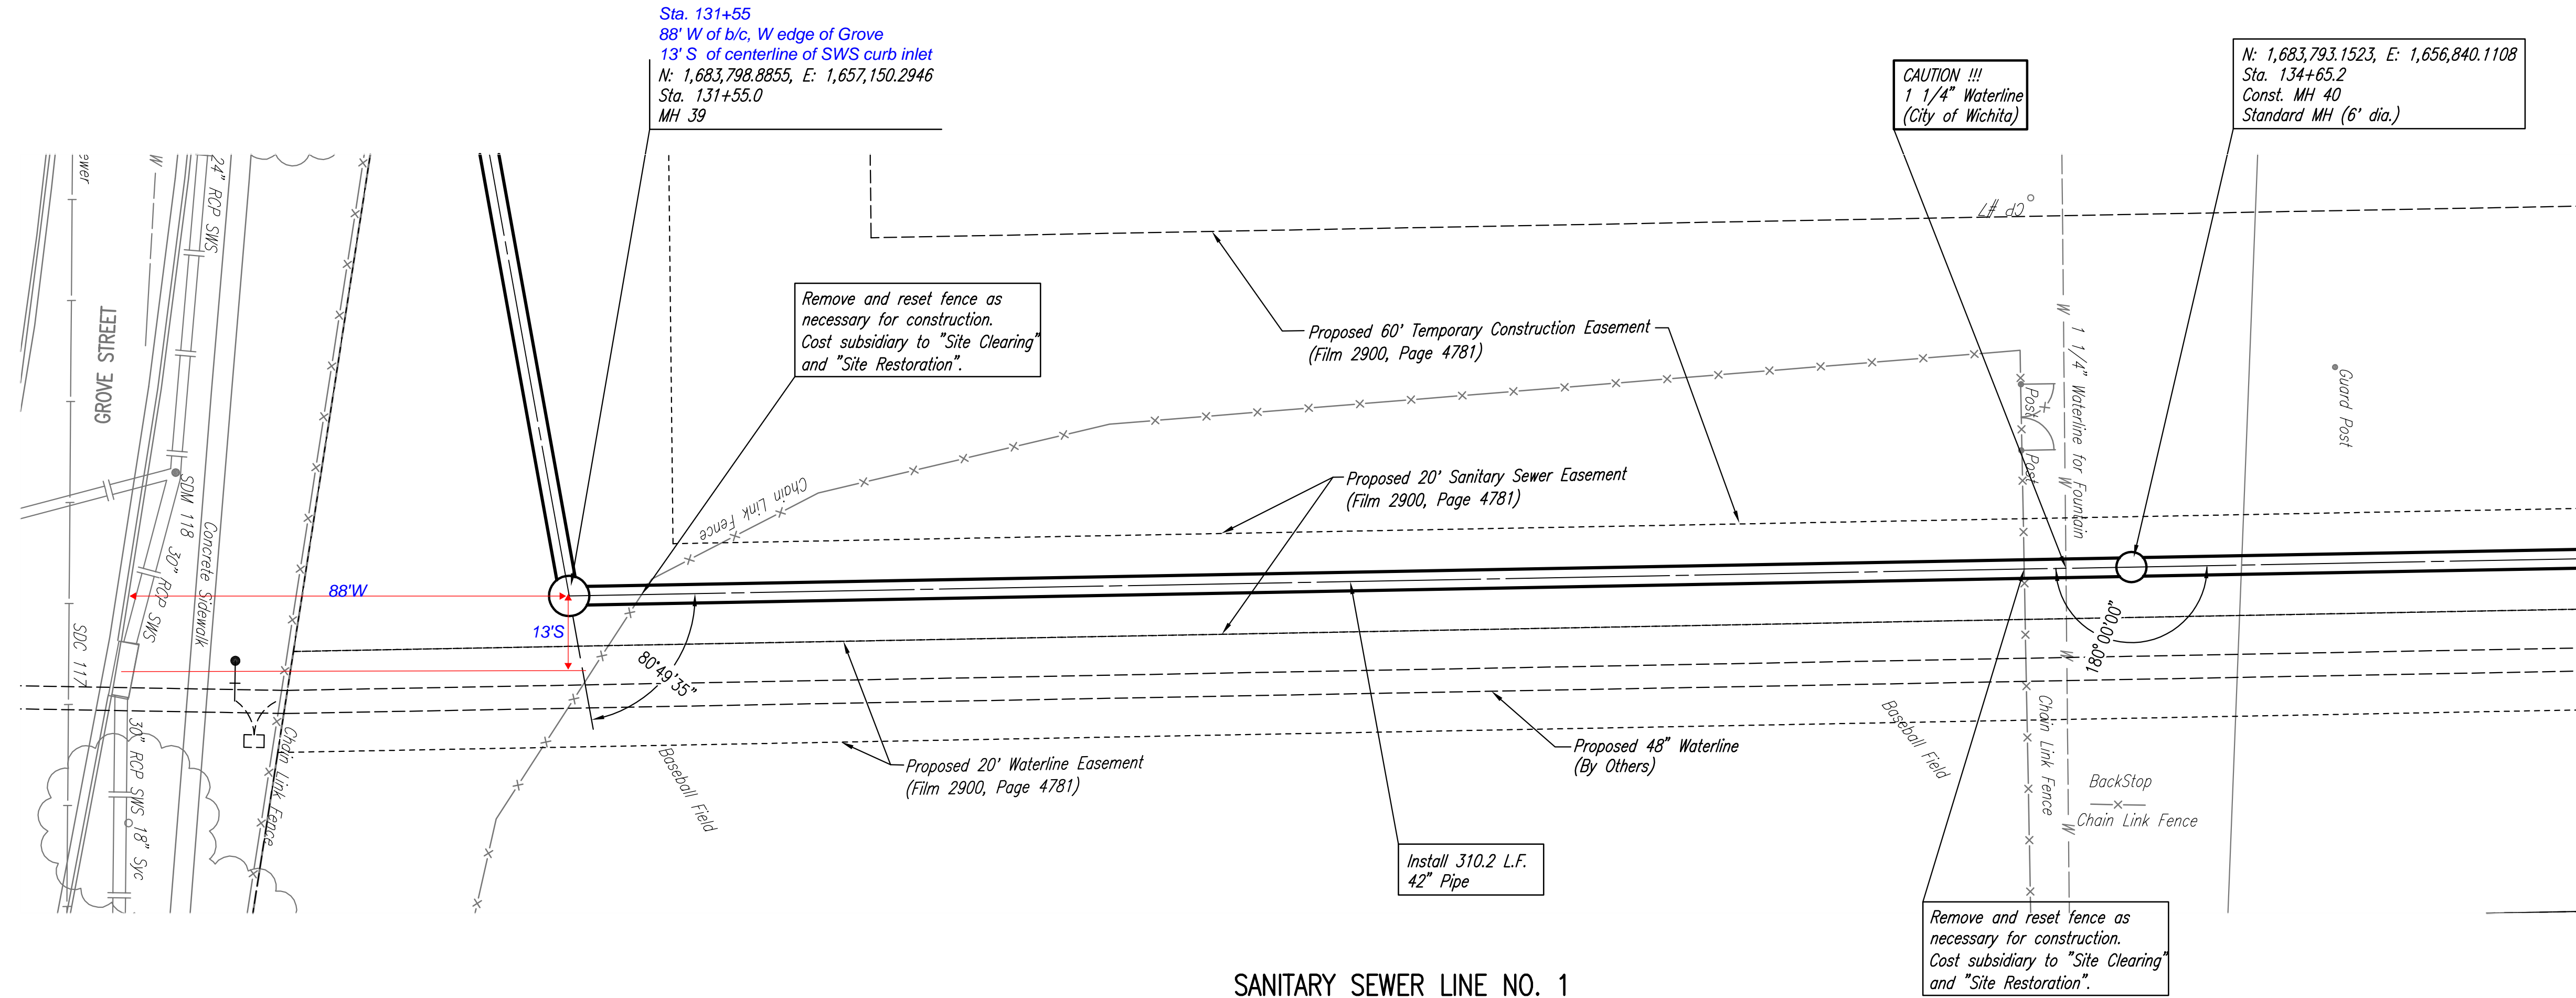

SANITARY SEWER LINE NO. 1

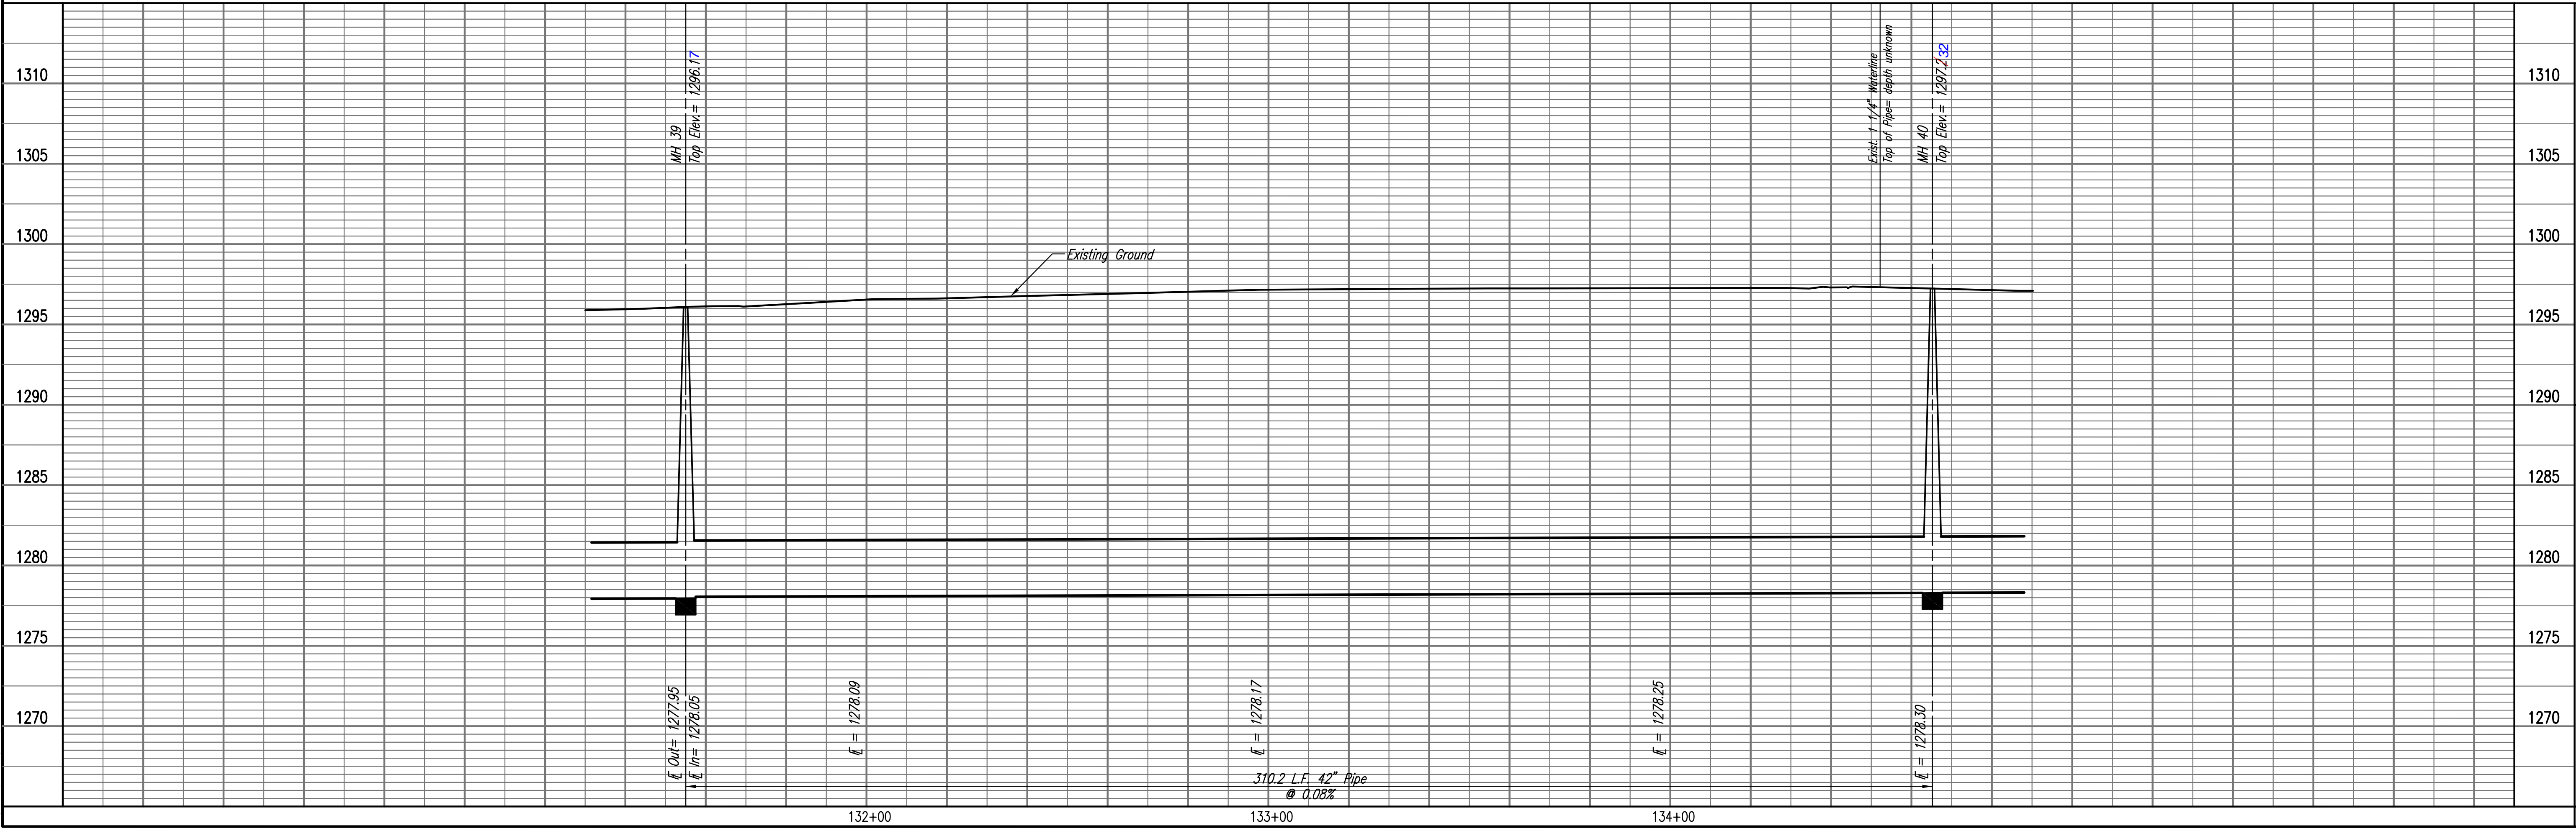

RELOCATION OF SANITARY SEWER NO. 23 INTERCEPTOR
 PHASE 1: ENGLISH/1-155 TO KELLOGG/GROVE
SANITARY SEWER LINE NO. 1
 JAMES L. ARMOUR, P.E. - CITY ENGINEER
 CITY OF WICHITA PROJECT NO. 468-84375

Professional Engineering Consultants, P.A.
 603 S. TOPICKA AVENUE, WICHITA, KANSAS 67202
 316-262-2691 • FAX 316-262-3003

Job No. 35-07600-001 Date AUGUST 2008
 Designed By MDK, EIB Drawn By CSL, RWL

Sheet 7 of 19