
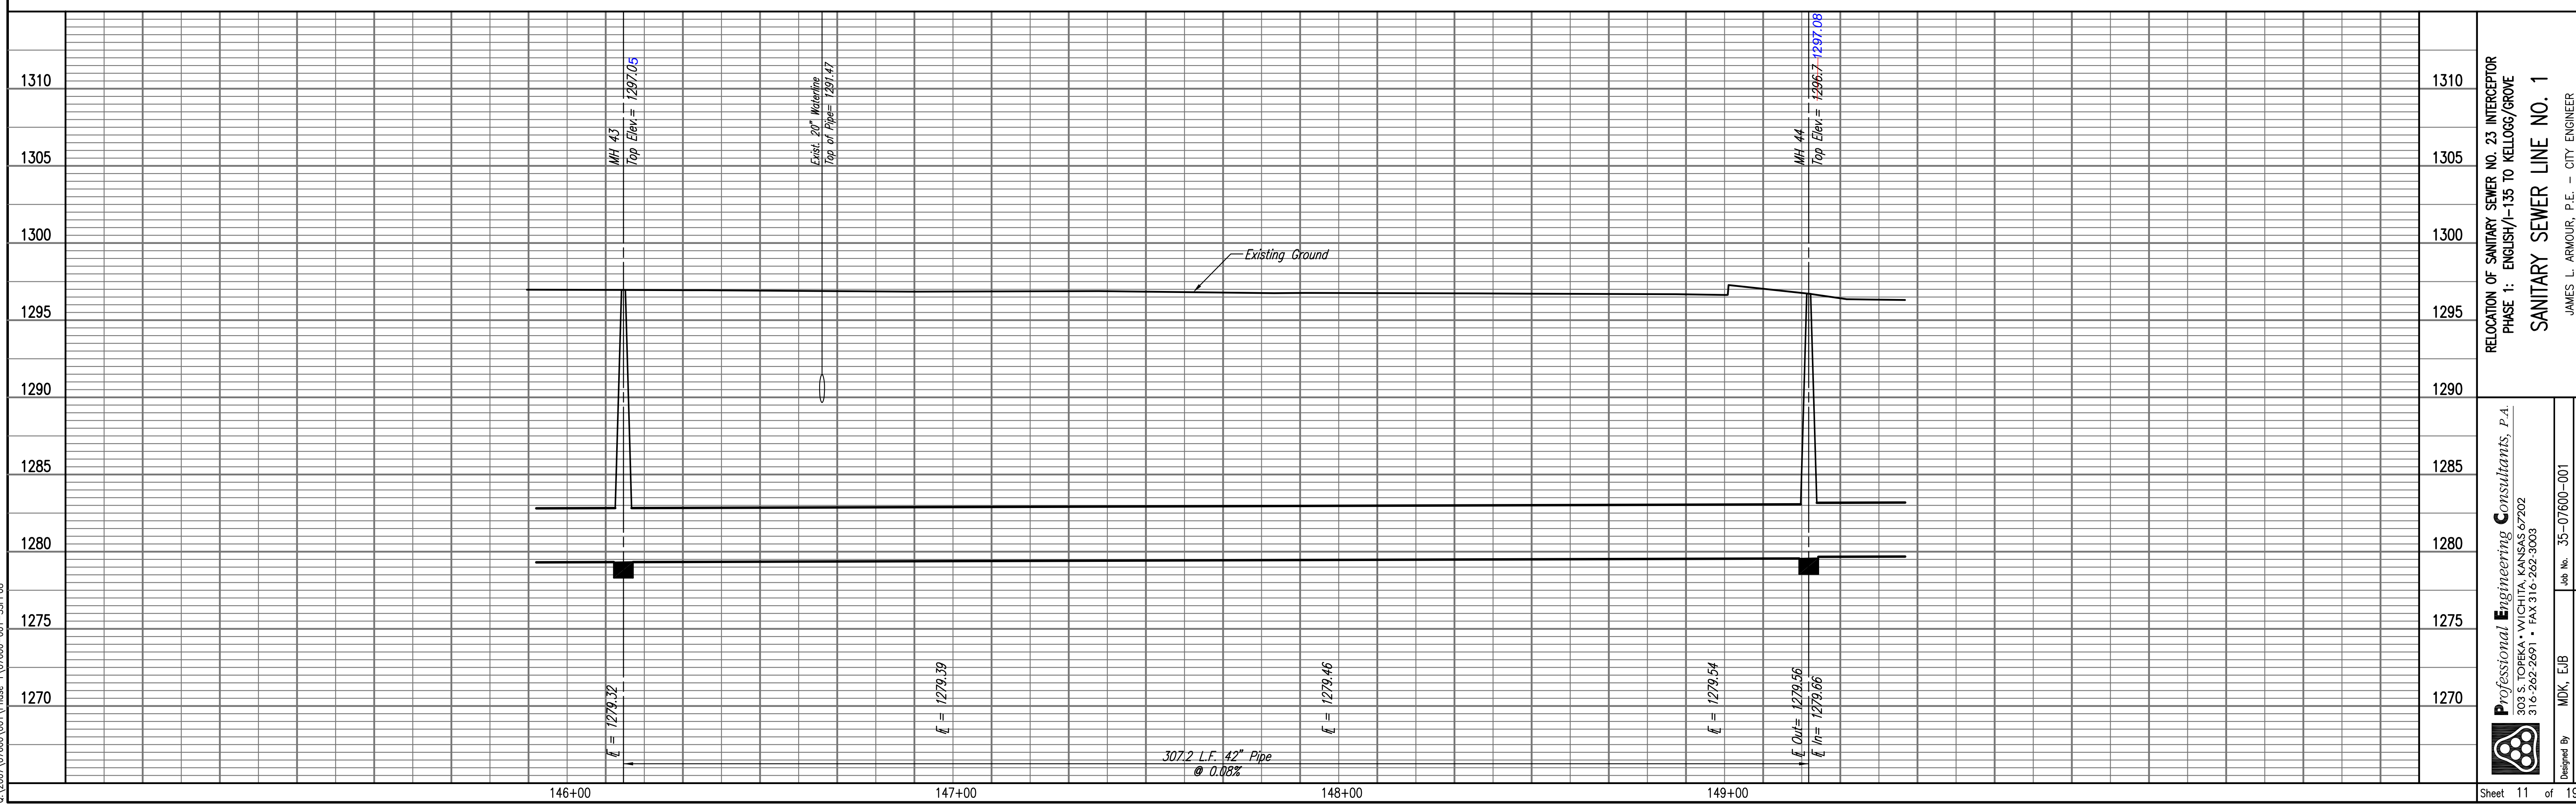


PLAN	CHECKED	DATE
	CHECKED	

PROFILE	CHECKED	DATE
	CHECKED	

Saved: 02-02-2009 10:17:38 AM by CSI  
 Plot Scale: 1/20 02-03-2009 2:42:49 PM by JMN  
 Q:\2007\07600\001\Phase 1\07600-01-55PP08

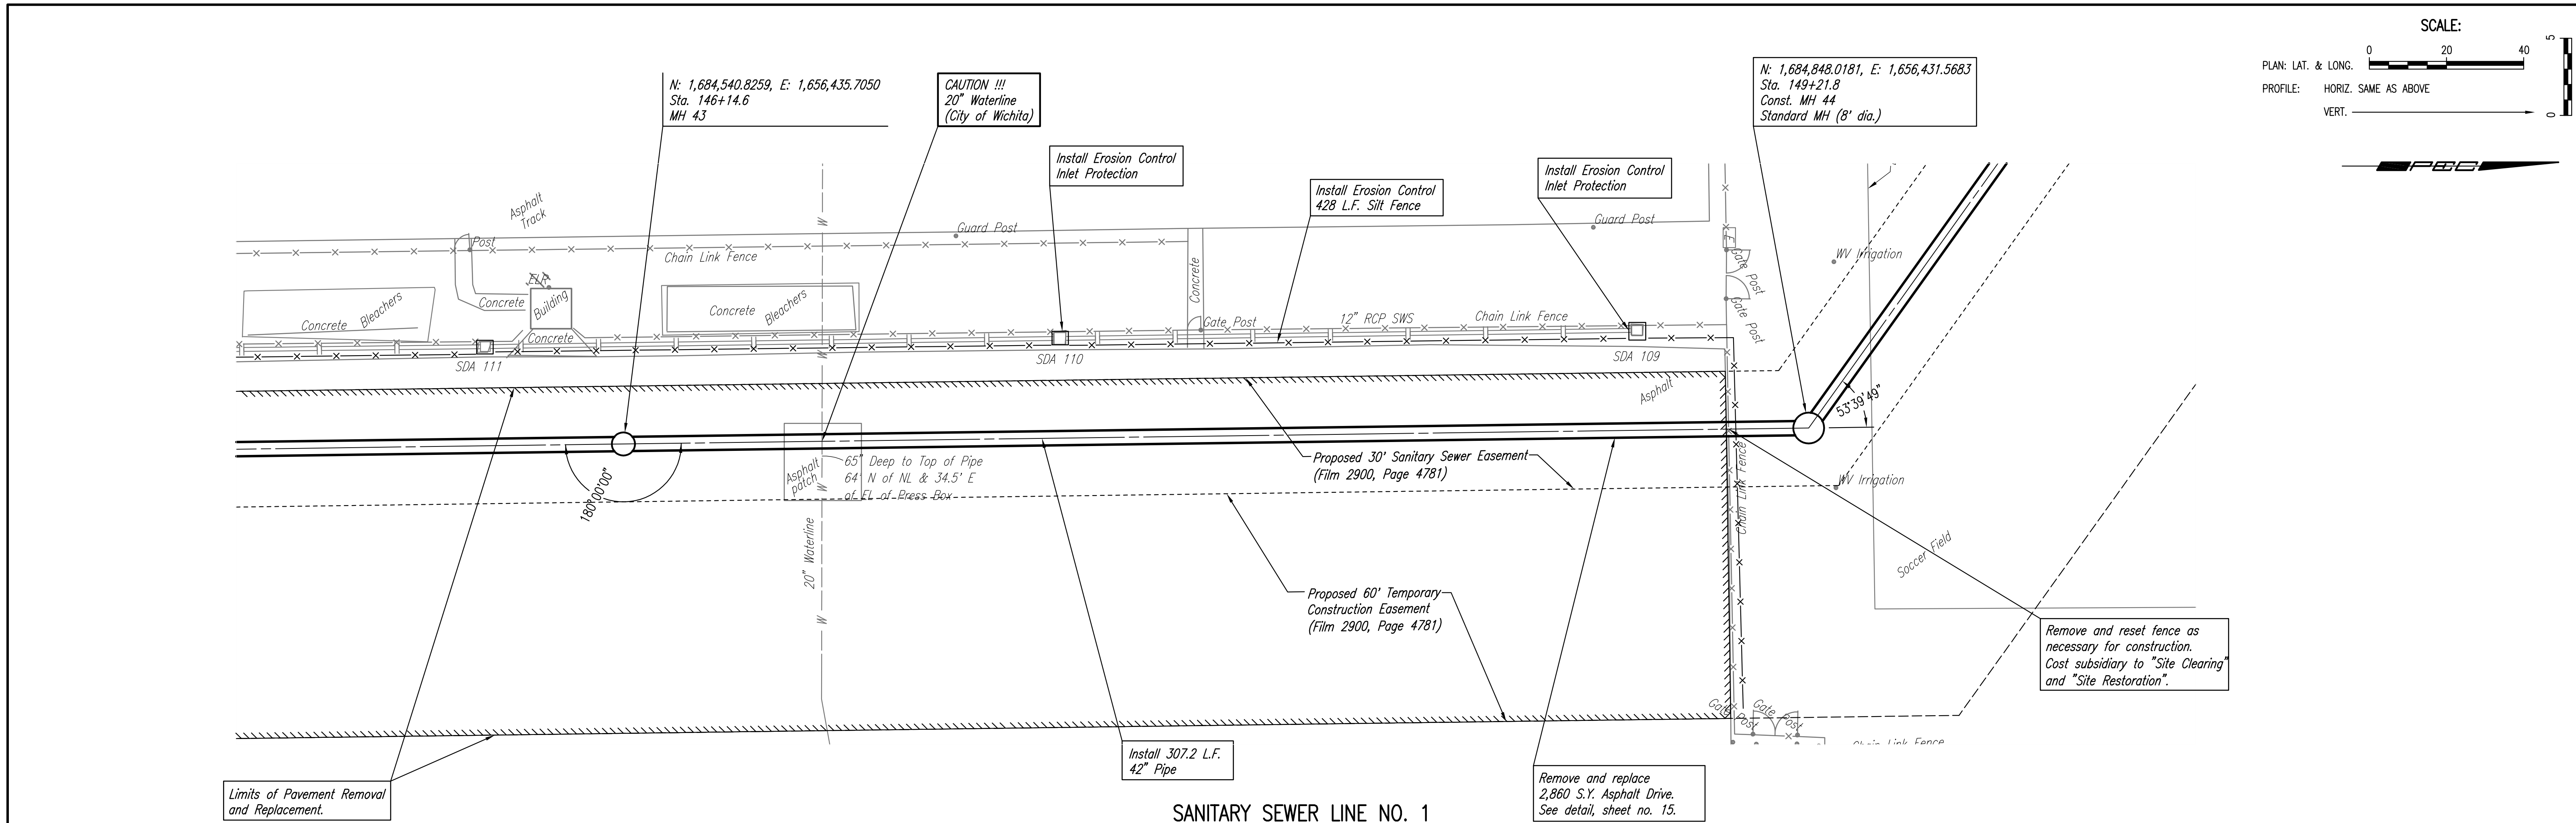

Professional Engineering Consultants, P.A.  
 316-262-2691 • FAX 316-262-3003

Designed By: MDK, EJB  
 Drawn By: CSL, RWJ

 Date: AUGUST 2008

RELOCATION OF SANITARY SEWER NO. 23 INTERCEPTOR  
 SANITARY SEWER LINE NO. 1

JAMES L. ARMOUR, P.E. - CITY ENGINEER  
 CITY OF WICHITA PROJECT NO. 468-84375

Sheet 11 of 19