WATER DISTRIBUTION SYSTEM IMPROVEMENTS

TO SERVE

PARATRANSIT VAN MAINTENANCE FACILITY

PRIVATE PROJECT NO. 1520 PPW (607853)

CITY OF WICHITA, KANSAS

JAMES L. ARMOUR, P.E. - CITY ENGINEER

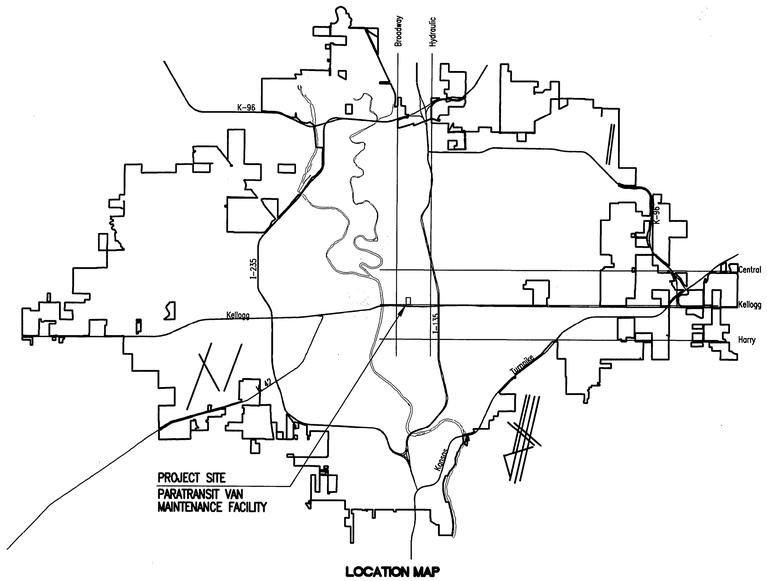

LOCATION MAP

INDEX OF SHEETS

SHEET NO. CV2.1	TITLE SHEET
SHEET NO. CV2.2	KEY MAP AND GENERAL NOTES
SHEET NO. CV2.3	STANDARD DETAILS
SHEET NO. CV2.4	PLAN/PROFILE
SHEET NO. CV3.1-3.3	SOIL EROSION BMP DETAILS
SHEET NO. CV4.1	PLAT

APPROVED AS NOTED
BY CITY ENGINEER OF WICHITA,
BY WICHITA WATER UTILITIES,
& BY WICHITA FIRE DEPARTMENT

Water Mains (Public Works) 3/10/10

Water Mains (Water Utilities) 3-10-10

Fire Prot. Line 3-11-2010

NOTE TO CONTRACTORS

PUBLIC PROPERTY:
Inspection and testing for the waterline is to be provided by a Licensed Consulting Engineering Firm under contract with the Owner/Developer. Said inspection to be in accordance with the City of Wichita standard construction engineering practices and certified by a Licensed Professional Engineer licensed in the State of Kansas. No work shall be performed in dedicated easements or public right-of-way by the Contractor without such inspection nor shall any work be commenced without written authorization by the City Engineer. All Construction and Materials shall comply with the City of Wichita Specifications and Standards (on file and available in the City Engineer's Office).

PRIVATE PROPERTY:
Installation and testing for the fire protection line is to be performed by a City of Wichita licensed fire protection contractor in accordance with the fire codes as adopted by the City of Wichita. All materials and construction practices for the fire protection line shall comply with the fire codes as adopted by the City of Wichita (available from the City of Wichita Fire Department). The Contractor shall not commence work without notification and approval of the Wichita Fire Department.
Inspection of the fire protection line is to be provided by the City of Wichita Fire Department and by a licensed Consulting Engineering Firm under contract with the Owner/Developer.
The contractor shall not start work until the project inspector is assigned to the project and present on the site. Any work done without inspection will be required to be uncovered for inspection.

MARCH 2010

PLANS PREPARED BY

PROFESSIONAL ENGINEERING CONSULTANTS, P.A.

ENGINEERS

WICHITA, KANSAS

As Built Plans:
CONTRACTOR: McCullough Excavation
INSPECTOR: Larry Gann,
COMPANY: K E Miller Engineering
.PDF by: LGG, 08-18-2010

McCLUGGAGE VAN SICKLE & PERRY
125 S. WASHINGTON WICHITA, KANSAS 67202
P.O. BOX 3348 WICHITA, KANSAS 67201
PH. 316.262.0461 FAX 316.262.6465

CITY OF WICHITA
TRANSIT VAN MAINTENANCE / STORAGE FACILITY PROJECT
Wichita, Kansas

JOSEPH E. HICKLE
LICENSED
2021
3-10-10
KANSAS
PROFESSIONAL ENGINEER

109045
DATE: 01/11/2010
REVISIONS

Professional Engineering Consultants, P.A.
303 S. TOPEKA • WICHITA, KANSAS 67202 • 316-262-2691 • FAX 316-262-8003
www.pec1.com

CITY OF WICHITA

TITLE SHEET

CV2.1

Saved 03-09-2010 11:00:38 AM by MJC
Plotted 03-10-2010 12:34:55 PM by MJC
O:\2009\0860\A1000\PPW\0860-A1000-C-PPW.dwg