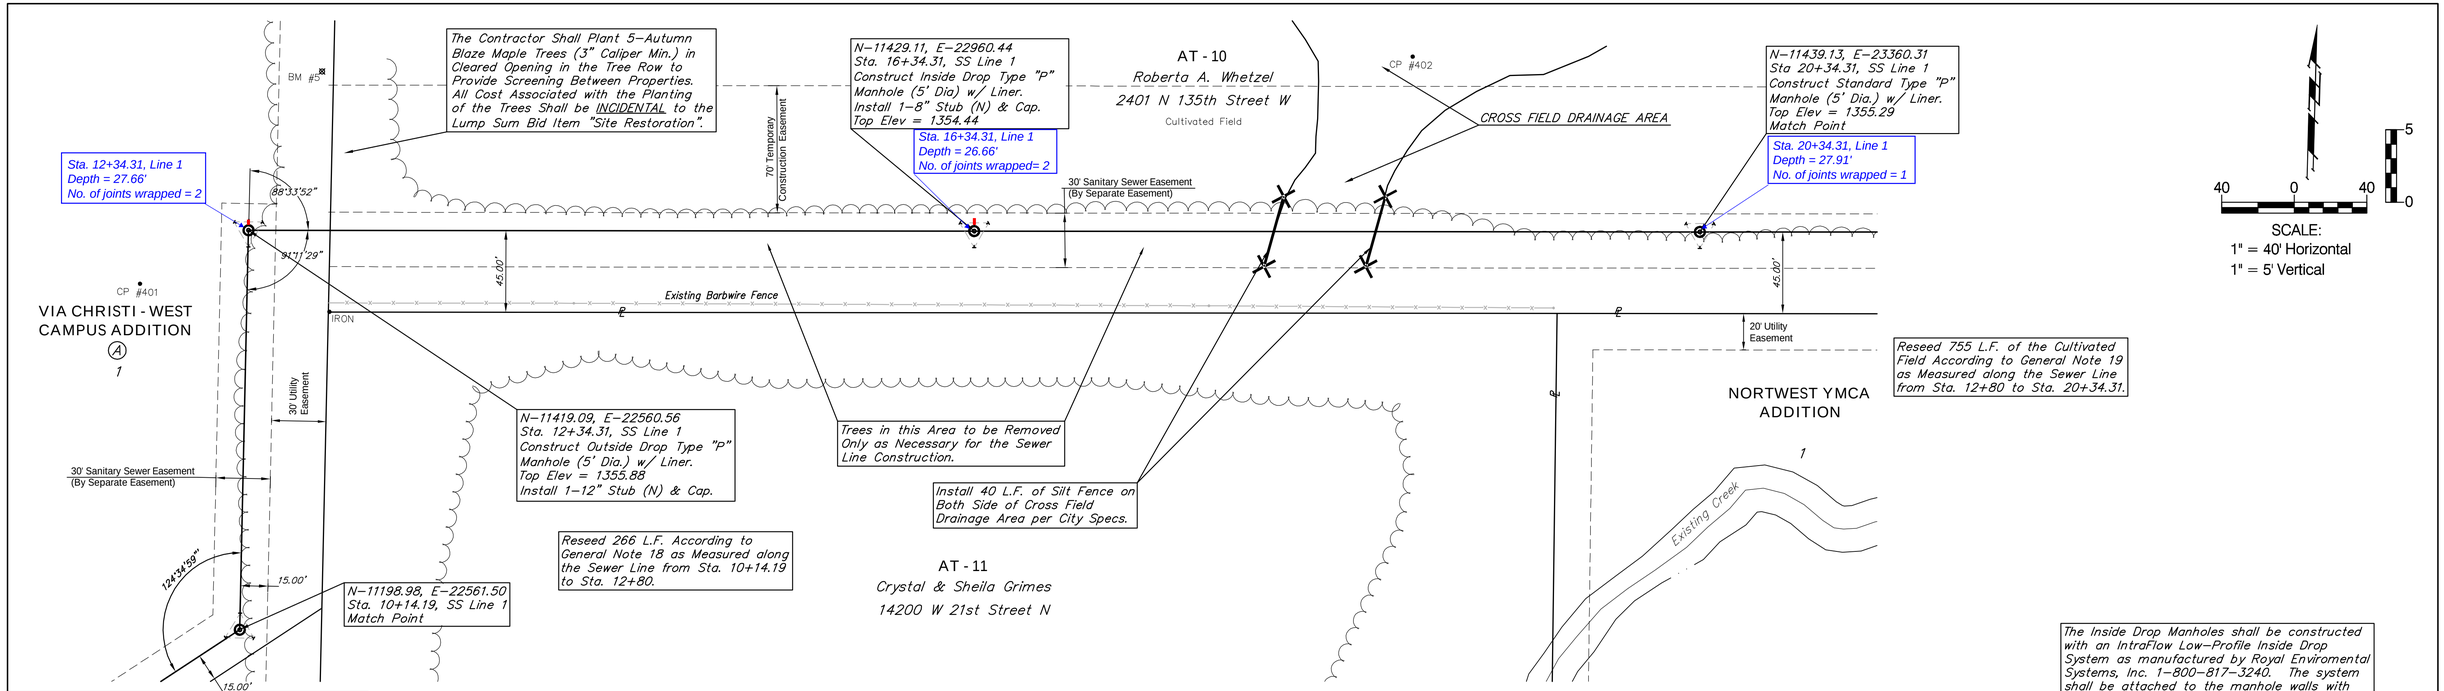

BENCHMARK:

BM #5: Railroad Spike in the South Face of a 24" Hackberry Tree Approx. 137' North of 1/16th Quarter. Elev. = 1356.50 (NAVD)

LINE 1

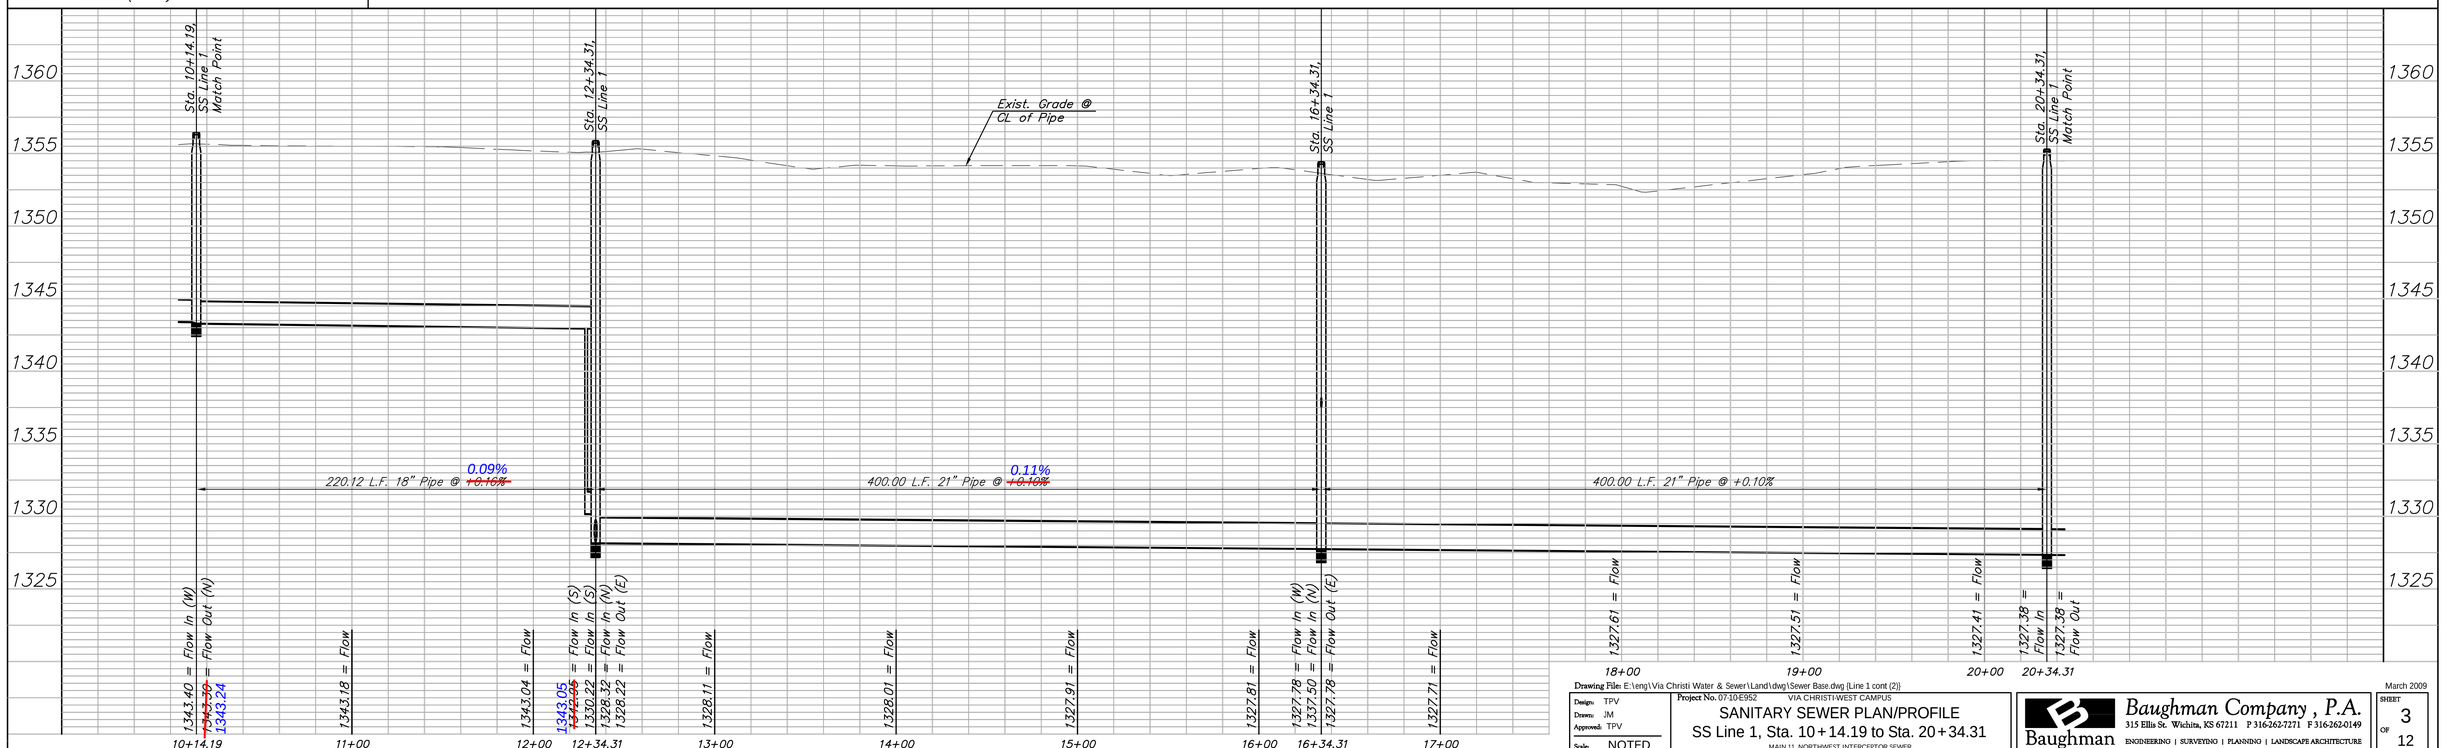

Drawing File: E:\eng\Via Christi Water & Sewer\Land\dwg\Sewer Base.dwg [Line 1 cont (2)]

Design: TPV	Project No. 07-10-E952	VIA CHRISTI-WEST CAMPUS	March 2009
Drawn: JM	SANITARY SEWER PLAN/PROFILE		SHEET 3 OF 12
Approved: TPV	SS Line 1, Sta. 10+14.19 to Sta. 20+34.31		
Scale: NOTED	MAIN 11, NORTHWEST INTERCEPTOR SEWER		

Baughman Company, P.A.
315 Ellis St. Wichita, KS 67211 P 316-262-7271 F 316-262-0149
ENGINEERING | SURVEYING | PLANNING | LANDSCAPE ARCHITECTURE