







**STORM WATER SEWER PLANS FOR
FIRST MENNONITE BRETHERN
PHASE 2**

**STORM WATER
LINE 1, 2, & 3**
SHEET TITLE
1950 PPS
PROJECT NUMBER

SRS
DESIGN BY
TKL
DRAWN BY
MAB
CHECKED BY

ISSUED
September 2010
REVISED

SHEET NO.
7 of 14

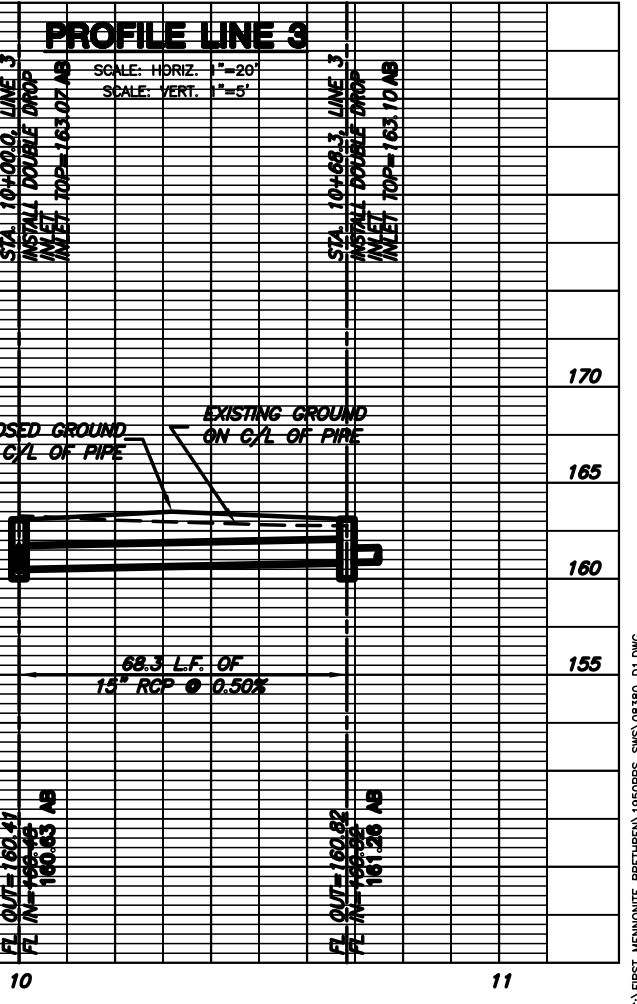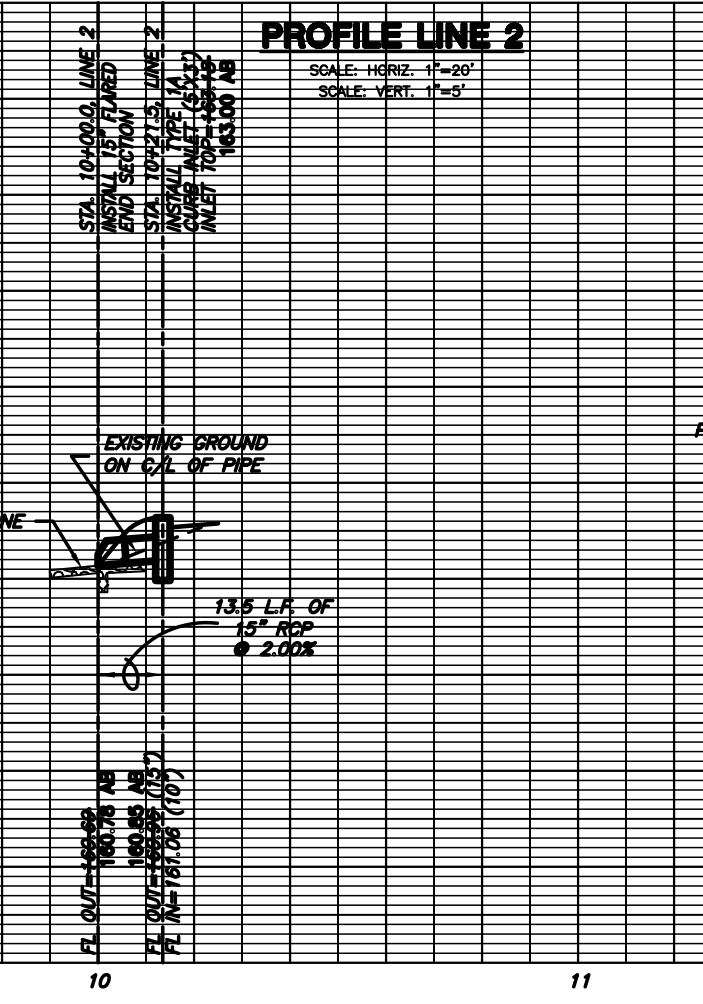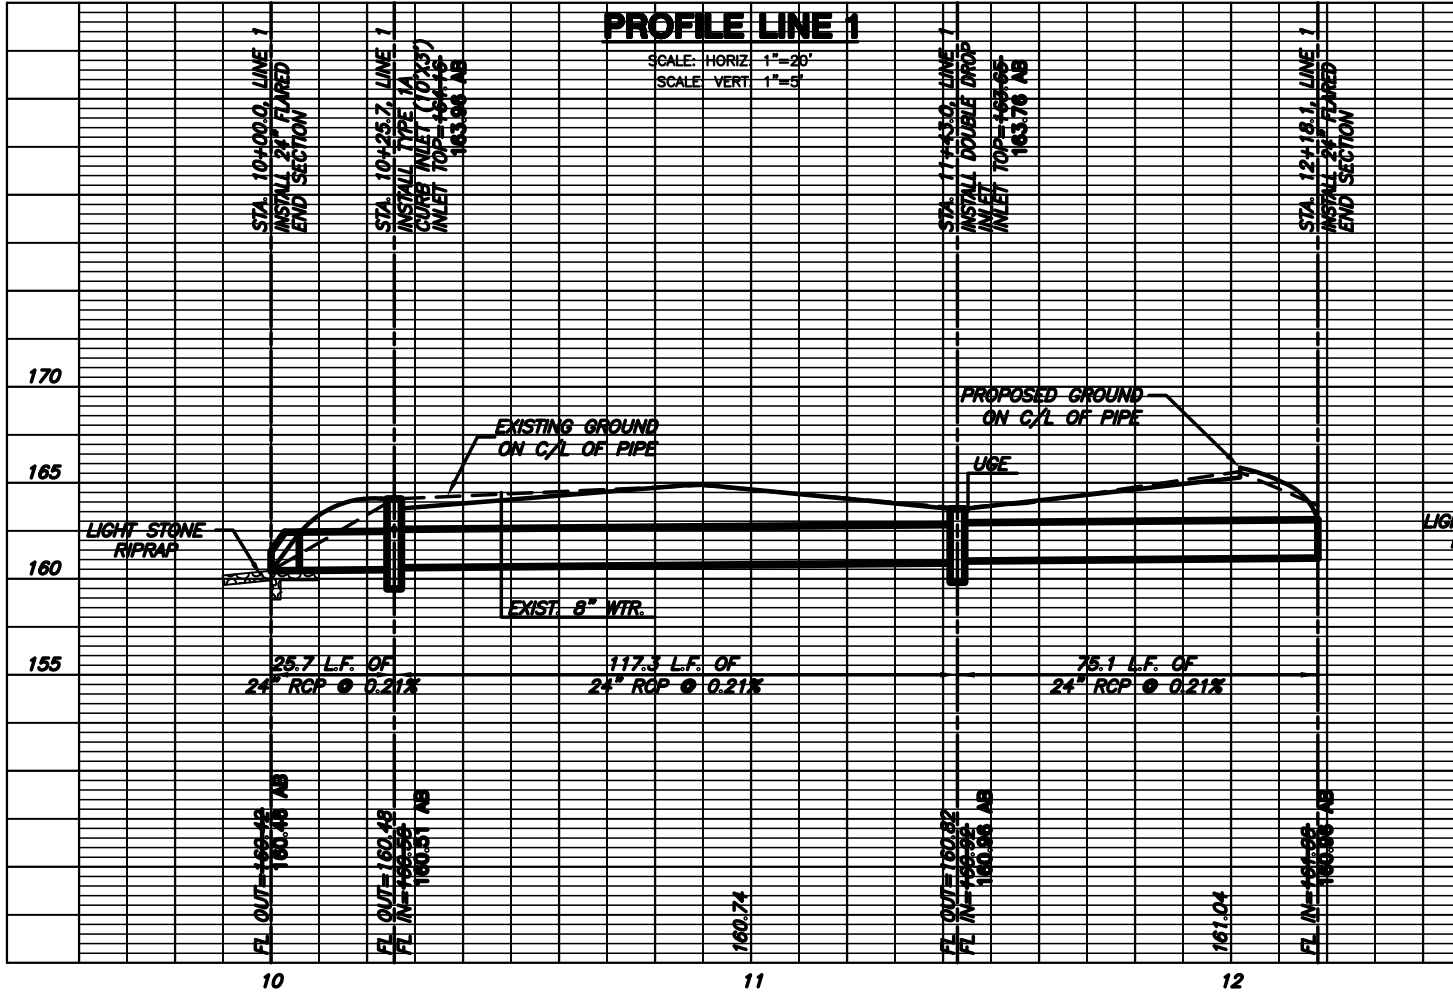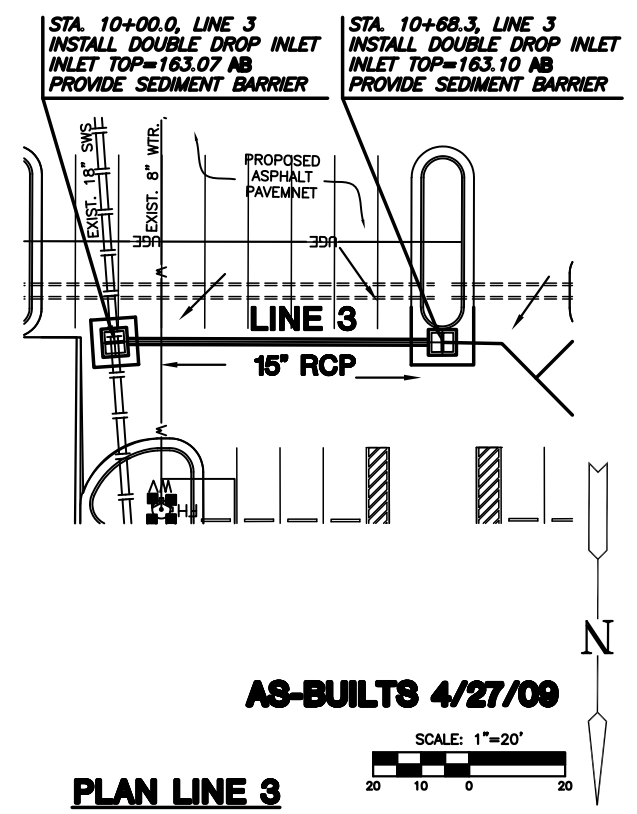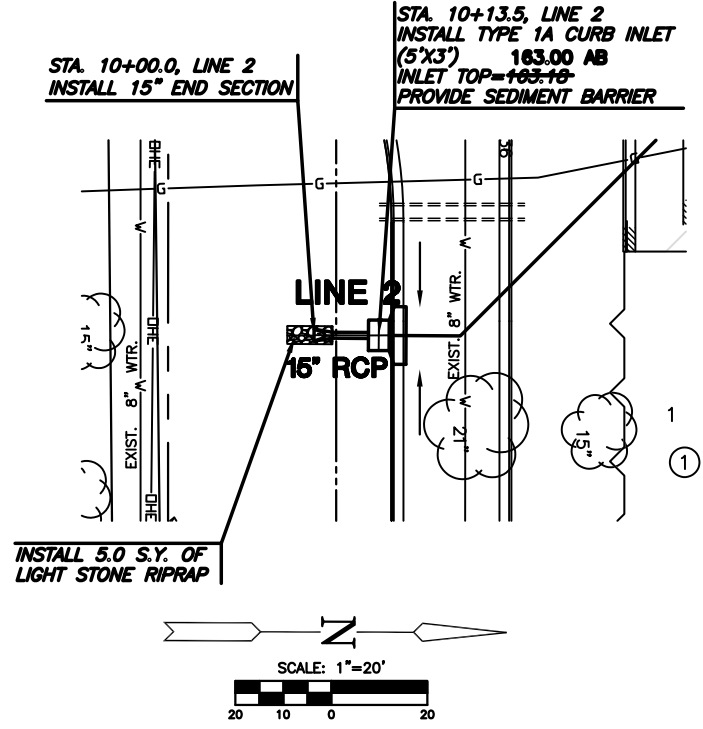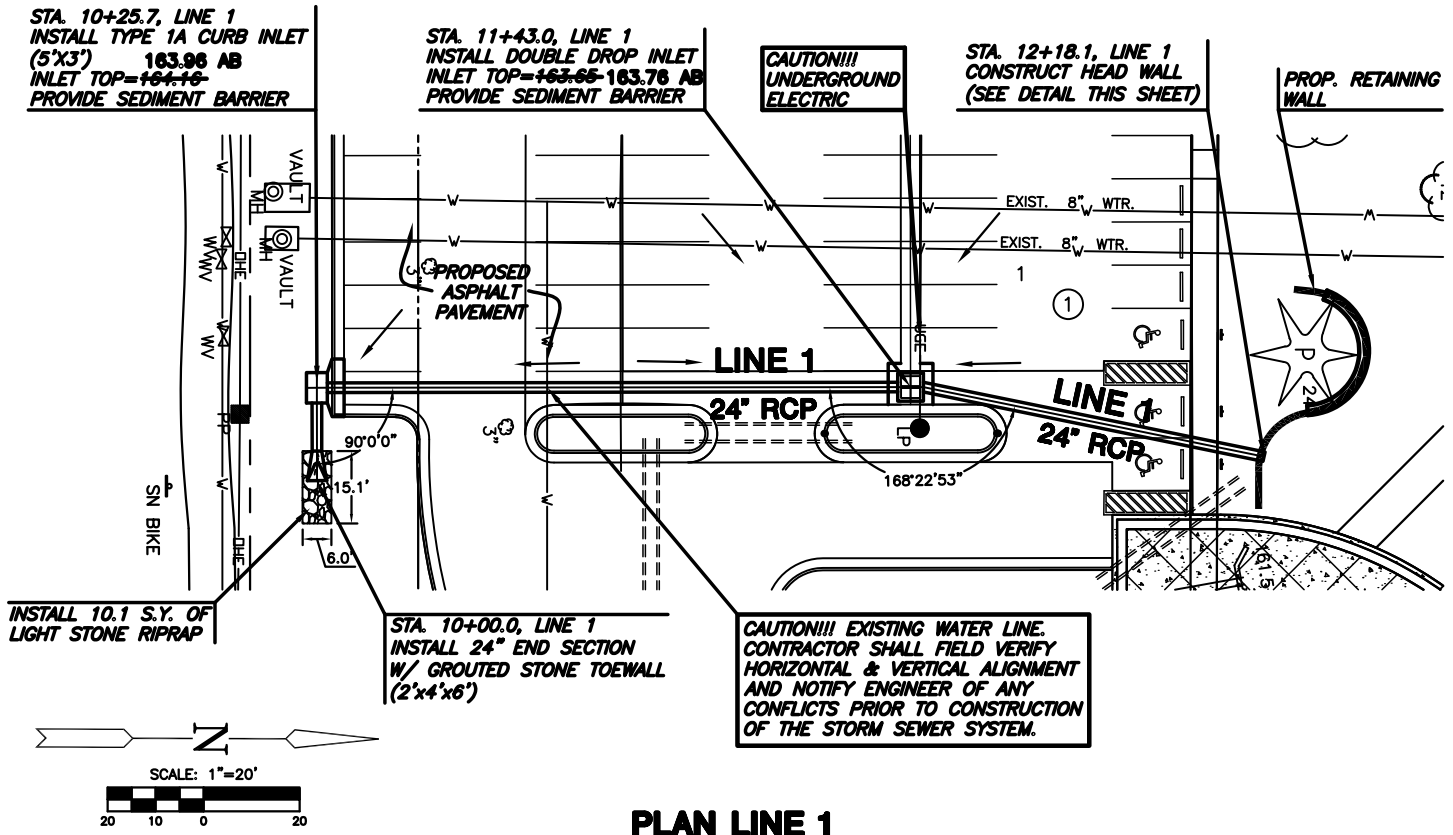

PL010B: Tuesday, September 21, 2010 @ 08:11AM

C:\FIRST MENNONITE BRETHERN\1950PPS_SWS\08360_01.DWG