PRIVATE STORM WATER SEWER EXTENSION

TO SERVE

DILLONS STORE #96 FUEL FACILITY

PRIVATE PROJECT NO. 2054 PPS (607861)

CITY OF WICHITA, KANSAS

JAMES L. ARMOUR, P.E. - CITY ENGINEER

INDEX OF SHEETS

SHEET C8.1	TITLE SHEET
SHEET C8.2	KEY MAP AND GENERAL NOTES
SHEET C8.3	PLAT
SHEET C8.4	PLAN/PROFILE
SHEET C8.5	CURB INLET DETAILS
SHEET C8.6	SOIL EROSION DETAILS

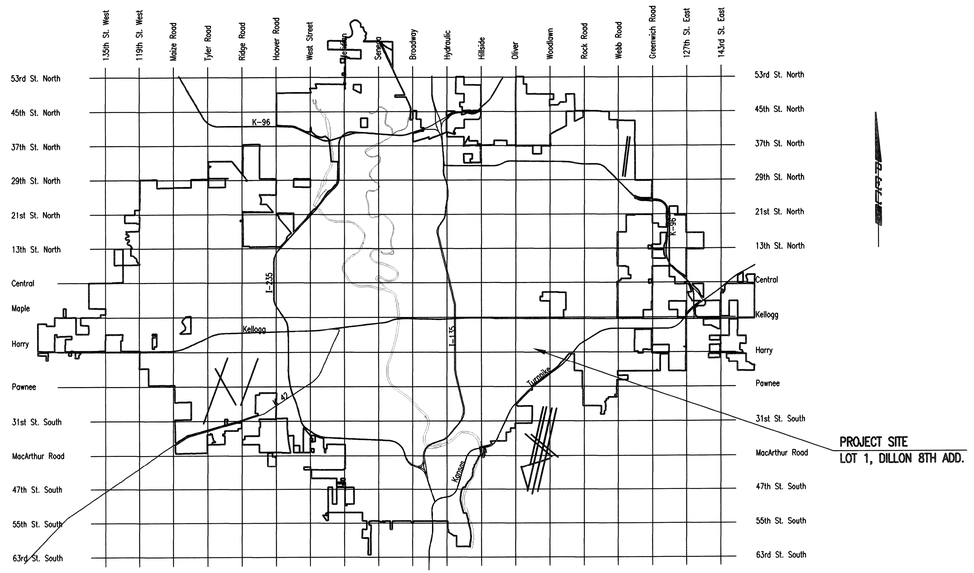

LOCATION MAP

APPROVED AS NOTED
By CITY ENGINEER OF WICHITA

Sanitary Sewers _____

Storm Sewers Julianne Kallman 6-1-10

Driveway Approaches _____

Paving _____

NOTE TO CONTRACTOR

INSPECTION AND TESTING FOR THIS PROJECT IS TO BE PROVIDED BY A LICENSED CONSULTING ENGINEERING FIRM CONTRACTED BY THE OWNER/DEVELOPER. SAID INSPECTION TO BE IN ACCORDANCE WITH THE CITY OF WICHITA STANDARD CONSTRUCTION ENGINEERING PRACTICES AND CERTIFIED BY A LICENSED PROFESSIONAL ENGINEER. NO WORK SHALL BE PERFORMED IN DEDICATED EASEMENTS OR PUBLIC RIGHT-OF-WAY BY THE CONTRACTOR UNTIL SUCH INSPECTION IS ARRANGED FOR AND REQUIRED BONDS HAVE BEEN SUBMITTED TO AND APPROVED BY THE CITY NOR SHALL ANY WORK BE COMMENCED IN DEDICATED EASEMENTS OR PUBLIC RIGHT-OF-WAY WITHOUT WRITTEN AUTHORIZATION BY THE CITY ENGINEER. IMPROVEMENTS PERFORMED UNDER THIS PROJECT SHALL NOT BE ACCEPTED BY THE CITY UNTIL ALL APPLICABLE DOCUMENTATION HAS BEEN SUBMITTED TO THE CITY ENGINEER. THIS MAY INCLUDE: RECORD DRAWINGS, INSPECTION LOGS, TEST DOCUMENTATION, TV TAPES, AND A CERTIFICATE OF COMPLETION. THE ABOVE SHALL BE PERFORMED BY THE CONSULTING FIRM CONTRACTED TO INSPECT THIS PROJECT.

MAY 2010

PLANS PREPARED BY

PROFESSIONAL ENGINEERING CONSULTANTS, P.A.

ENGINEERS

WICHITA, KANSAS

As Built Plans:

CONTRACTOR: Ewertz Exc.
INSPECTOR: Larry Gann, K E Miller Engineering
.PDF by: L.G.G. 10-15-2010

Professional Engineering Consultants, P.A.
303 S. TOPEKA • WICHITA, KANSAS 67202
316-262-2691 • FAX 316-262-3003

Dillon Stores
2700 East Fourth
Hutchinson, KS 67501
Phone (316) 665-5511

The Kroger Co.
3980 Quebec Street, Suite 210
Denver, CO 80207-1633
Phone (303) 393-4127
Fax (303) 393-4044

JOSEPH E. HICKLE, JR. LICENSED 20321 6-1-10 KANSAS PROFESSIONAL ENGINEER

REVISIONS

No.	DESCRIPTION	DES. BY	DRAWN BY	DATE

Project #:	36-06742-096-0645
Designed By:	RMH
Drawn By:	AEE
Checked By:	
Date:	MAY 2010
Scale:	
Disk File:	
Model:	
Address:	5500 E. HARRY ST.
DILLONS #96	WICHITA, KS

TITLE SHEET

Drawing No.: C8.1

Saved 05-26-2010 1:57:58 PM by AEE
Plot Scale 1:1 05-26-2010 2:01:55 PM by AEE
Q:\2006\06742\096\PPS\06742-096-C8.1-SWS-Title