

1

2



3

4

5

N: 19,044.5771, E: 22,347.3708
 WL 1, Sta. 0+00.00
 Existing 8" Water Main *
 1- 8" x 8" Tapping Sleeve
 1- 8" Tapping Valve
 1- 6" Valve Box
 Top Valve Box El. = 1431.6
 The contractor shall reimburse the City of Wichita for all cost associated with this work.



N: 19,044.5771, E: 22,391.0694
 WL 1, Sta. 0+43.70
 1- Fire Hydrant Assembly **Clow & Kennedy Valve**
 L = 4'
 Top Valve Box El. = 1431.63
 FH Bury Line El. = 1431.61
 1- 8" Plug (E)

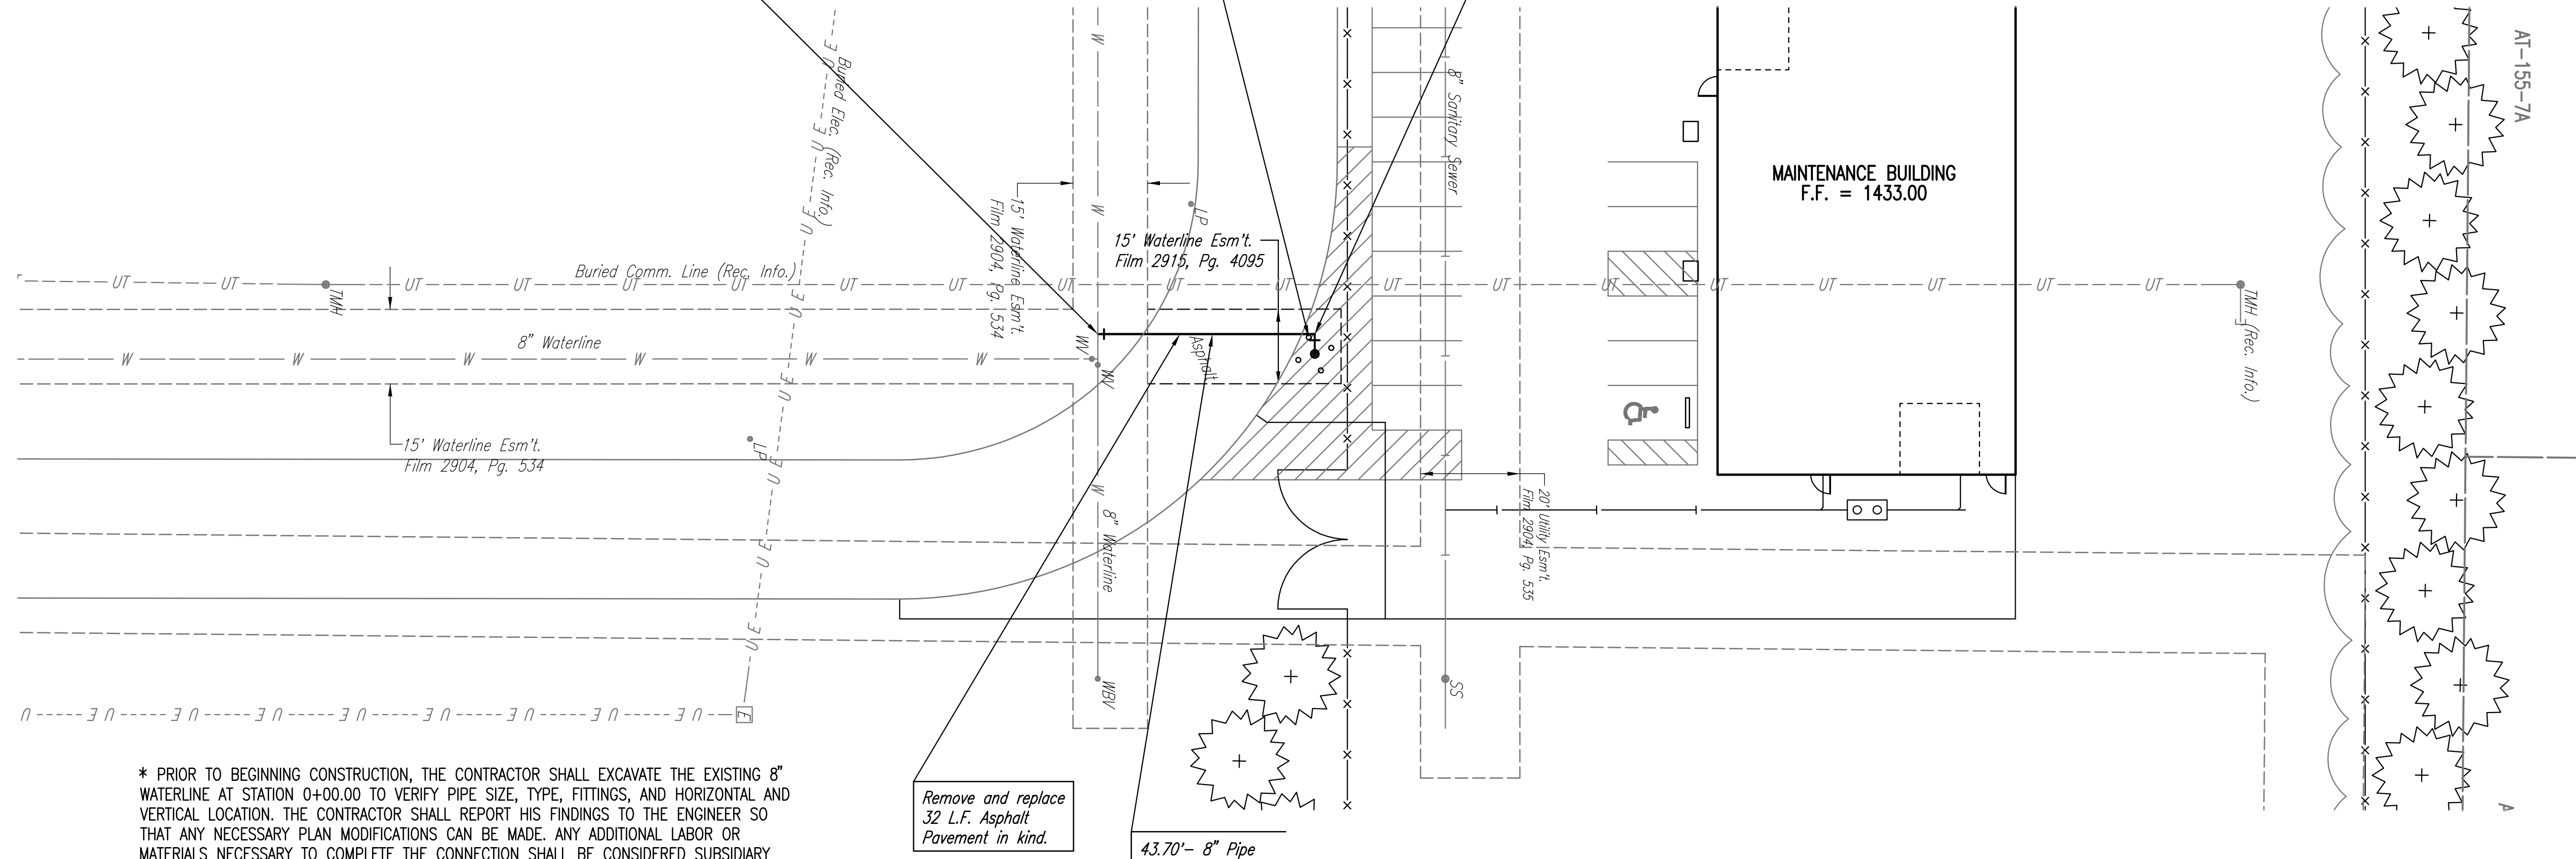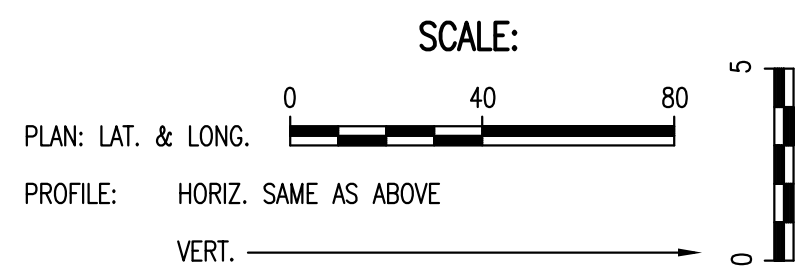

* PRIOR TO BEGINNING CONSTRUCTION, THE CONTRACTOR SHALL EXCAVATE THE EXISTING 8" WATERLINE AT STATION 0+00.00 TO VERIFY PIPE SIZE, TYPE, FITTINGS, AND HORIZONTAL AND VERTICAL LOCATION. THE CONTRACTOR SHALL REPORT HIS FINDINGS TO THE ENGINEER SO THAT ANY NECESSARY PLAN MODIFICATIONS CAN BE MADE. ANY ADDITIONAL LABOR OR MATERIALS NECESSARY TO COMPLETE THE CONNECTION SHALL BE CONSIDERED SUBSIDIARY TO THE PROJECT.

Unless noted otherwise, elevations shown are top of pipe

WATERLINE NO. 1

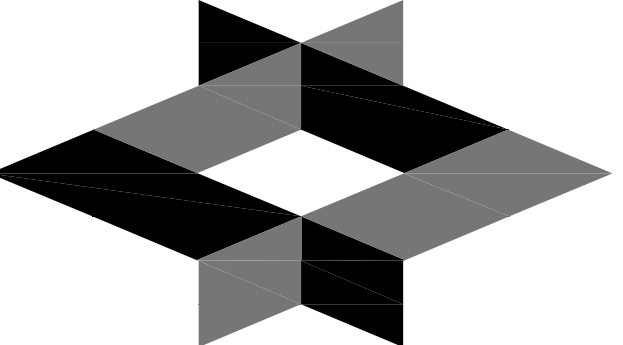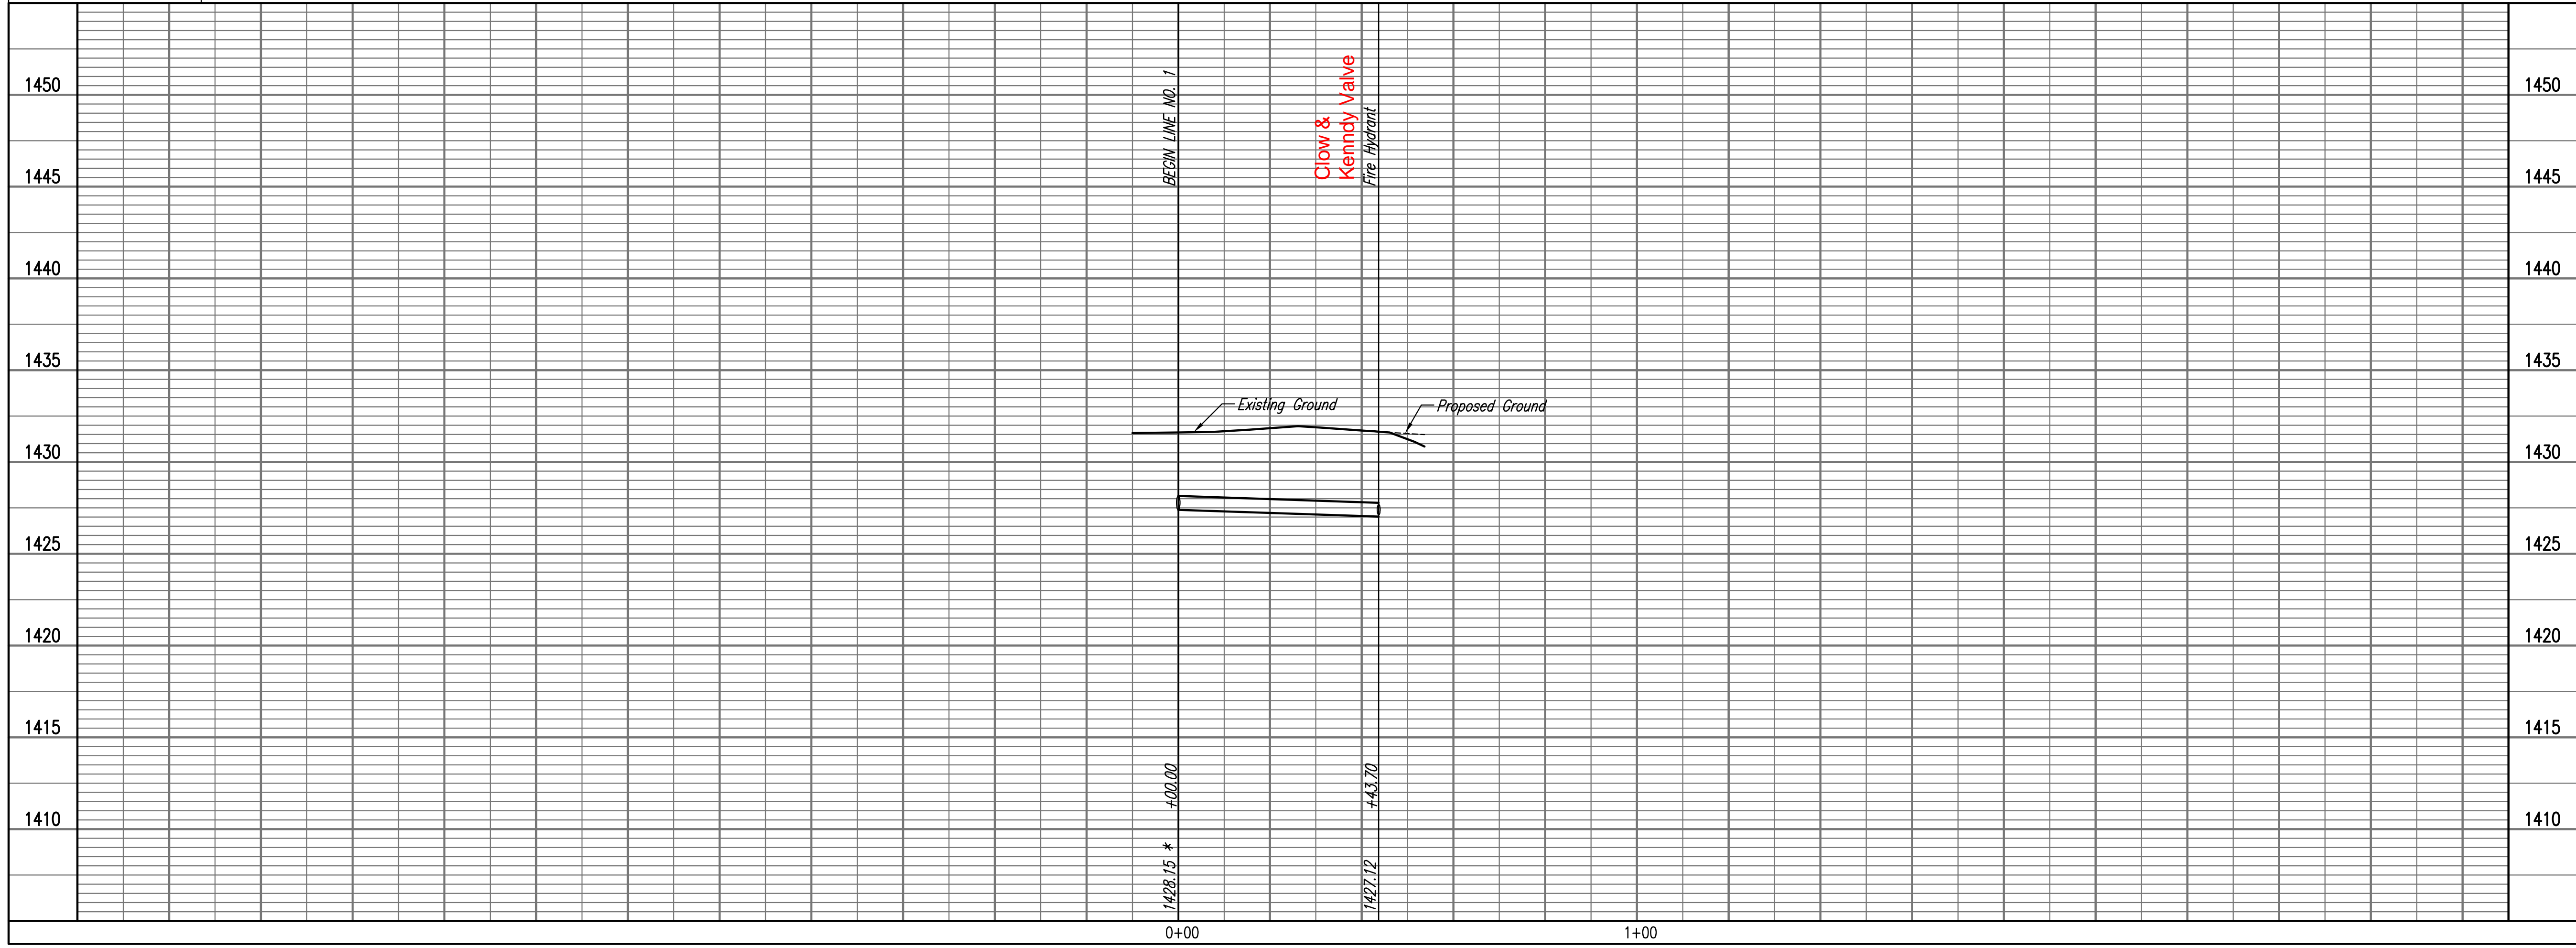

GLMV Architecture

420 S. Emporia, Wichita, KS 67202
 Tel: (316) 265-9367

125 S. Washington, Wichita, KS 67202
 Tel: (316) 262-0451

www.glmv.com

© 2010 GLMV Architecture, Inc.
 All work herein is the exclusive property of GLMV Architecture, Inc. and is not to be copied or used in any way without the express written consent of GLMV Architecture, Inc. All drawings, specifications, ideas, designs and arrangements appearing herein constitute the original and unpublished work of:
 GLMV Architecture, Inc.

**MAINTENANCE BUILDING
 UNIFIED SCHOOL DISTRICT 265
 GODDARD, KANSAS**

RA	5/10/10	ITEMS PER ADDENDUM 1
RA	5/17/10	ITEMS PER ADDENDUM 2
RA	6/18/10	OCI COMMENT REVISIONS
Mark	Date:	Description

WATERLINE NO. 1

Job No.	1185.090	C314
Date	07/07/10	
Drawn	RFT	
Checked	JEH	Dwg. of

Saved: 07-13-2010 10:01:51 AM by RFT
 Plot Scale: 1/20 07-13-2010 10:31:02 AM by RFT
 C:\DATA\GODDARD\FROM PERS\1007-05-31-FPW-WLPP01

Professional Engineering Consultants, P.A.
 303 S. TOPEKA • WICHITA, KANSAS 67202 • 316.262.2091
 www.pac1.com • design@pac1.com

PRIVATE PROJECT NO. 1541 PPW (607863)