


6' Trap with 4-45 deg. bends

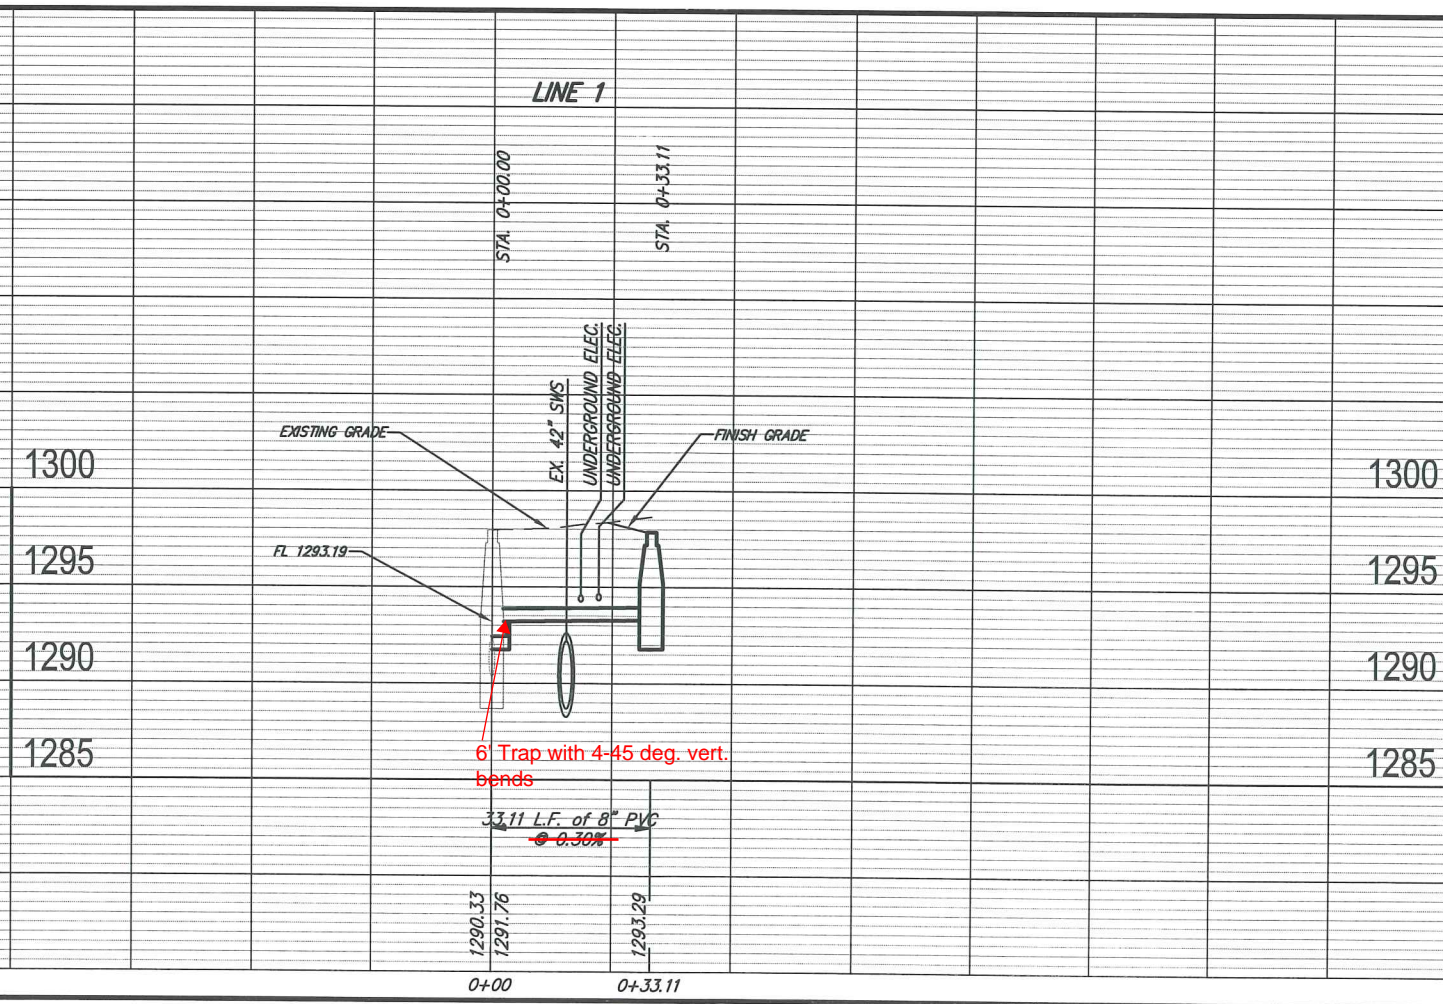

Ruggles & Bohm, P.A.
Engineering, Surveying, Land Planning
224 North Main
Wichita, Kansas 67202
www.rugglesandbohm.com

FAIRFIELD INN & SUITES
SANITARY SEWER PLAN - PROFILE
WICHITA, KANSAS

PROJECT NUMBER: 2044 PPS
DRAWING FILE: ENG BASE [SS PAP]

DESIGN: TCR
UTILITY

DRAWN: MLP
DATE: Mar. 29, 2010

REVISIONS:
REVIEW: []
DATE: []

RB JOB: 3598E
SHEET: 2 OF 4