GRAPHIC SCALE

50 0 25 50 100

(IN FEET)

1 INCH = 50 FT.

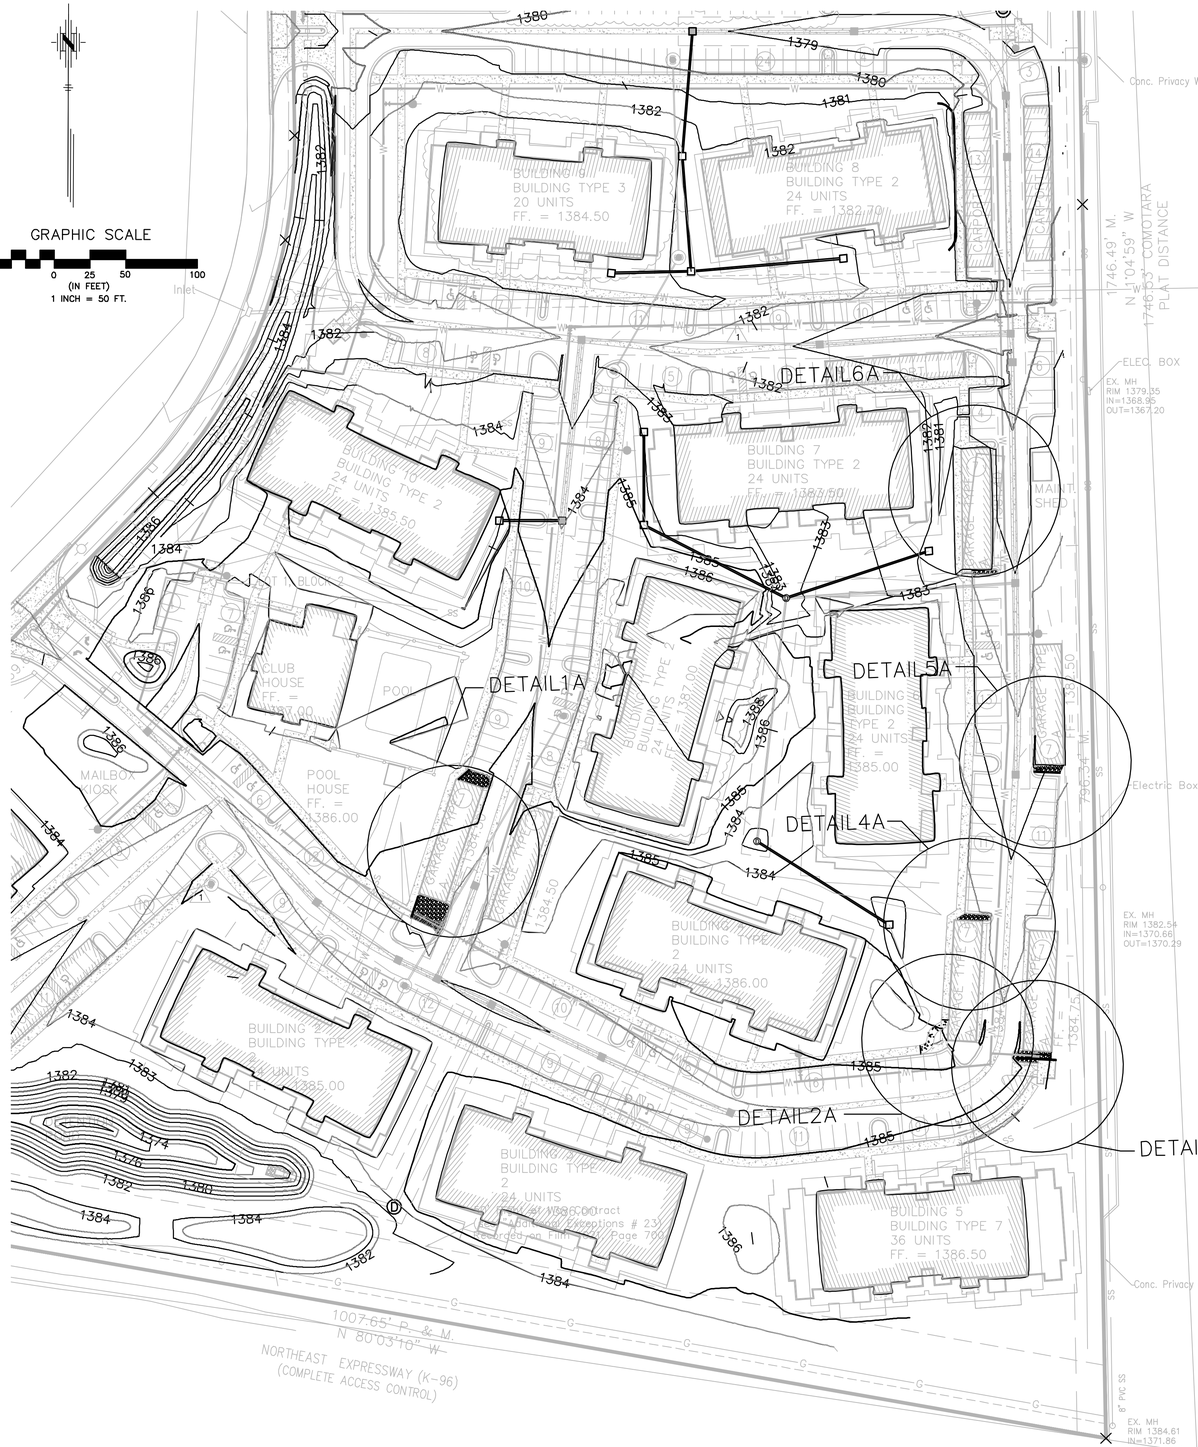

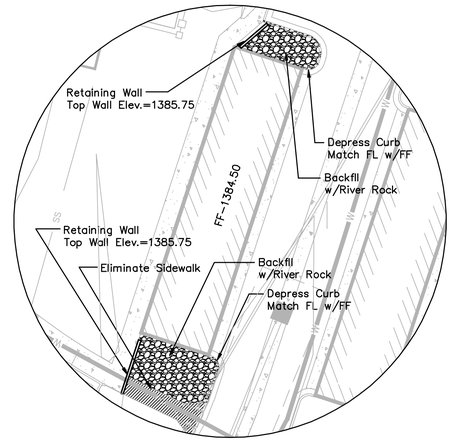

DETAIL 1A

SCALE 1"=20'

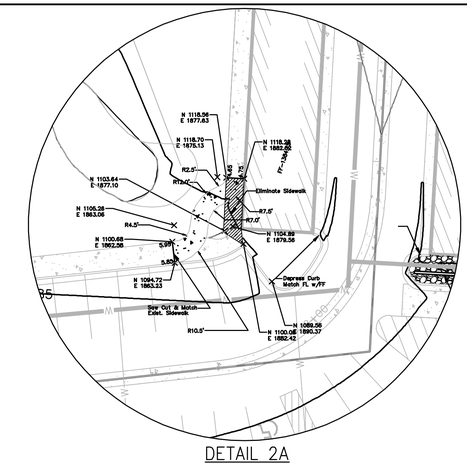

DETAIL 2A

SCALE 1"=20'

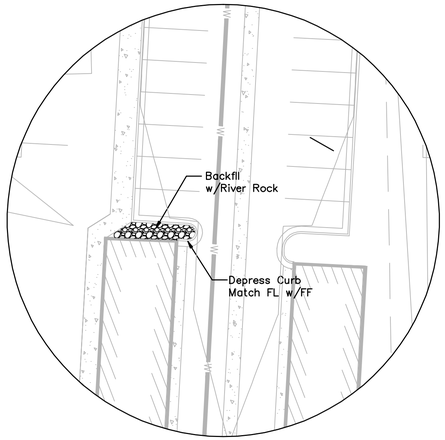

DETAIL 3A

SCALE 1"=20'

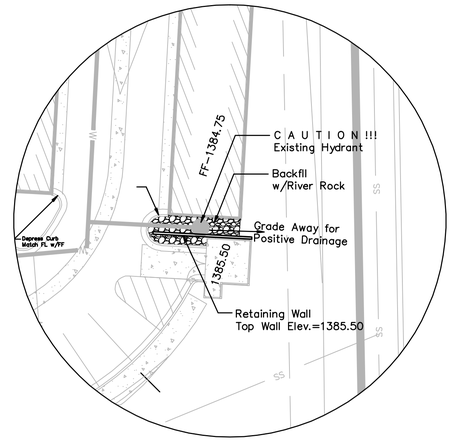

DETAIL 4A

SCALE 1"=20'

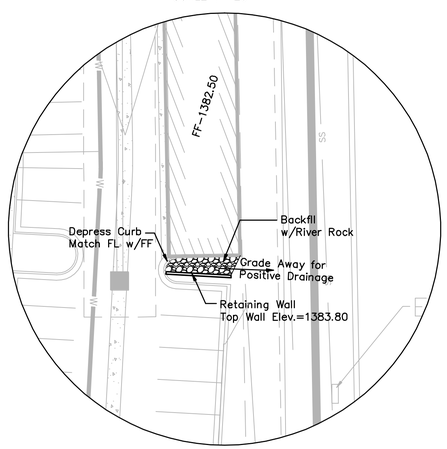

DETAIL 5A

SCALE 1"=20'

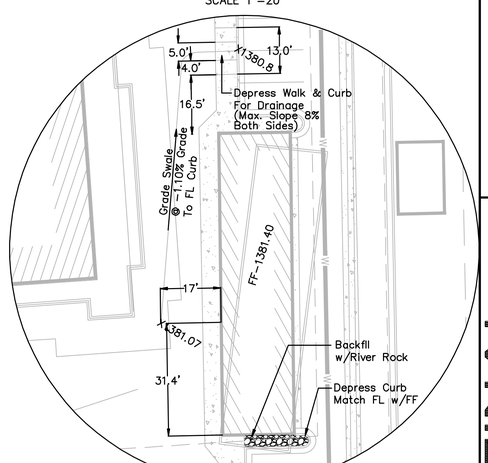

DETAIL 6A

SCALE 1"=20'

No. | Date | By | Approved | Revision

REVISED GRADING PLAN

Target Areas

Inwood Apartments

1955 PPS (607861)

POE & ASSOCIATES, INC.
CONSULTING ENGINEERS
8340 E. Central, Suite 200 ■ Wichita, KS 67208-4242
Phone 316/685-4114 FAX 316/685-4444

FINAL

Engineer: ——————————

Designer: SS

Poe Job No.: 1909

Date: February 2009

Sheet 5 of 12