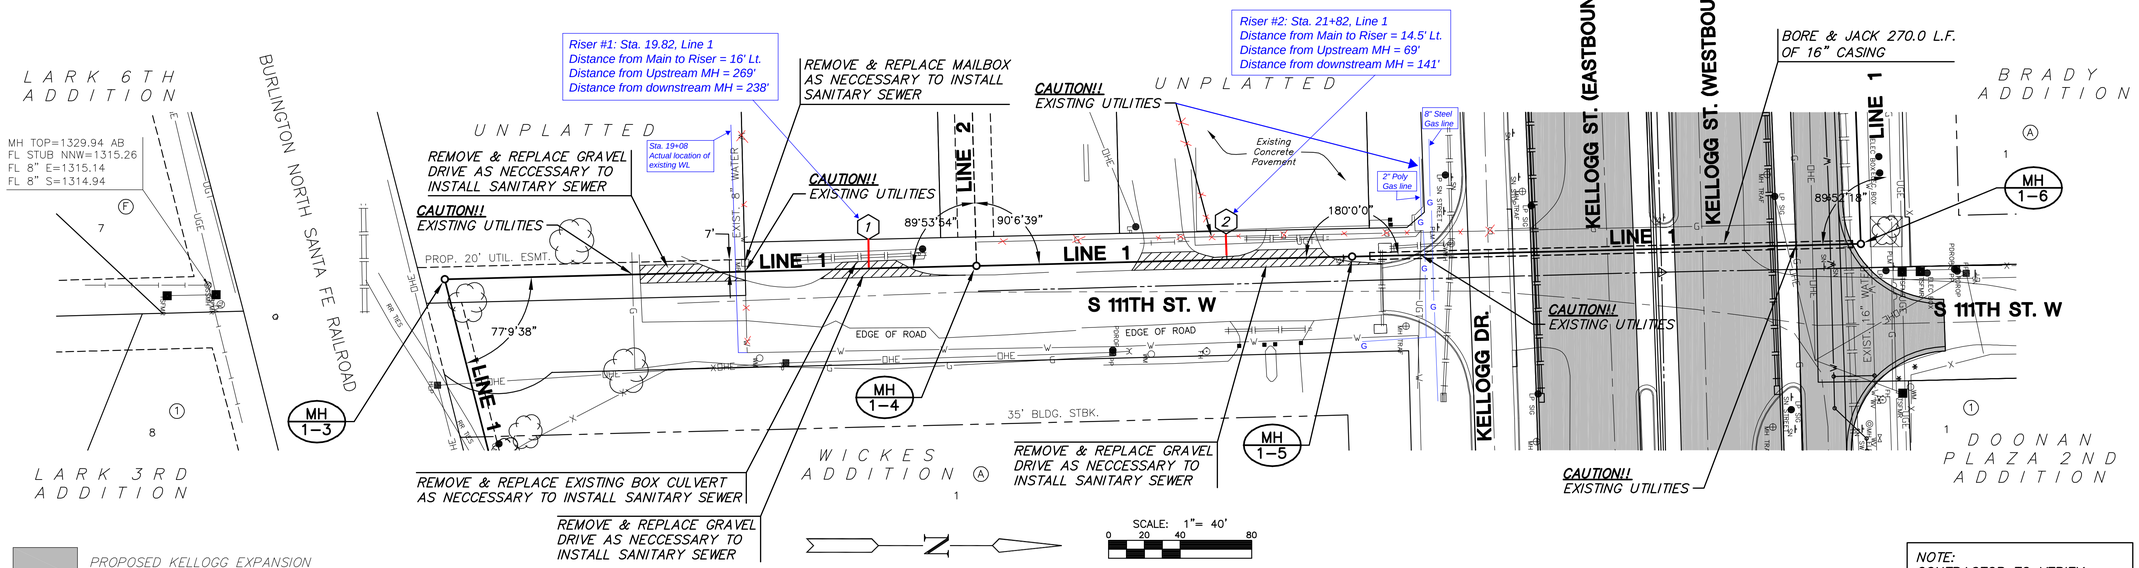

PROPOSED KELLOGG EXPANSION

TREE REMOVAL

PLAN LINE 1

NOTE:
CONTRACTOR TO VERIFY LOCATION AND ELEVATION OF EXISTING UTILITIES PRIOR TO CONSTRUCTION.

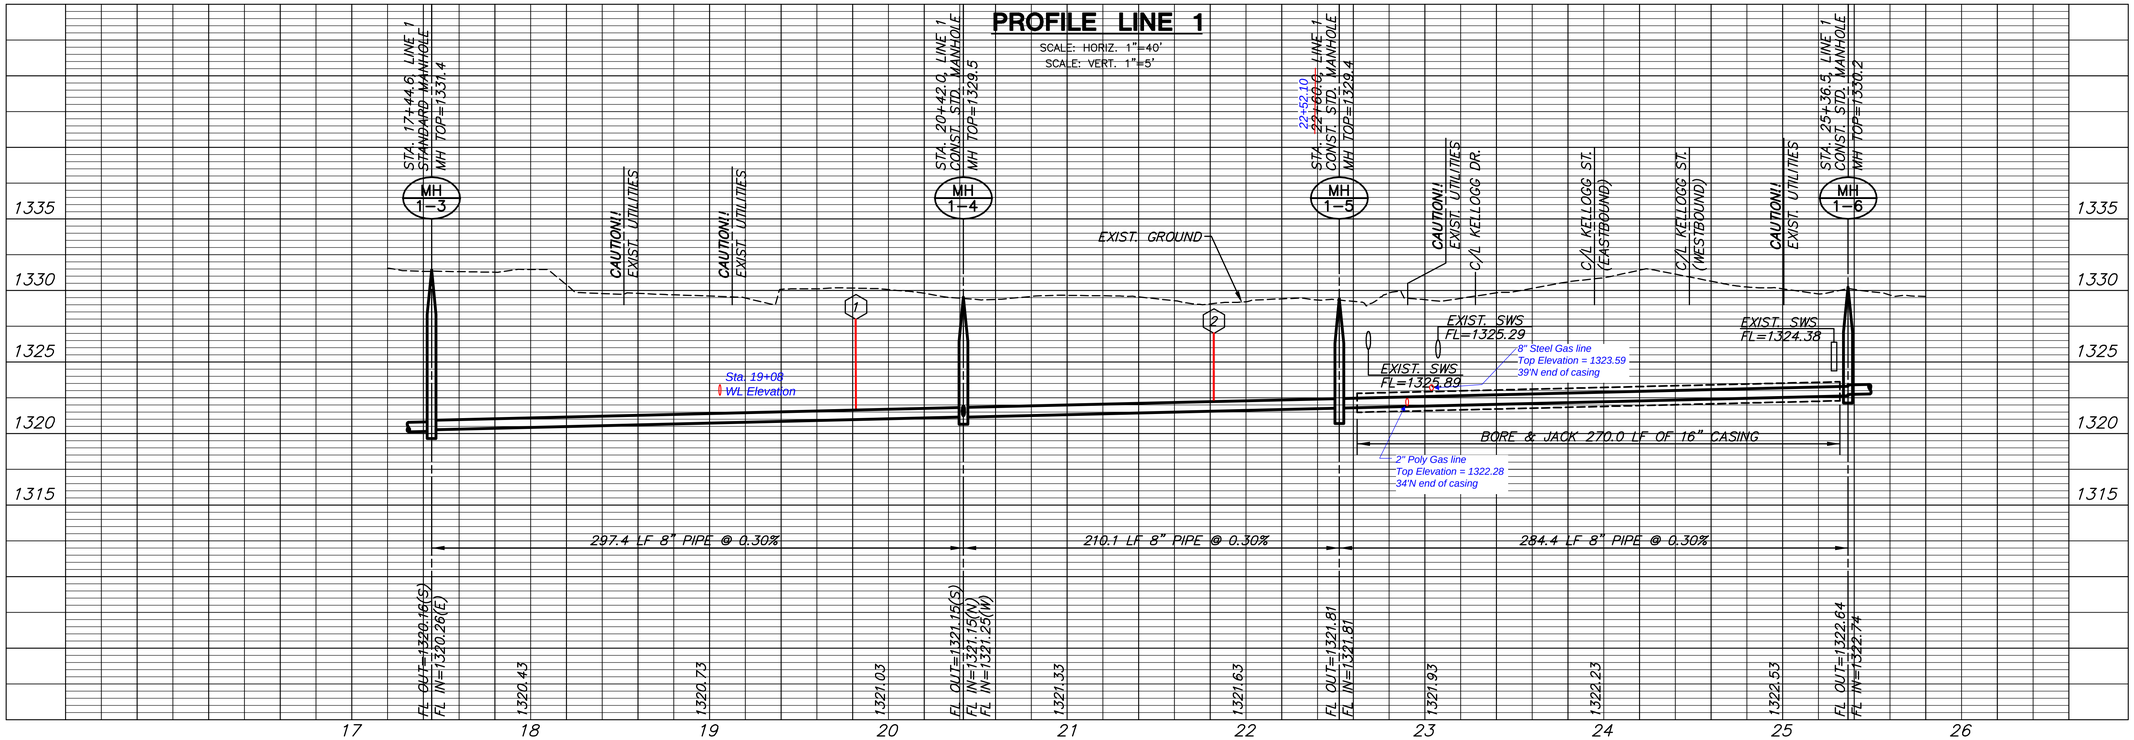

MKEC ENGINEERING CONSULTANTS, INC.
411 N. WEBB ROAD
WICHITA, KS. 67206
316 - 684 - 9600

SANITARY SEWER PLANS

C.O.W. LATERAL 23, MAIN 13, SWI

LINE 1
SHEET TITLE

07428
PROJECT NUMBER

JS
DESIGN BY

JWC
DRAWN BY

MAB
CHECKED BY

ISSUED
June 2009

REVISED

SHEET NO.
6 of 14

J:\CIVIL\07428 LAT 23\DWG\SAN\07428B2_.DWG

PLOTTED: Thursday, October 29, 2009 @ 03:58PM