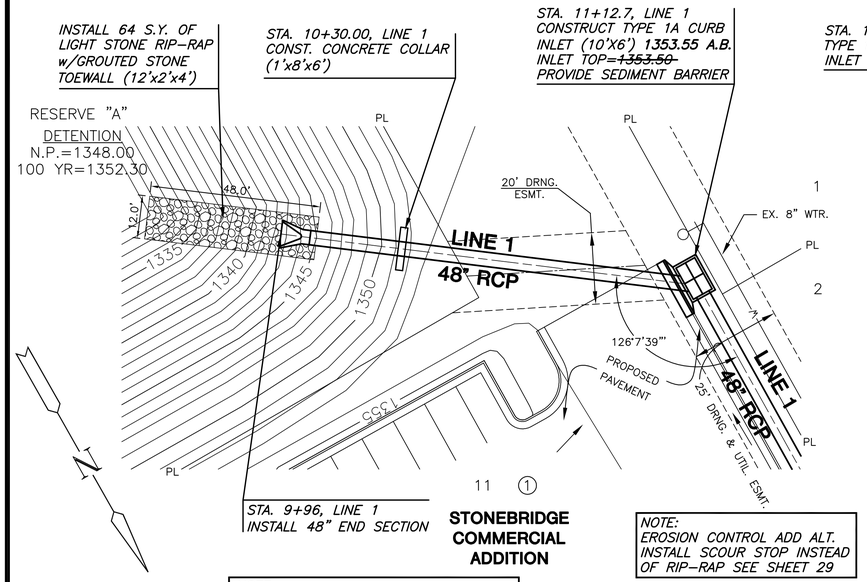

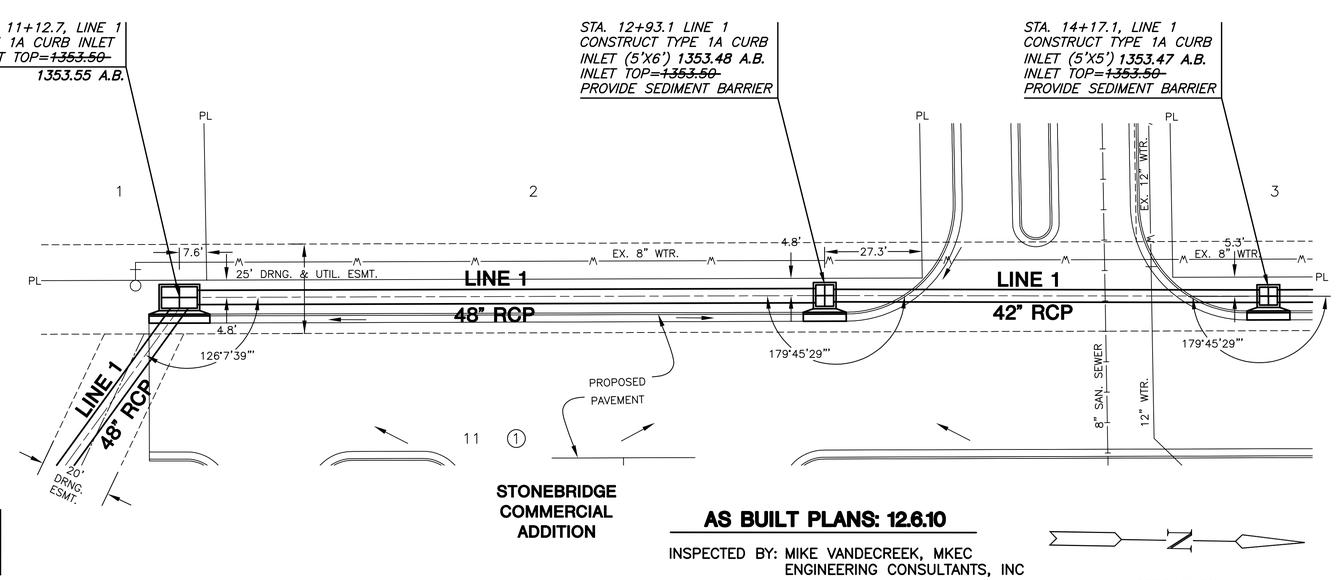

AS BUILT PLANS: 12.6.10

INSPECTED BY: MIKE VANDECREEK, MKEC ENGINEERING CONSULTANTS, INC

CONSTRUCTED BY: DULING CONSTRUCTION CO., INC.

N

SCALE: 1"=20'
20 10 0 20

PLAN LINE 1

PROFILE LINE 1

SCALE: HORIZ. 1"=20'
SCALE: VERT. 1"=5'

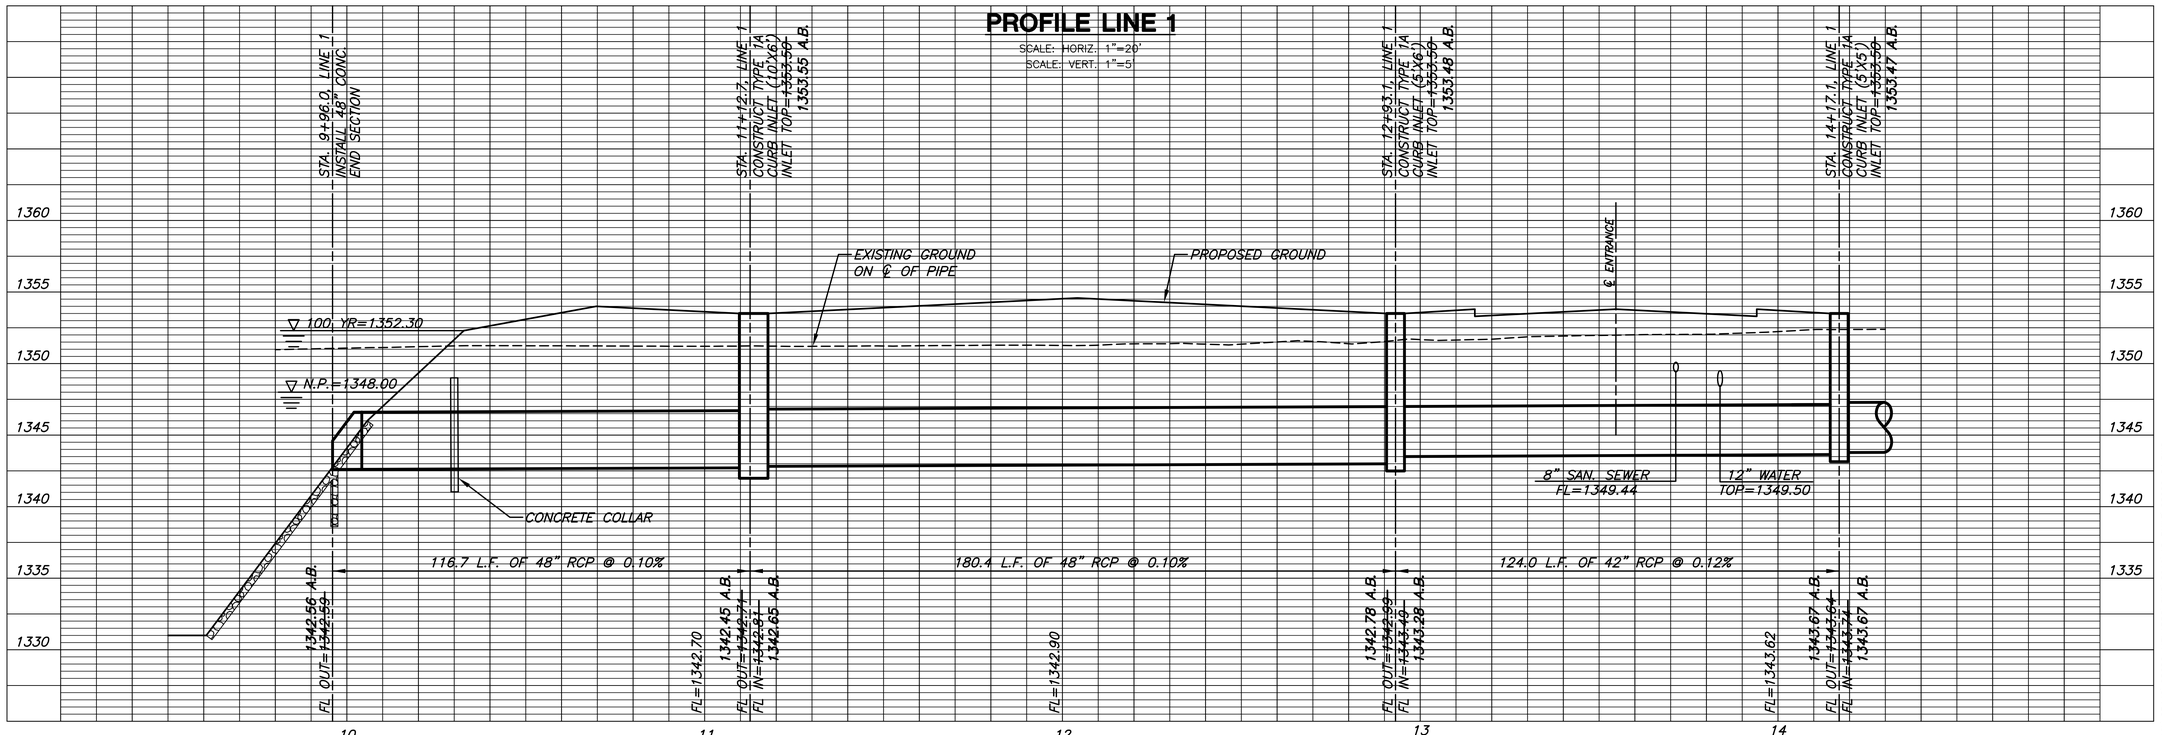

STORM WATER SEWER 2 OF 19

MKEC ENGINEERING CONSULTANTS, INC.
411 N. WEBB ROAD
WICHITA, KS. 67206
316 - 684 - 9600

CIVIL SITE PLANS

MENARDS - WEST WICHITA, KS

STONEBRIDGE COMMERCIAL ADDITION

SWS PLAN & PROFILE LINE 1
SHEET TITLE

08626
PROJECT NUMBER

MKEC
DESIGN BY

MKEC
DRAWN BY

MAB
CHECKED BY

ISSUED

REVISED AS BUILT 12-06-10

SHEET NO.
18 of 45

PLOTTED: Thursday, December 16, 2010 @ 10:51AM
J:\CIVIL\05440\08626-MENARDS\SWS\2010\AS BUILT\08626_D1.DWG