
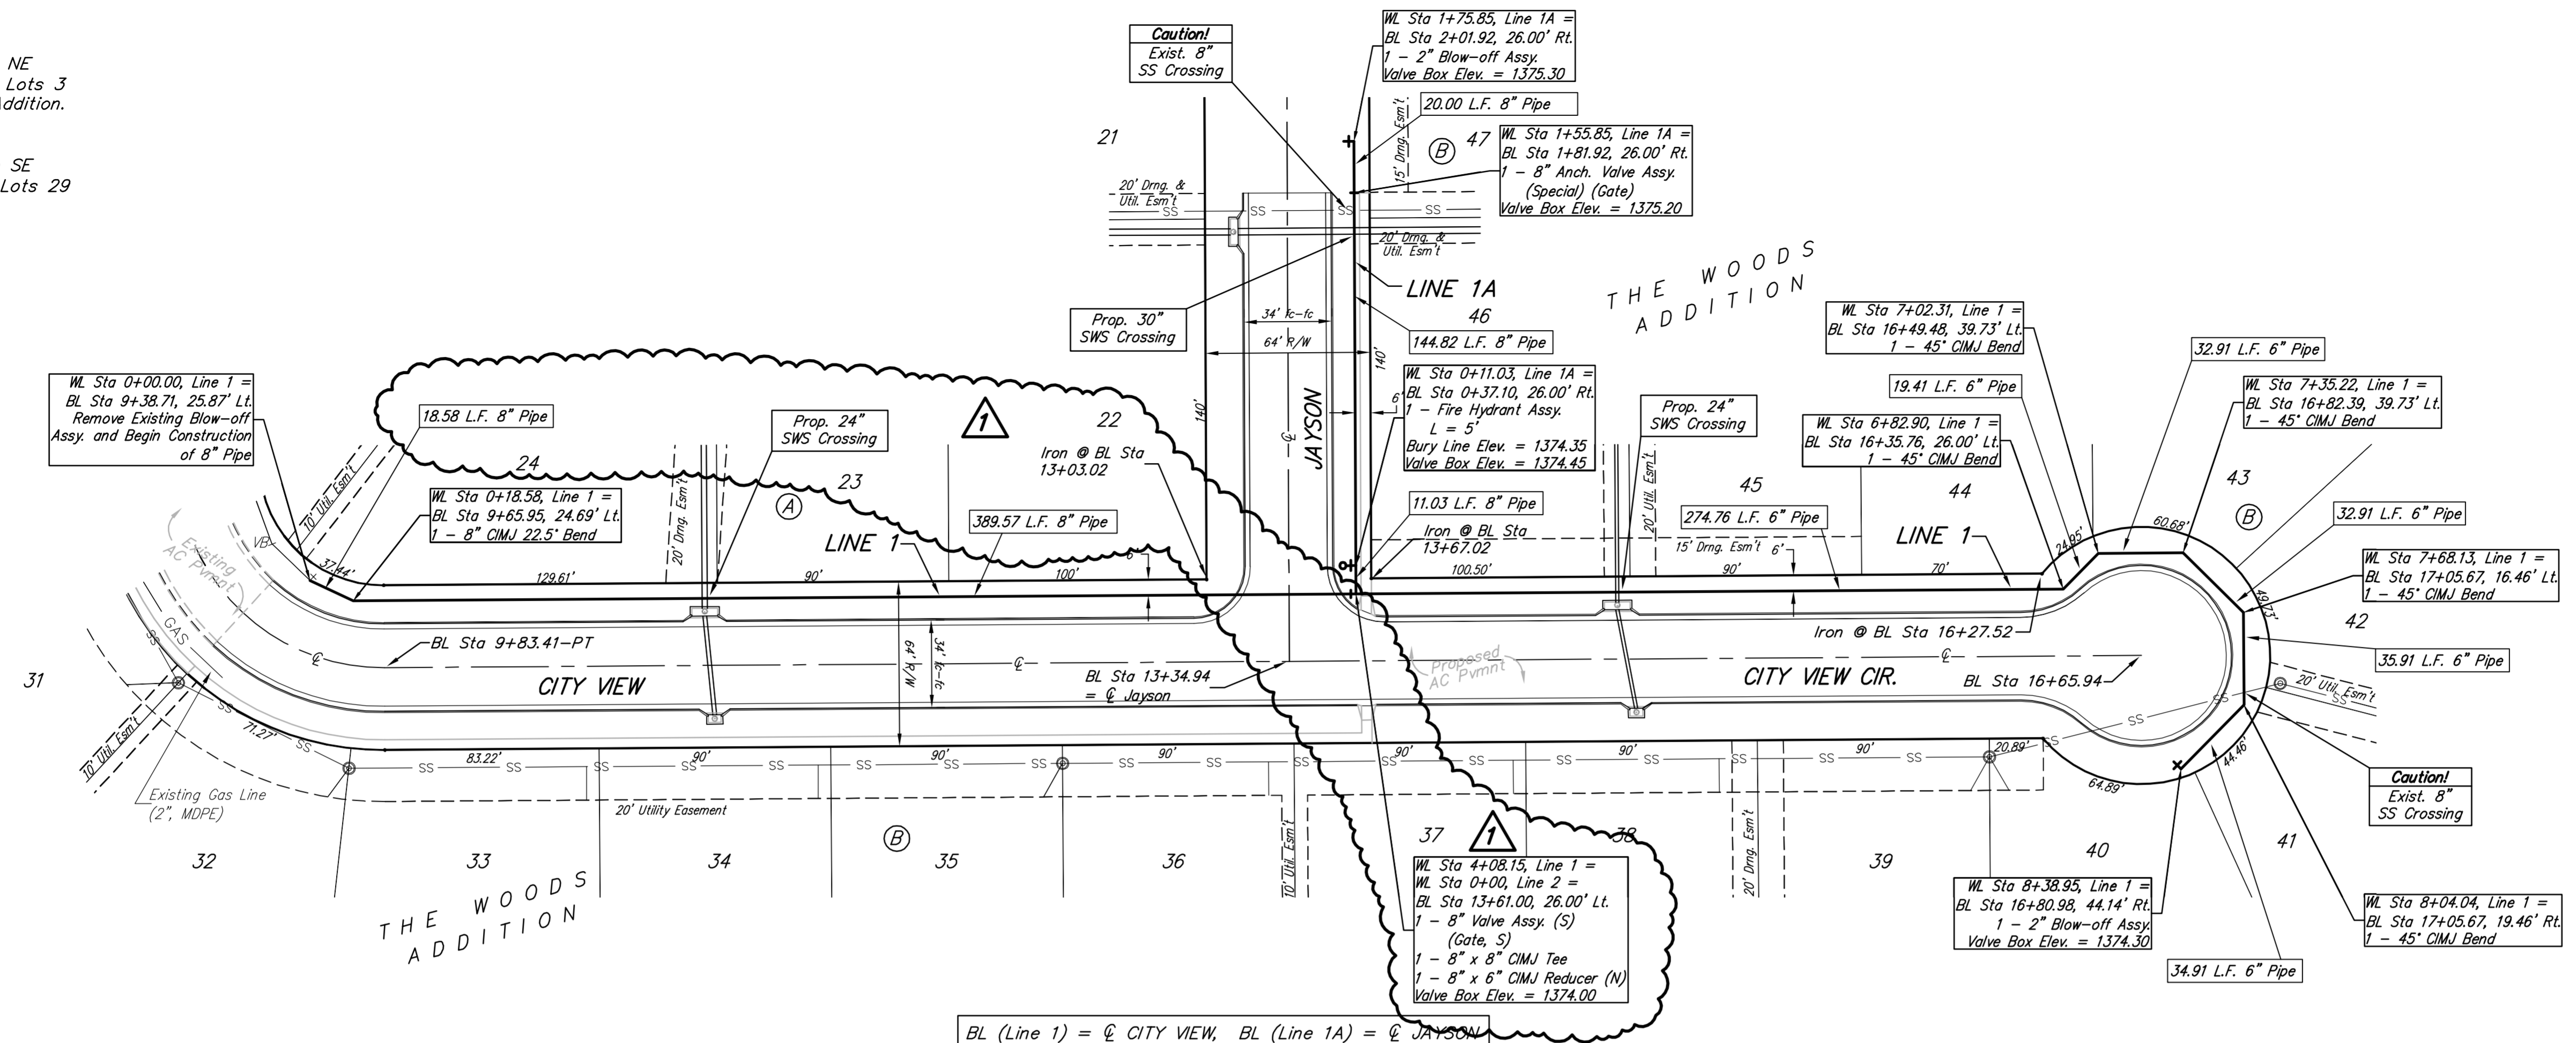



BENCHMARK:

BM #1: "□" Cut in top of the NE curb line of Fawnwood between Lots 3 and 4, Block C in The Woods Addition. Elev. = 1382.17 NGVD29

BM #2: "□" Cut in top of the SE curb line of City View between Lots 29 and 30, Block B in The Woods Addition. Elev. = 1375.17 NGVD29

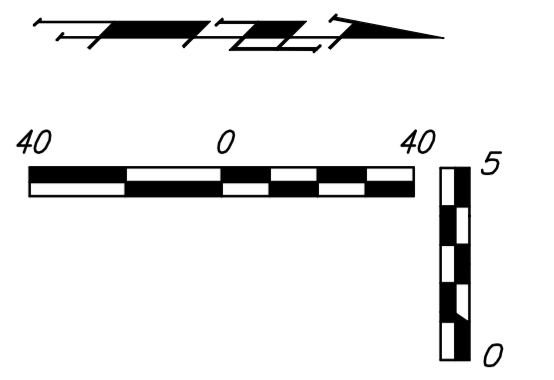

BL (Line 1) = CITY VIEW, BL (Line 1A) = JAYSON

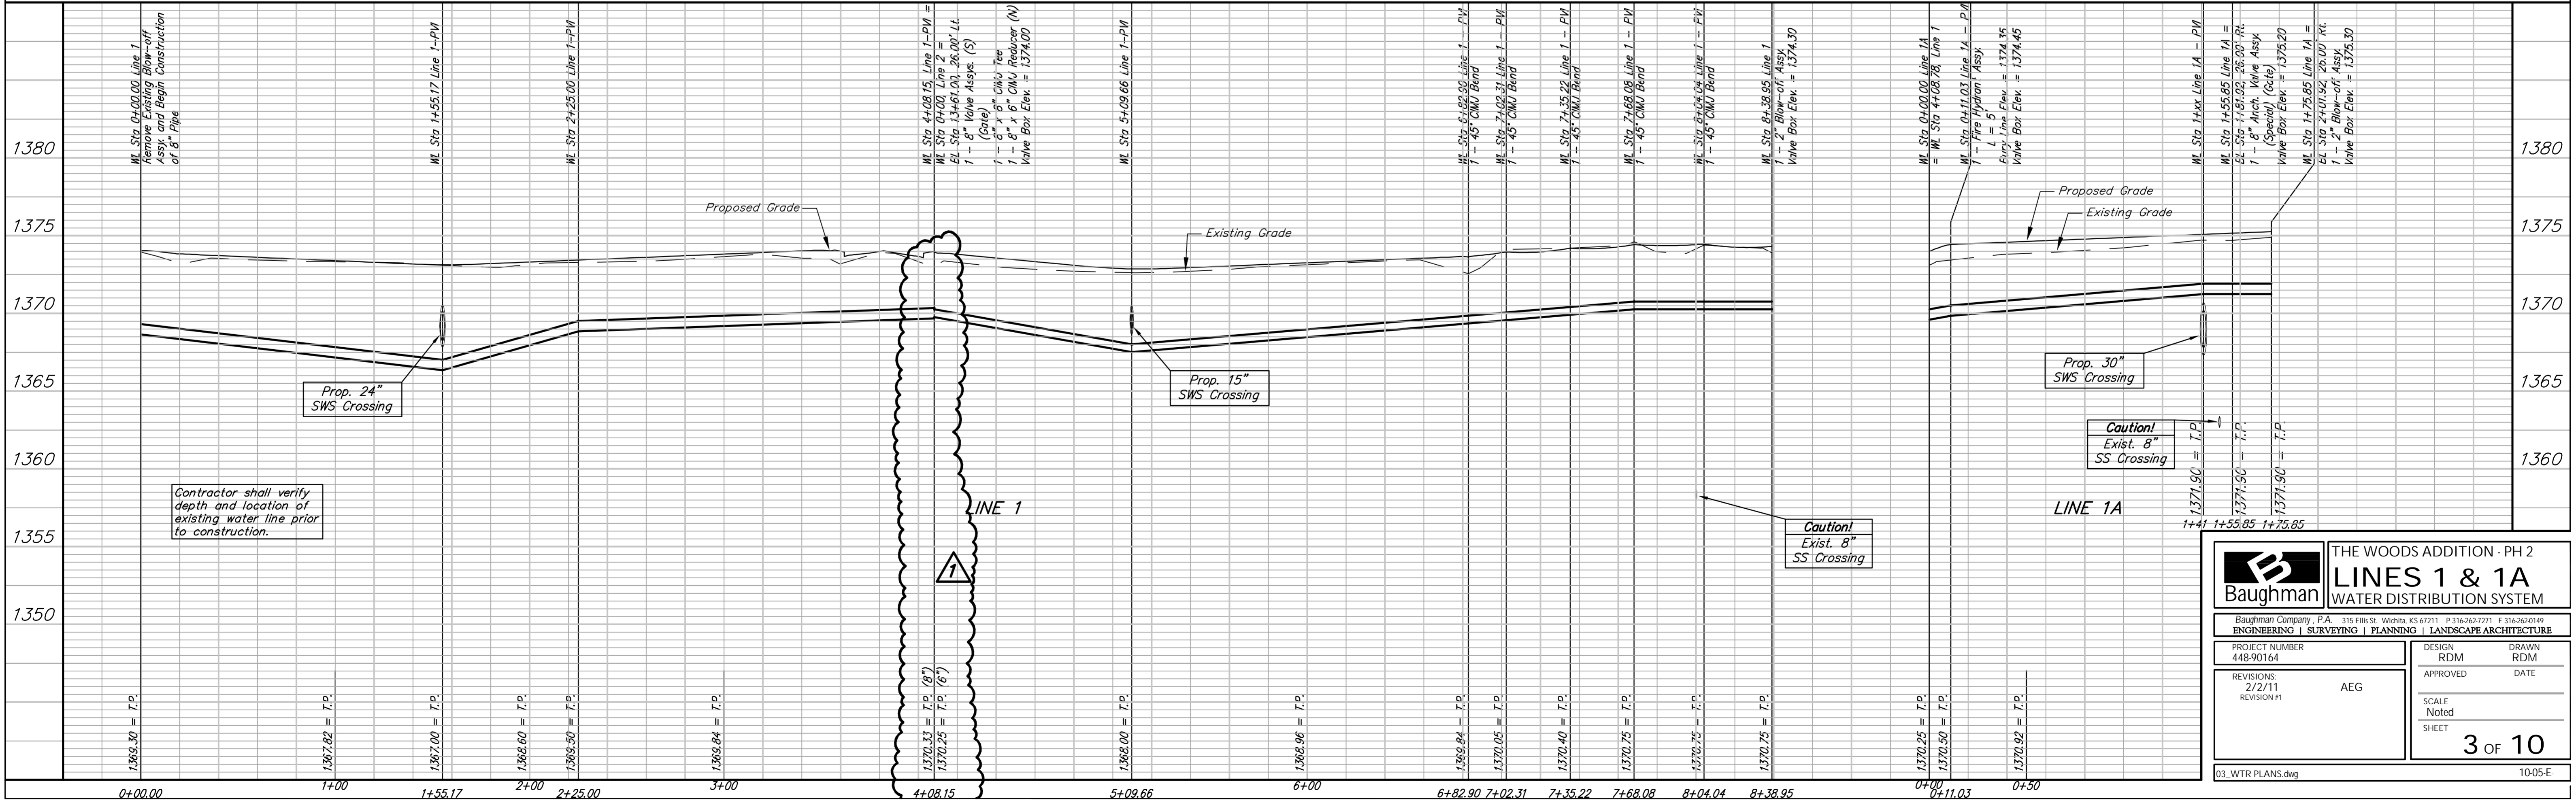

		THE WOODS ADDITION - PH 2	
		LINES 1 & 1A	
WATER DISTRIBUTION SYSTEM			
<small>Baughman Company, P.A. 315 Ellis St. Wichita, KS 67211 P 316.262.7271 F 316.262.0149</small> <small>ENGINEERING SURVEYING PLANNING LANDSCAPE ARCHITECTURE</small>			
PROJECT NUMBER 448-90164	DESIGN RDM	APPROVED DATE	DRAWN RDM
REVISIONS: 2/2/11 REVISION #1	AEG		
SCALE Noted			SHEET 3 of 10
03_WTR PLANS.dwg			1005-E