


SANITARY SEWER LIFT STATION AND FORCE MAIN
BOTANICA - THE WICHITA GARDENS
STREETS AND UTILITIES

GRAVITY SEWER LINE 1
SHEET TITLE
468-84683
PROJECT NUMBER

DESIGN BY: **AJK**
DRAWN BY: **DMU**
CHECKED BY: **AJK**

ISSUED: **July 2010**
REVISED: **11/04/10**

SHEET NO.
5A of 29

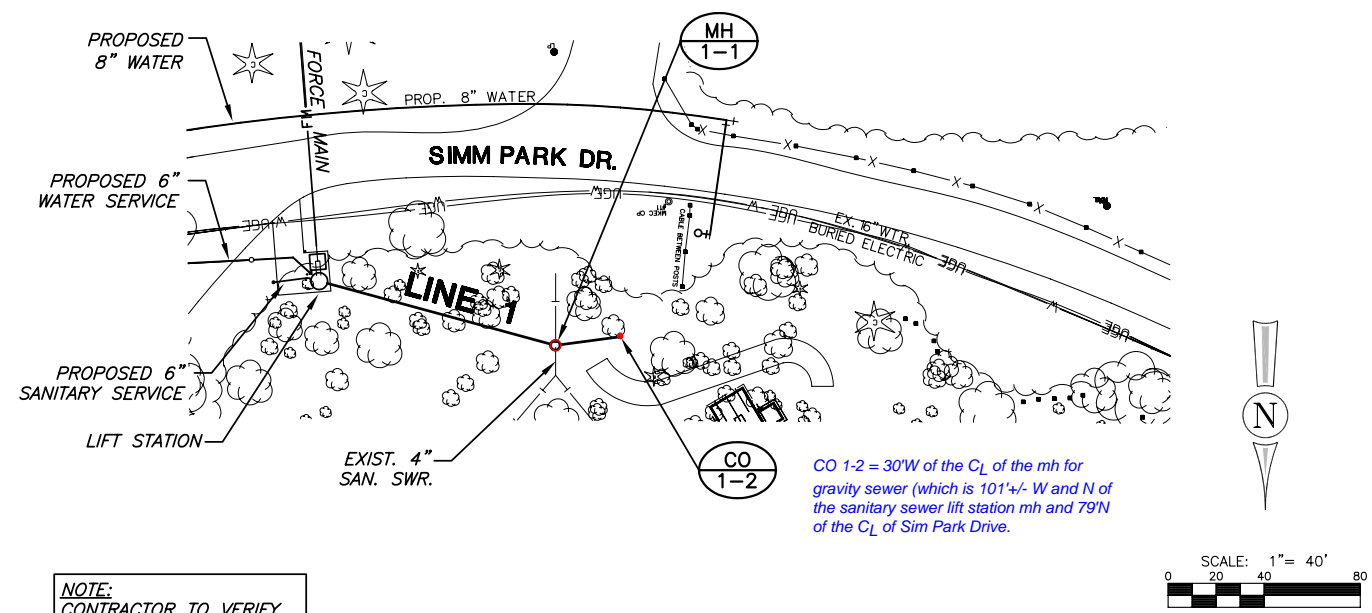

NOTE:
CONTRACTOR TO VERIFY
DEPTH AND LOCATION OF
EXISTING UTILITIES PRIOR
TO CONSTRUCTION.

PLAN LINE 1

