



SANITARY SEWER LATERAL
SUMMIT CROSSING ADDITION

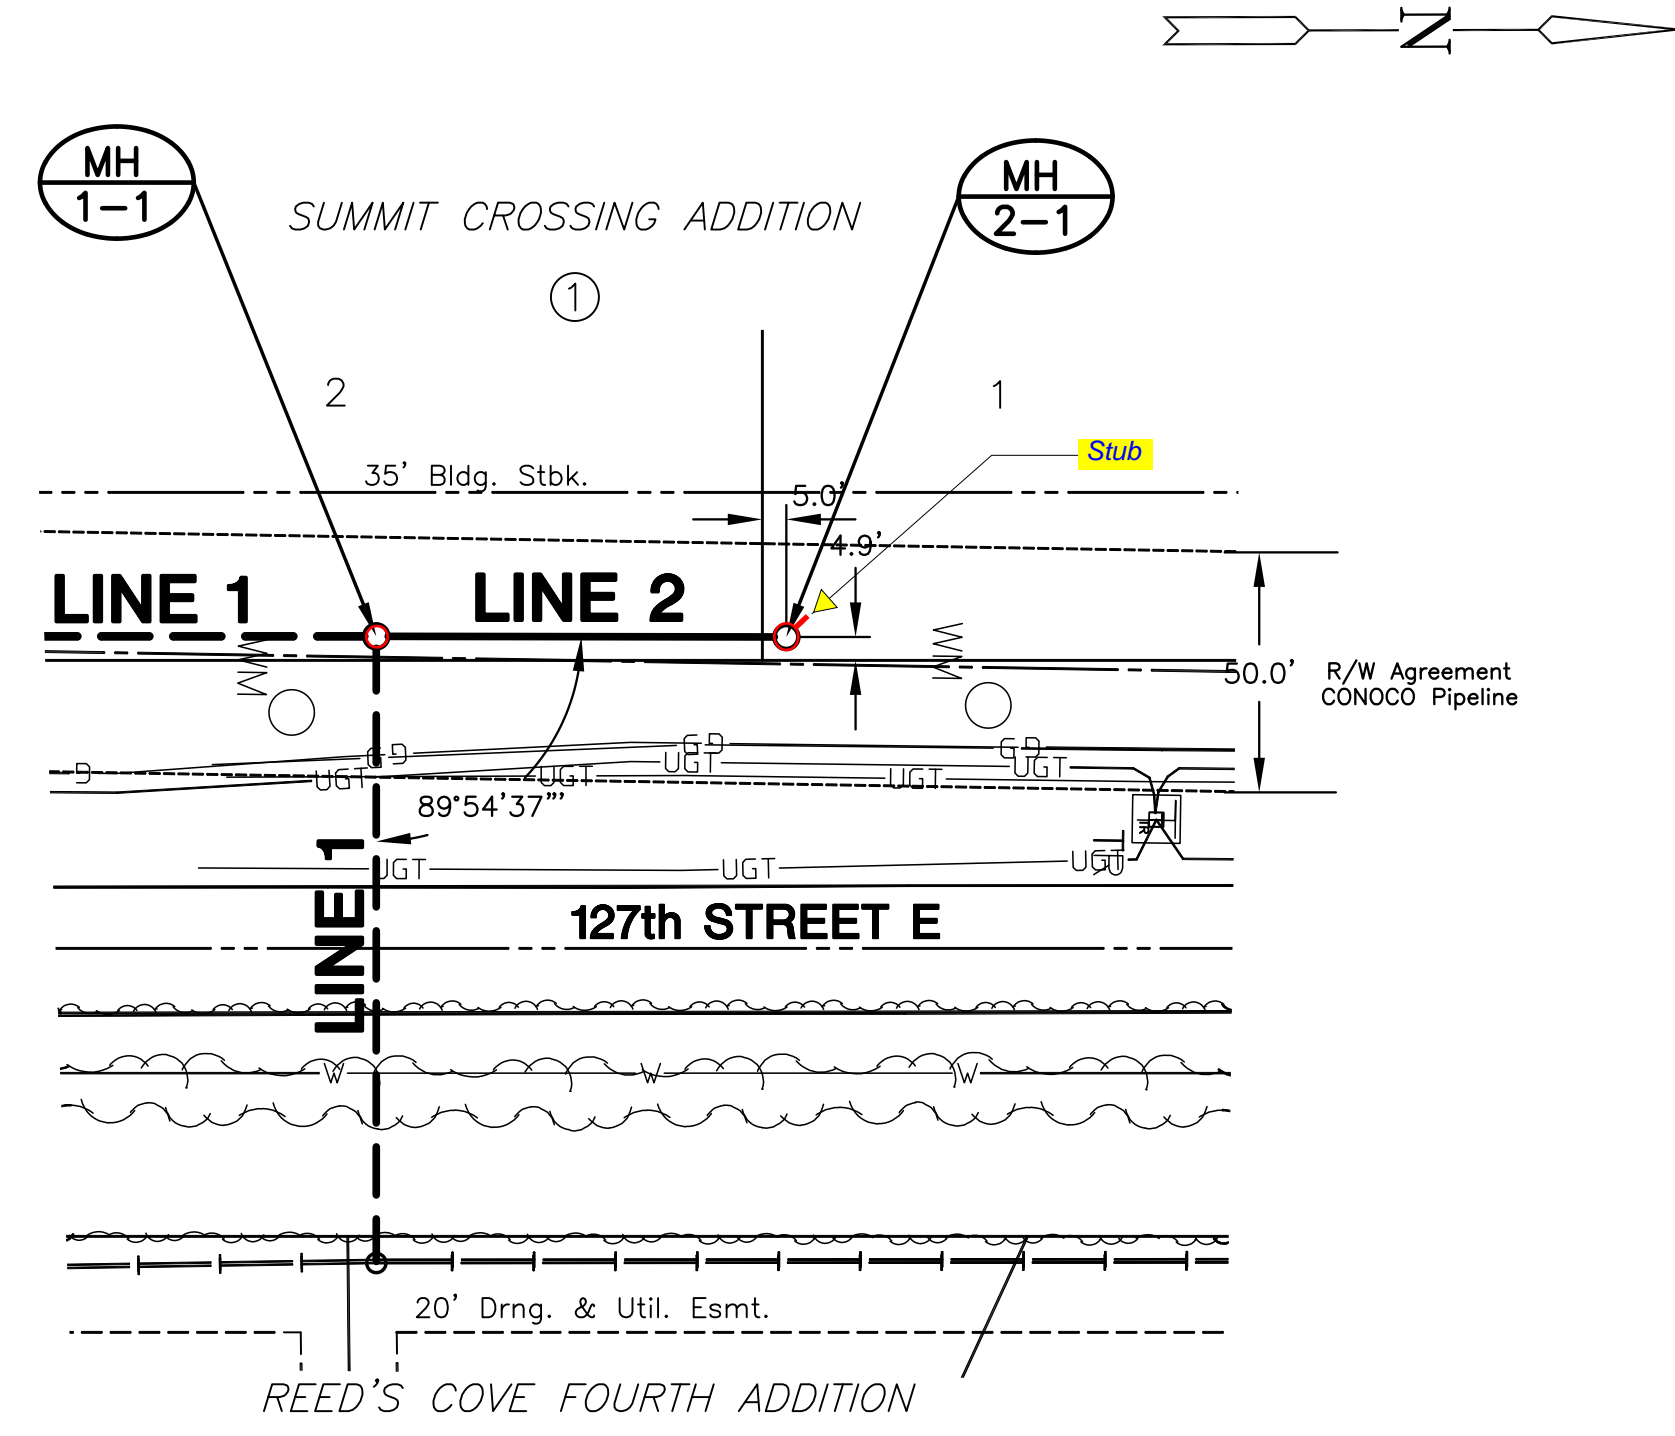

PLAN LINE 2

PROFILE LINE 2

SCALE: HORIZ. 1"=40'
SCALE: VERT. 1"=5'

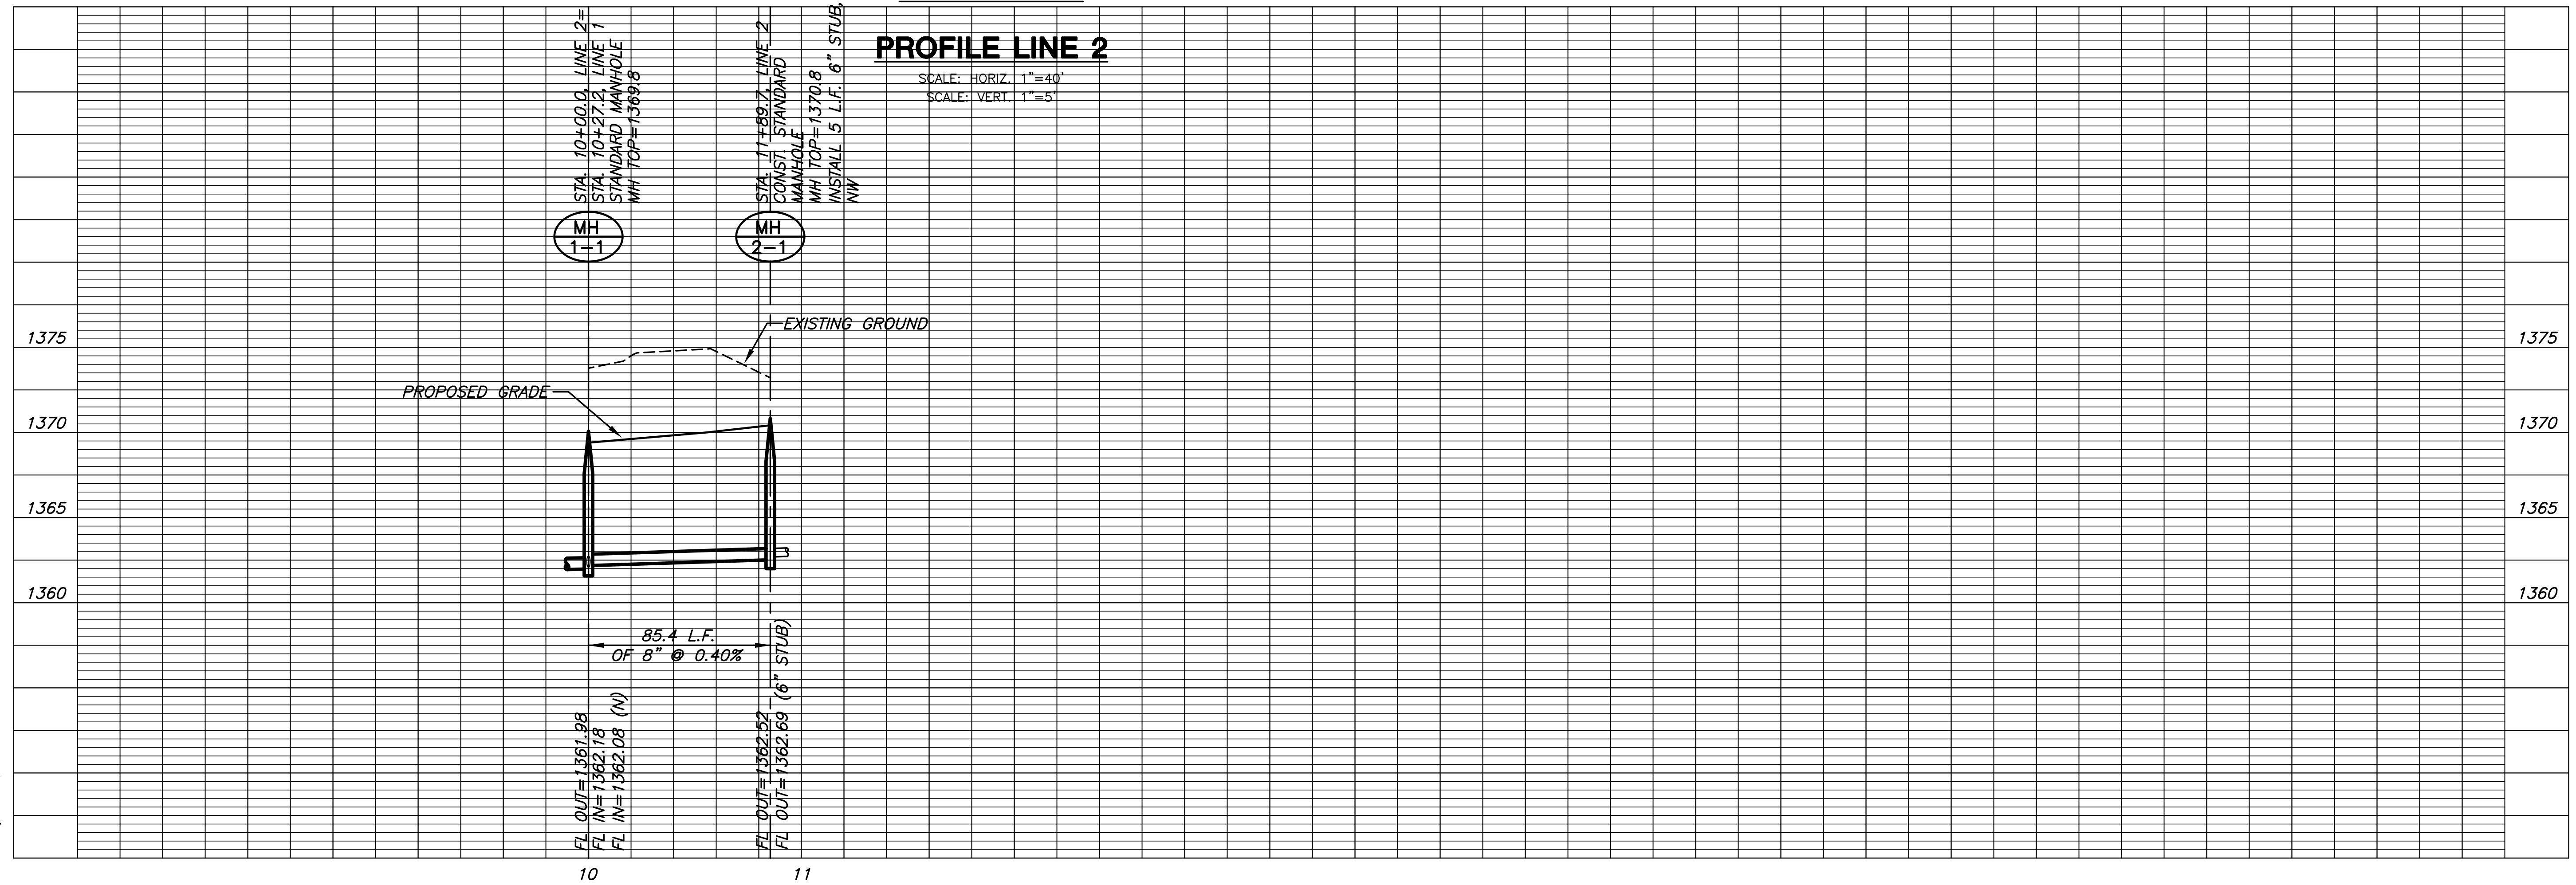

LINE 2
SHEET TITLE
468-84579
PROJECT NUMBER

DESIGN BY **DFL**
DRAWN BY **KKL**
CHECKED BY **GJA**

ISSUED **March 2010**
REVISED

SHEET NO.
6 of 13