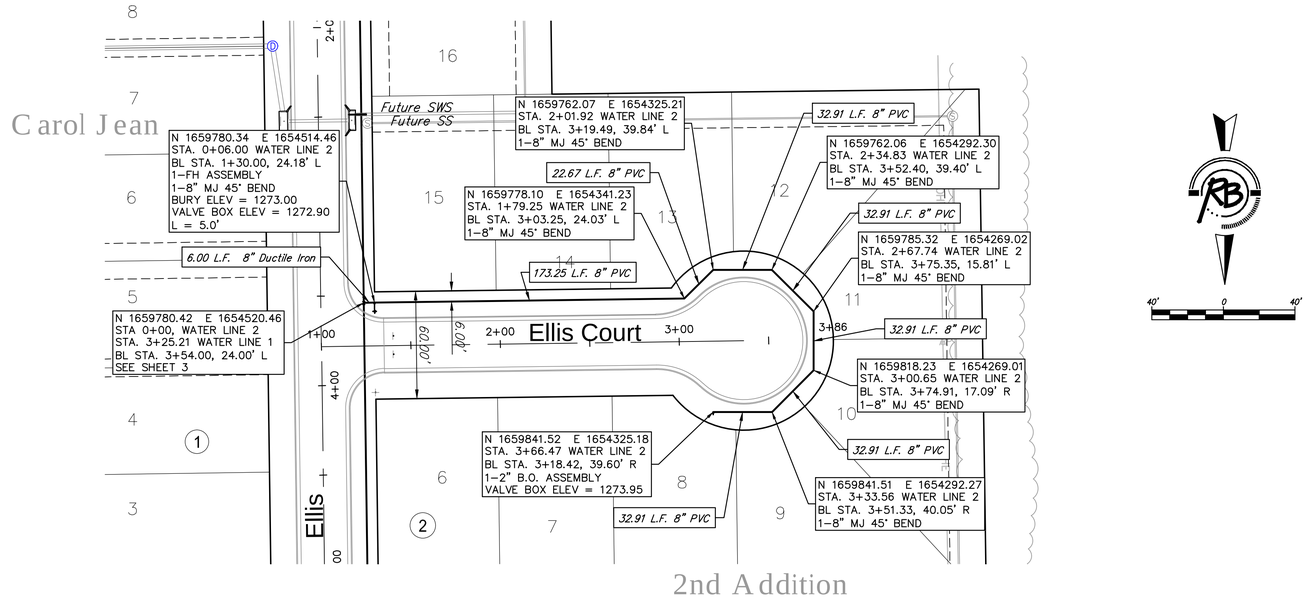

AS-BUILT 4/25/11

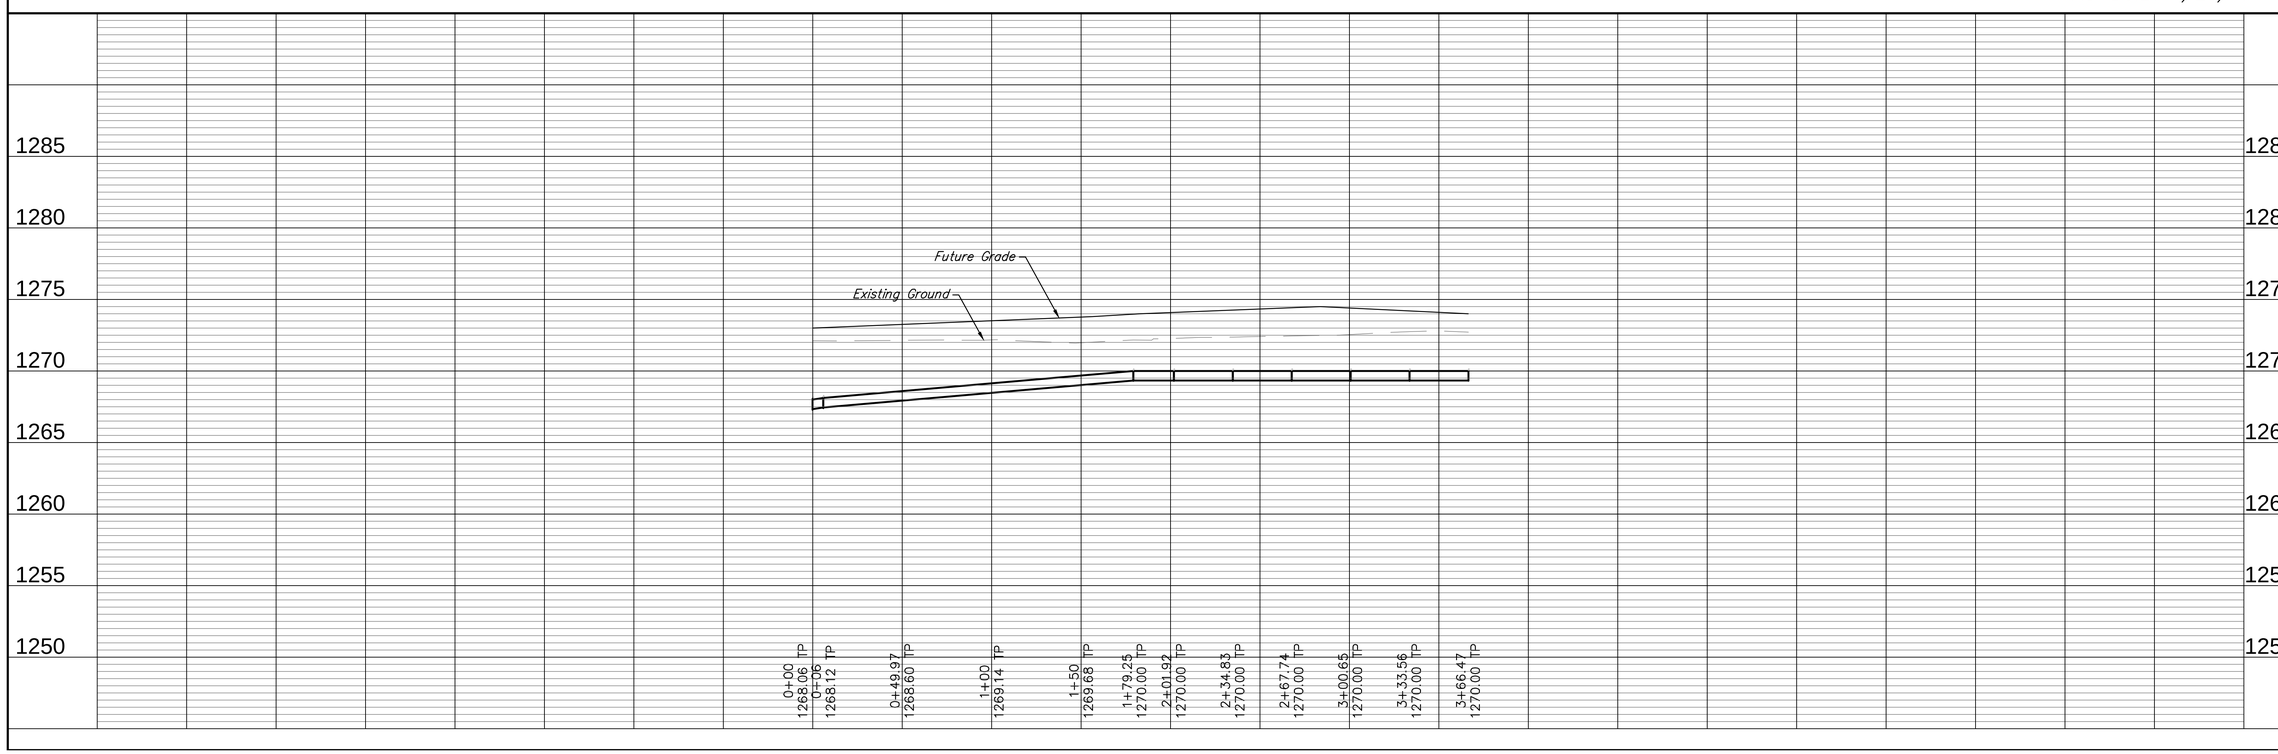

Ruggles & Bohm, P.A.
Engineering, Surveying, Land Planning
924 North Main
Wichita, Kansas 67203
www.rbkansas.com
(316) 264-8008
(316) 264-6421 fax
E-mail: info@rbkansas.com

DESIGN	DRAWN	REVISED
EJG	EJG	
UTILITY	DATE	REVIEW
	Dec. 20, 2010	

PROJECT NUMBER 1567PPP

DRAWING FILE Habitat South Village Ph2 Engg Base 2 [Water]

Water Distribution System
Water Line 02
WICHITA, KANSAS

RB JOB 3714E

SHEET 4 OF 11